


D-2
Vann og Arlop

- 2 OKT 2013

nr 12/13/49
22/80 22/26

Saksid. 08/222-16

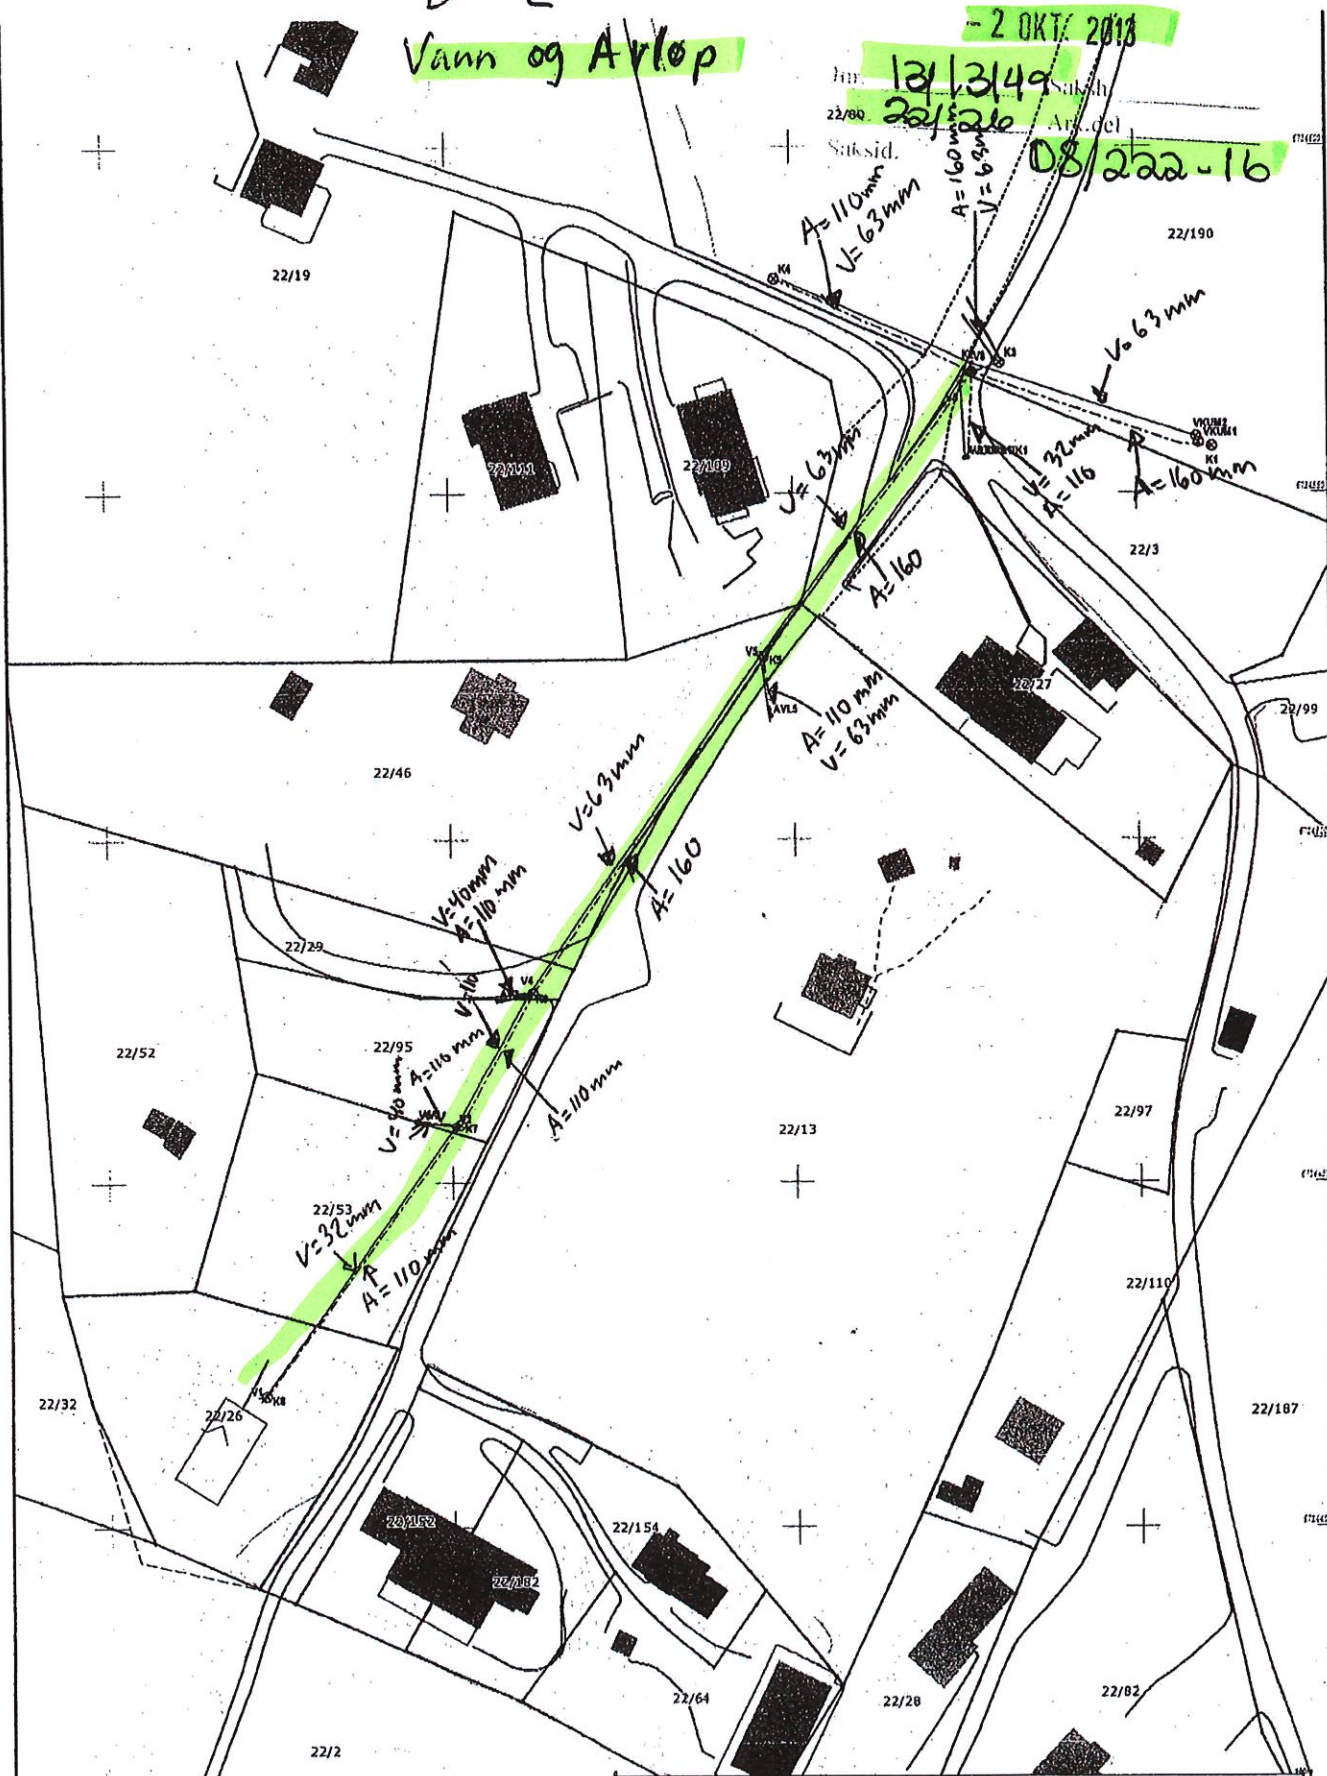

Torje Fløysand.

	Dato: 22.10.13 EBL	Meland gar 22 inn VA	

D-1

MELAND KOMMUNE

- 2 OKT. 2013

Int. 13/13/49^{2/80} Saksh. _____
Ark. 22/210 Ark.del _____
Saksid. 08/ 222-16

6714600

22/190

22/19

22/111

22/109

22/3

22/99

6714500

22/46
= Ny veg +
avkjørsel

22/49

22/52

22/95

22/13

22/97

22/53

22/110

22/187

22/32

22/26

100m

01.05.13

Knut Henningsen



Vest Oppmåling AS
5281 Valestrandsfossen
helge@vestoppmaaling.no



Dato: 2013.05.01
Slags: SUT

Meland gnr 22 bnr 95 inn vei

Målestokk
1:1000

Adresse: Hauge, 5281 Valestrandsfossen

Tlf: 905 12 583 Mobil: 905 12 583 Fax: 56392596