


# ETTER SYNFARING

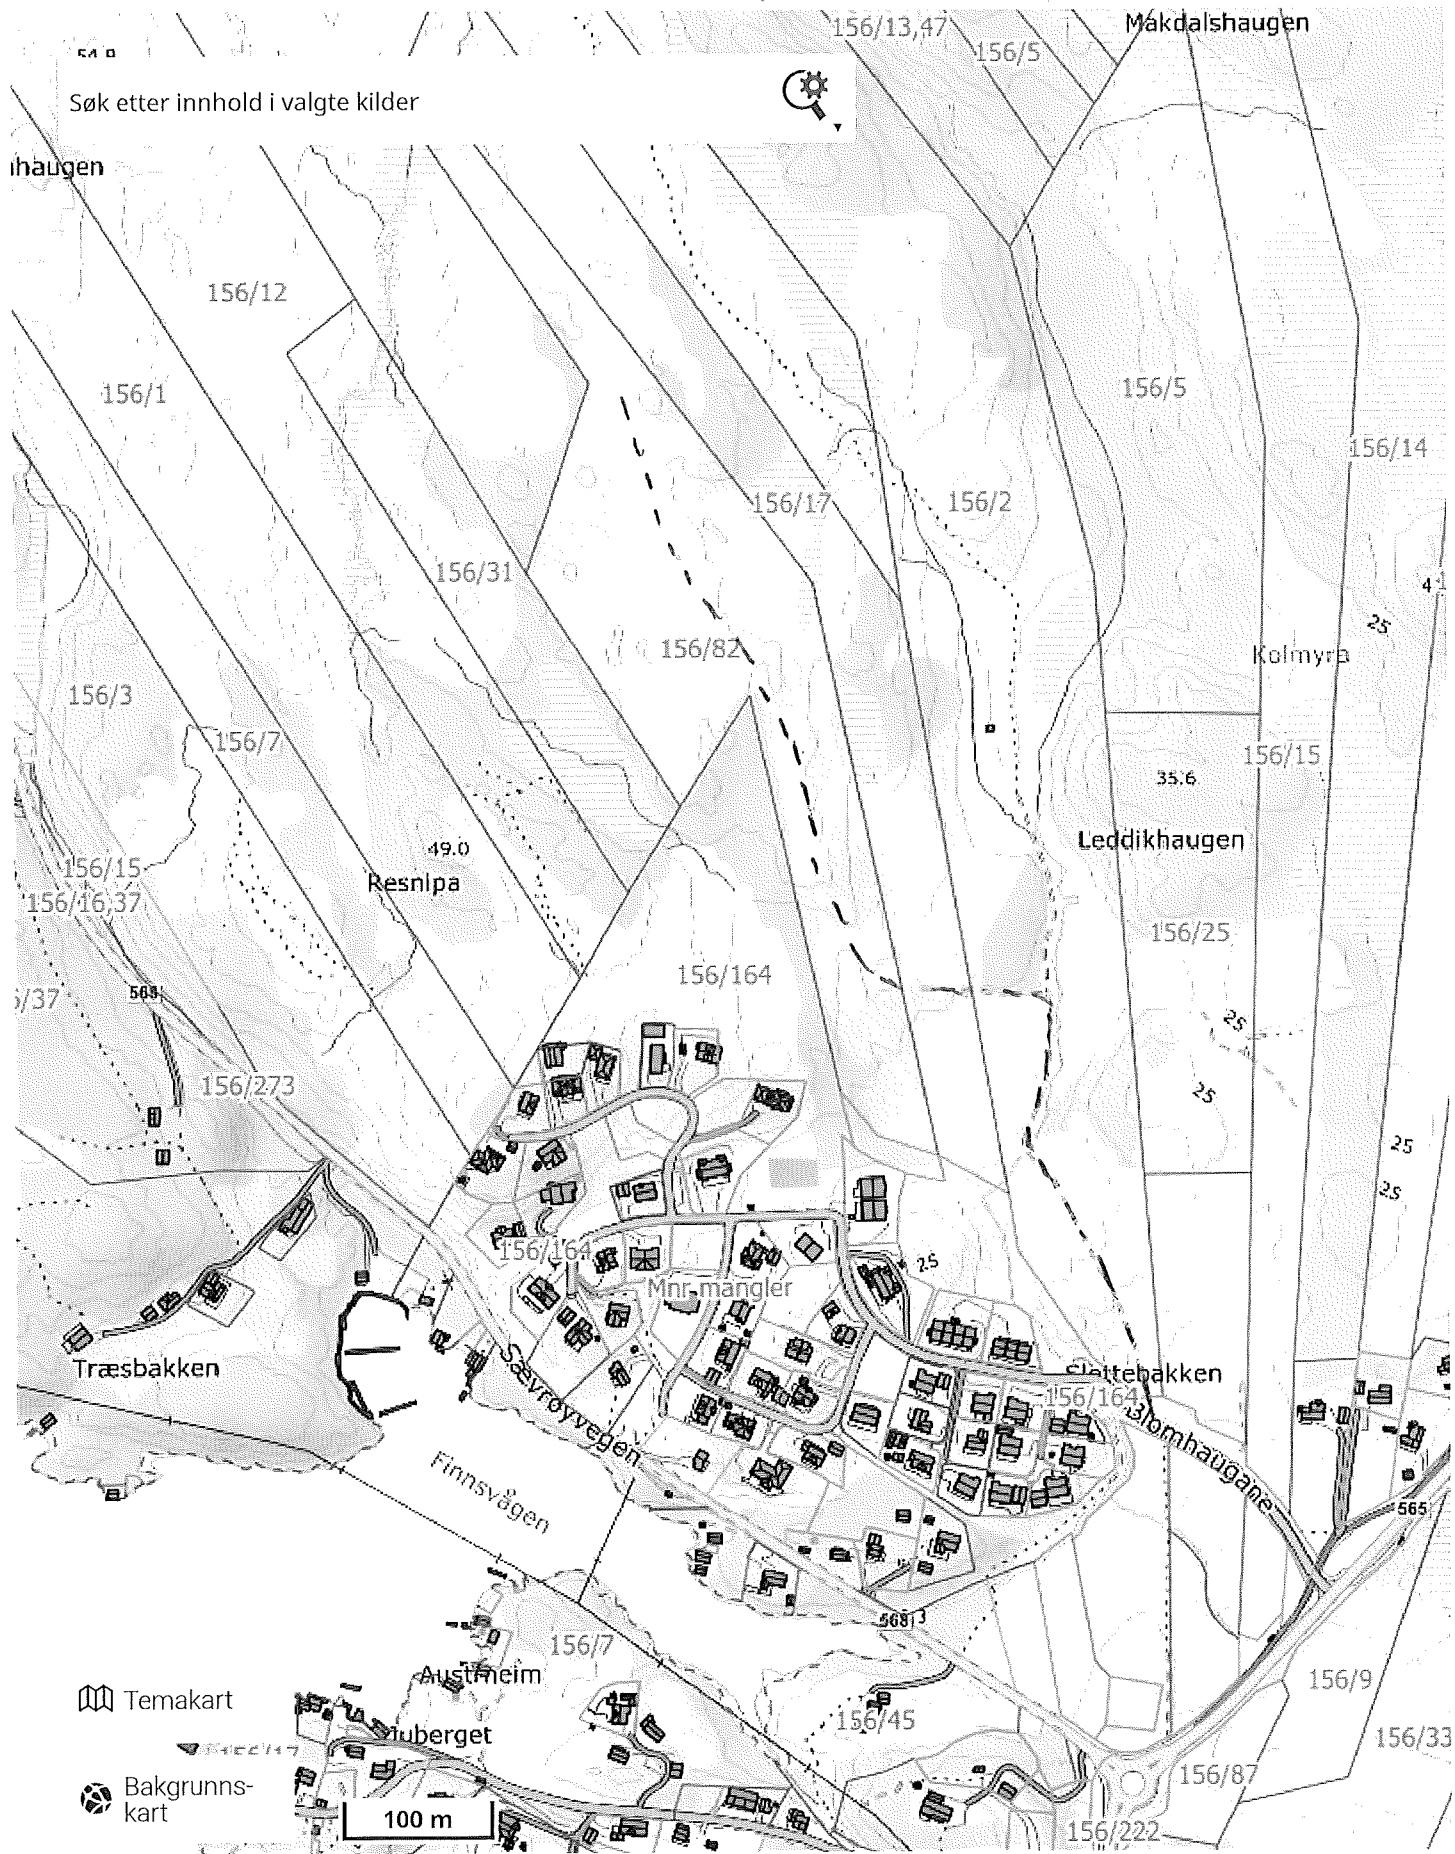

EPSG:32632 N: 6744017 Ø: 277701

Målestokk 1 : 5 000

Nils Kaalaas

