


D-1

357/66

N6724176, Ø280792 +

357/2

357/1

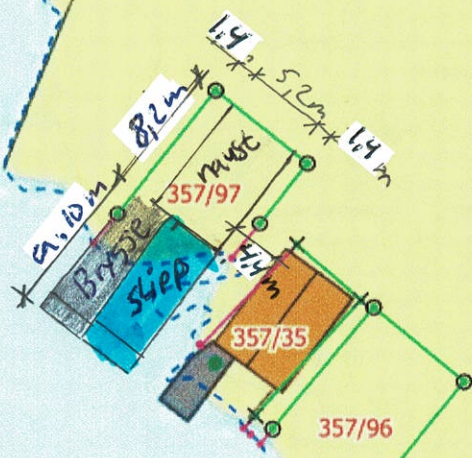

Situasjonskart - 357/97
Nytt naust

Dato: 07-05-2023



Målestokk: 1:500

