


15D  
137/772


15C

70

D-01

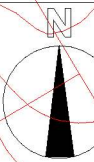

SITUASJONSPLAN  
GALTERÅSEN 02 - 137/808  
1:500 A4 - 10.05.2023

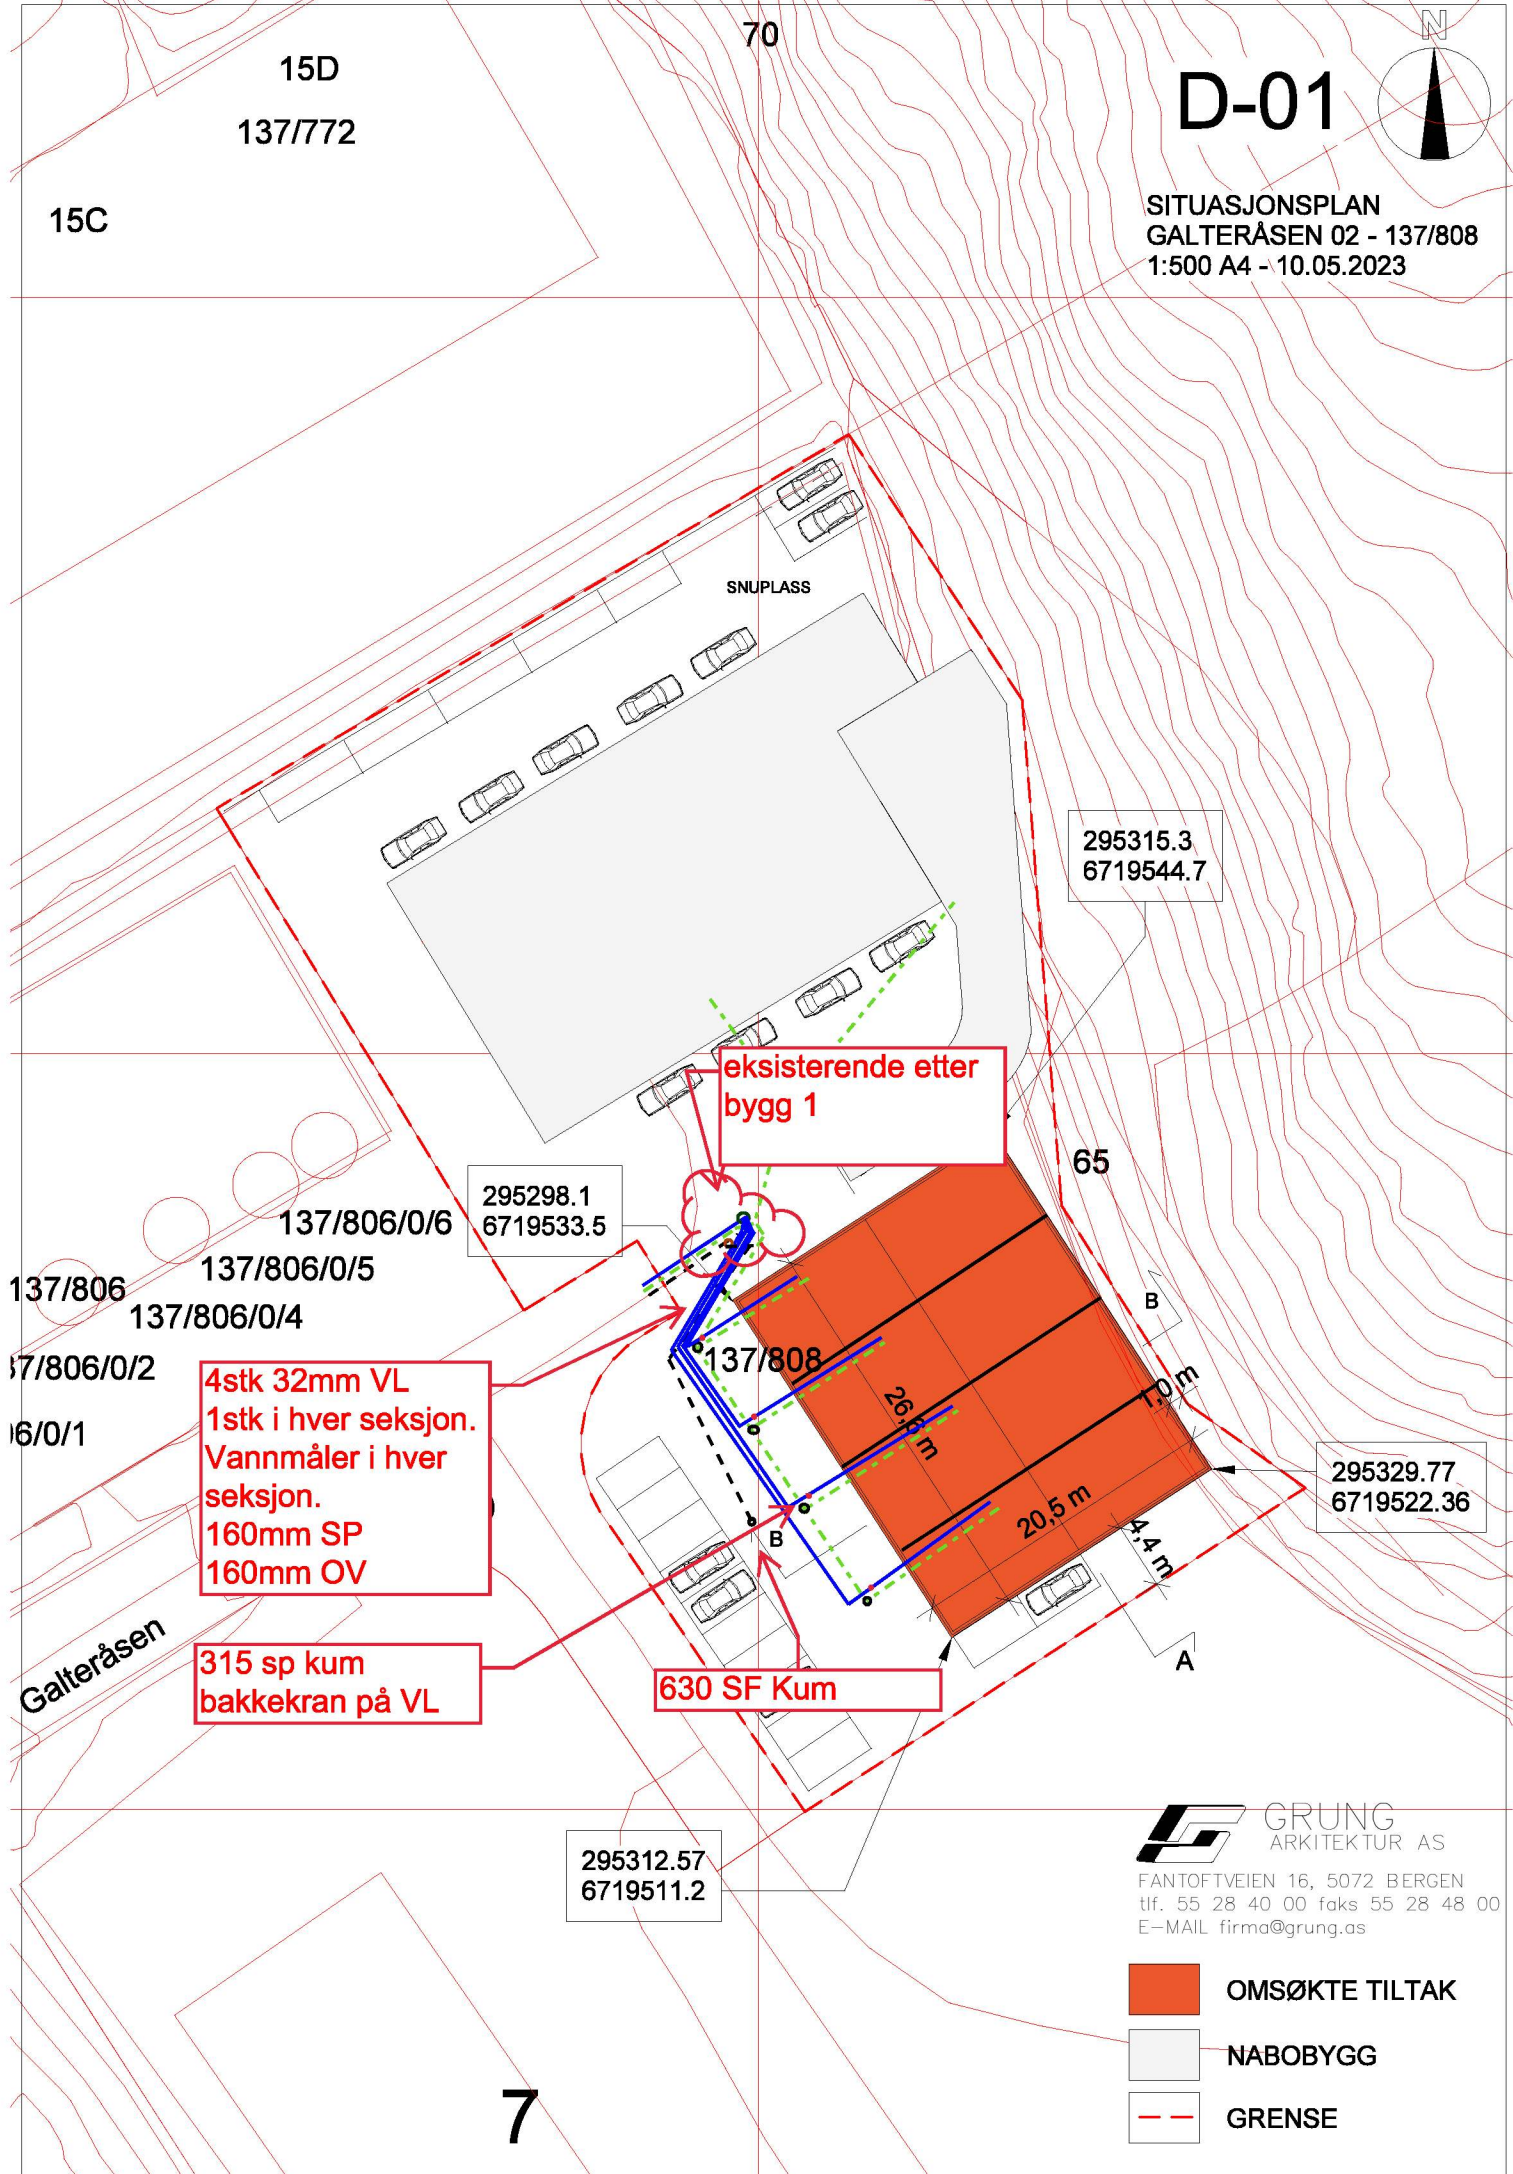

4stk 32mm VL  
1stk i hver seksjon.  
Vannmåler i hver  
seksjon.  
160mm SP  
160mm OV

315 sp kum  
bakkekran på VL

630 SF Kum

eksisterende etter  
bygg 1

Galteråsen


 

295312.57  
6719511.2

295315.3  
6719544.7

295329.77  
6719522.36

 GRUNG  
ARKITEKTUR AS

FANTOFTVEIEN 16, 5072 BERGEN  
tlf. 55 28 40 00 faks 55 28 48 00  
E-MAIL firma@grung.as

-  OMSØKTE TILTAK
-  NABOBYGG
-  GRENSE