


(1)

1. ETV.

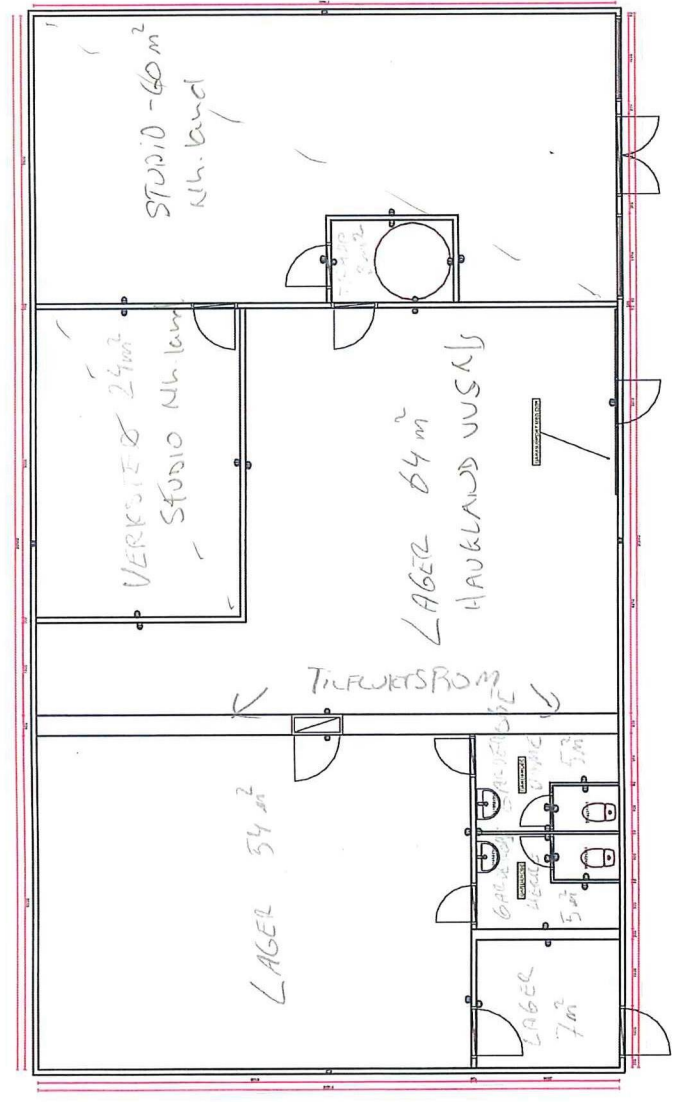


GBNR 188/399

KVASSVESVEIEN 17

Skala: 1:100 (A3)

(E2)

2. ETV.

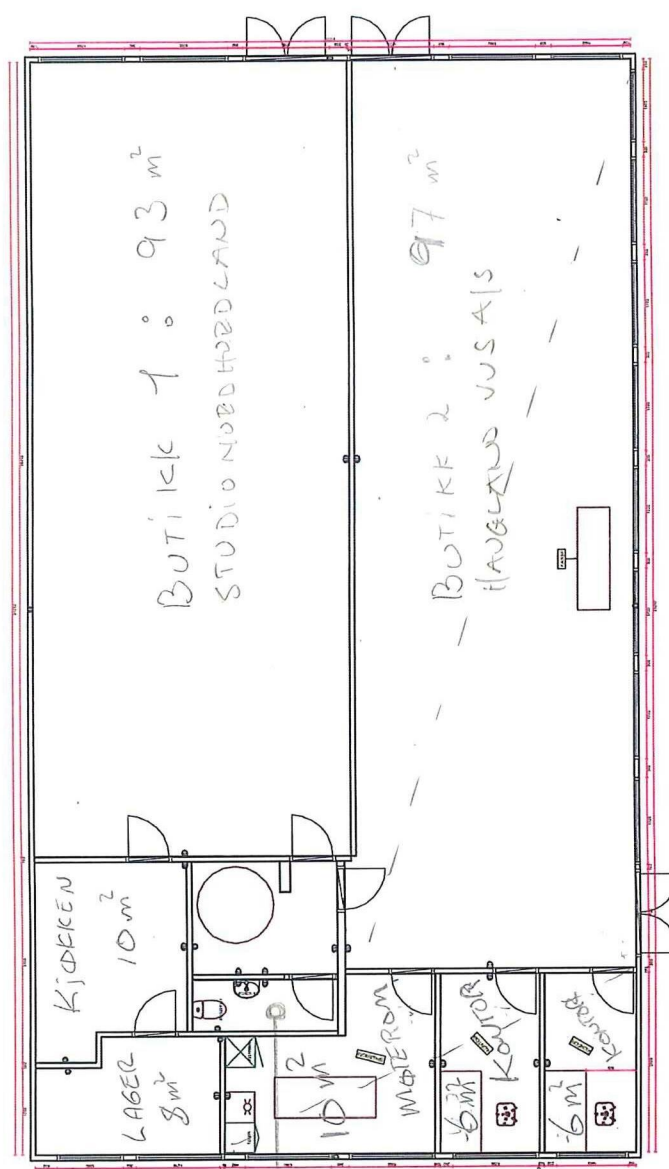

GBNR. 188/399

Skala: 1:100 (A3)

KUASSUESUELEN 17