


Målestokk: 1:350
Dato: 05-06-2023
9m

Nhdigi.no

Situasjonskart -
309/28
2 mannsbolig nr 2 - Mjuebakane

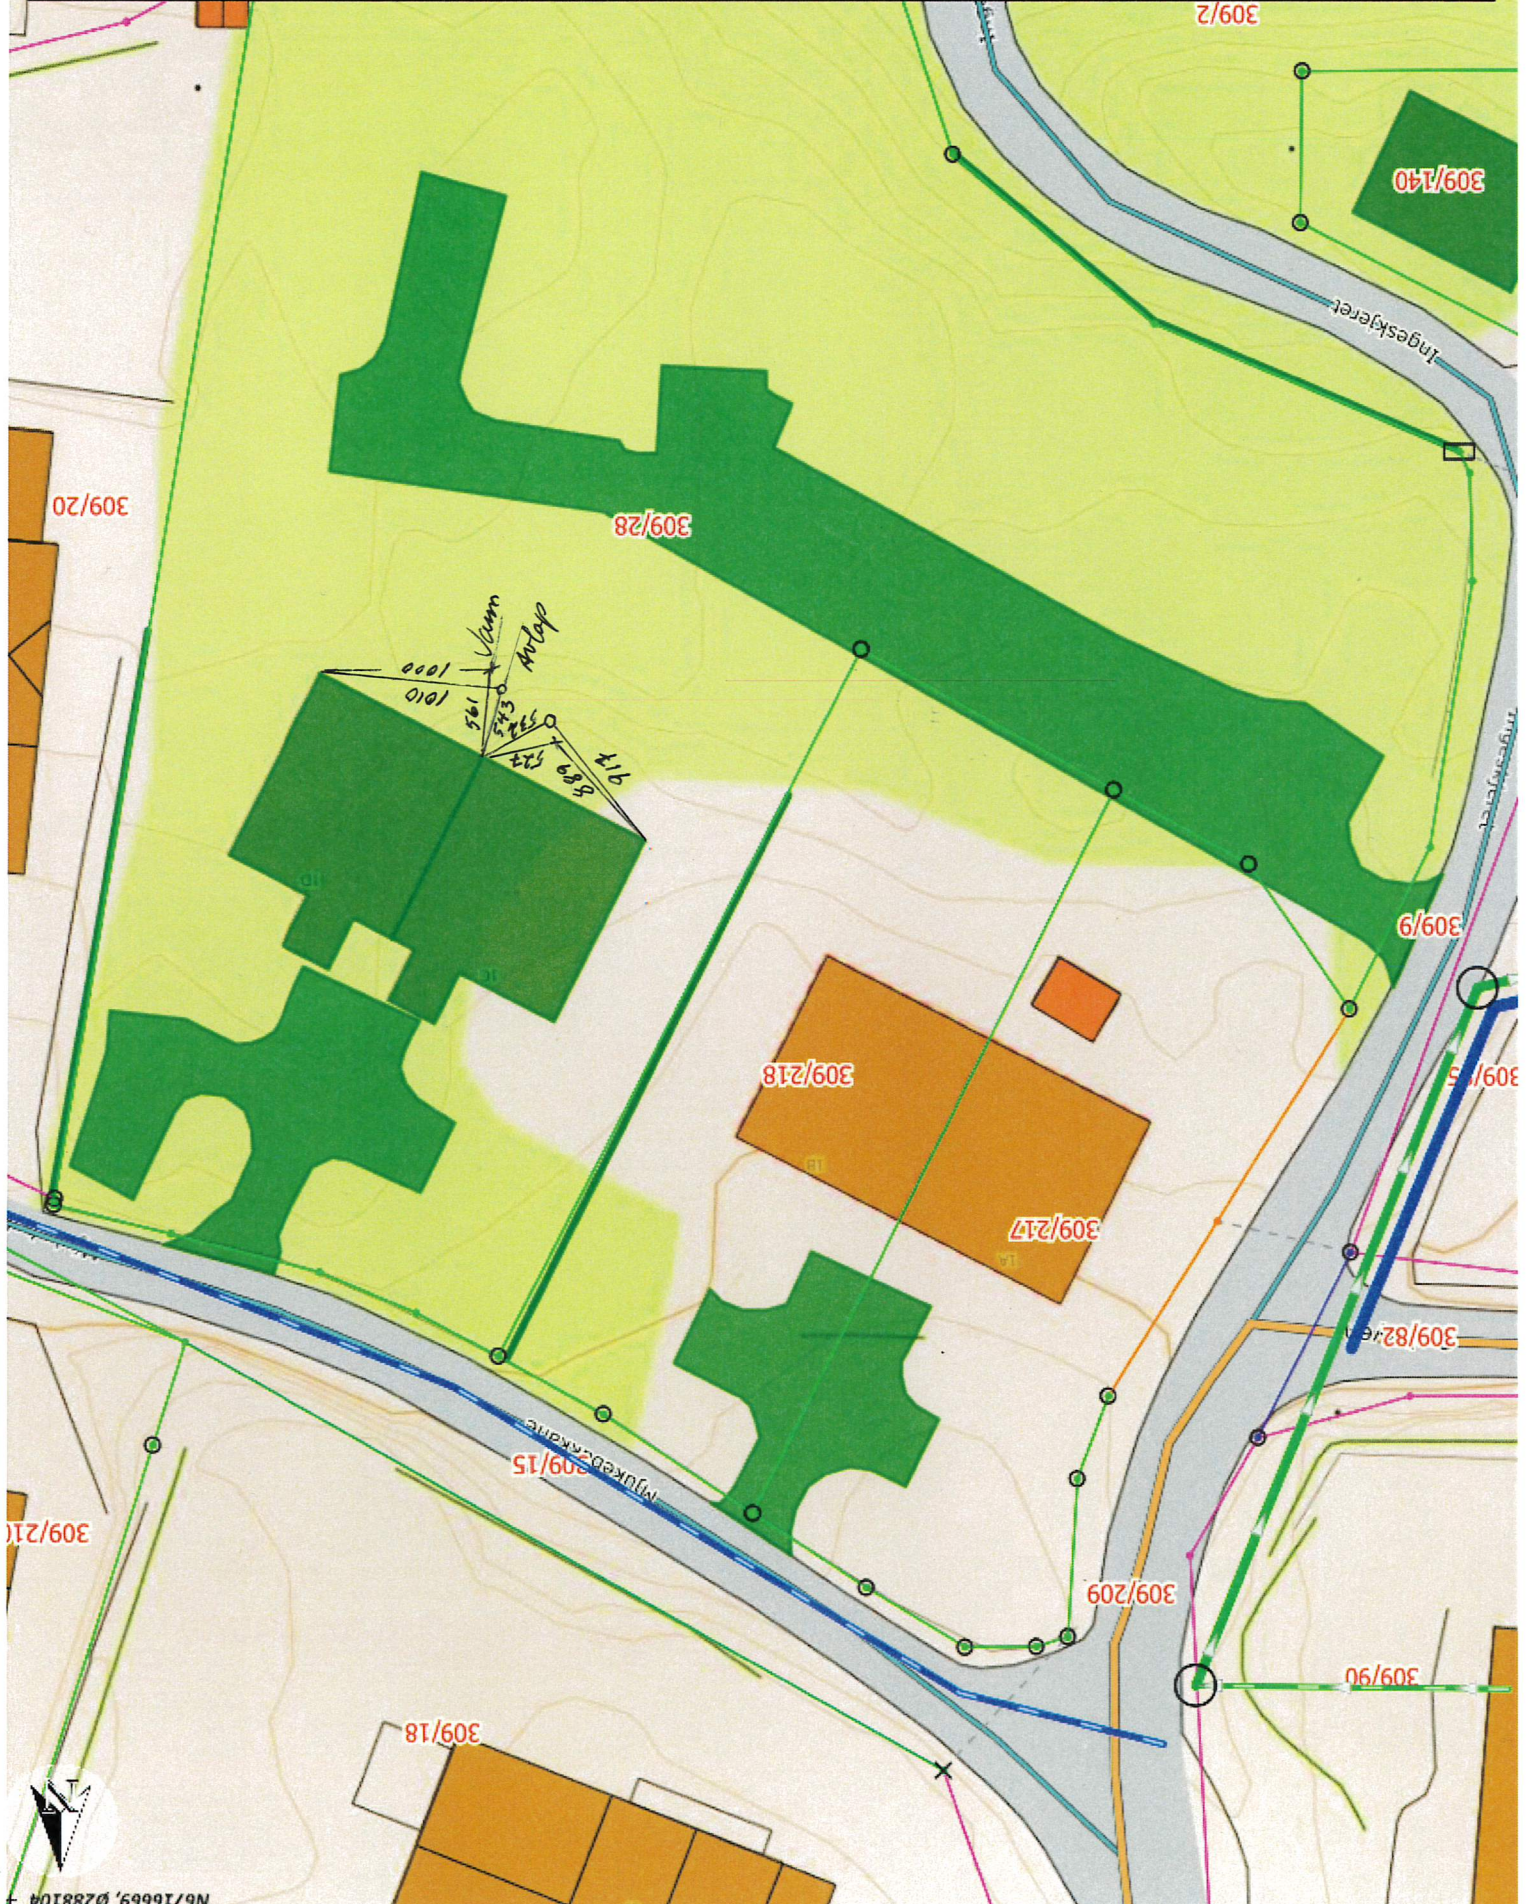

Ingeskjeret

Mjuebakane

Vann
Mrlap
1000
1010
561
543
525
523
889
917
1117

309/28

309/218

309/217

309/9

309/5

309/82

309/209

309/90

309/18