


Tegning til sommerhytte på Gnr 58 bnr 42 Bjørnens avlygren Indre Lindås kommune


LINDÅS KOMMUNE
KOMMUNE-
INGENIØRKONTORET
00177 1. 5. 68
Arkiv nr. 58-42

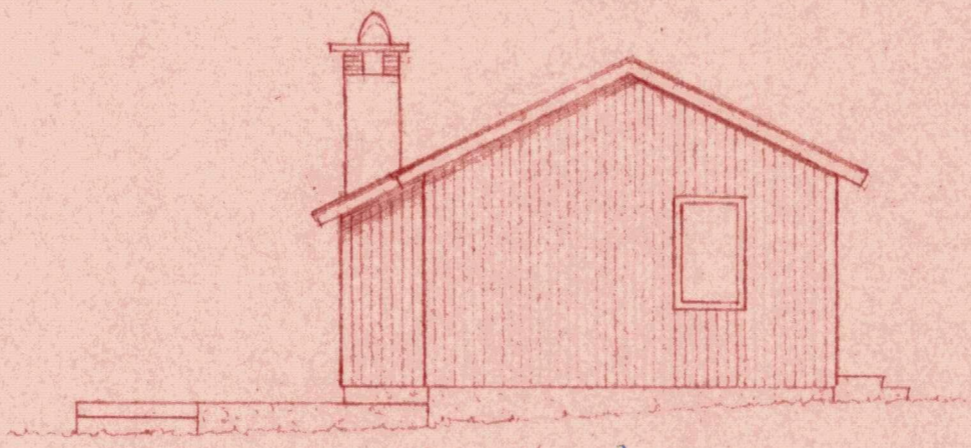


mot vest




mot syd

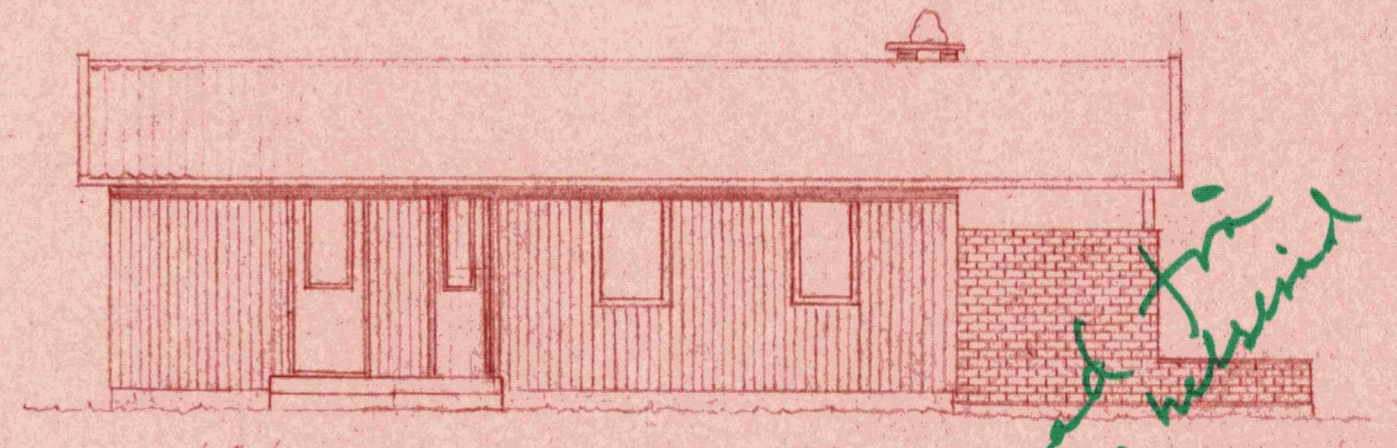

mot øst

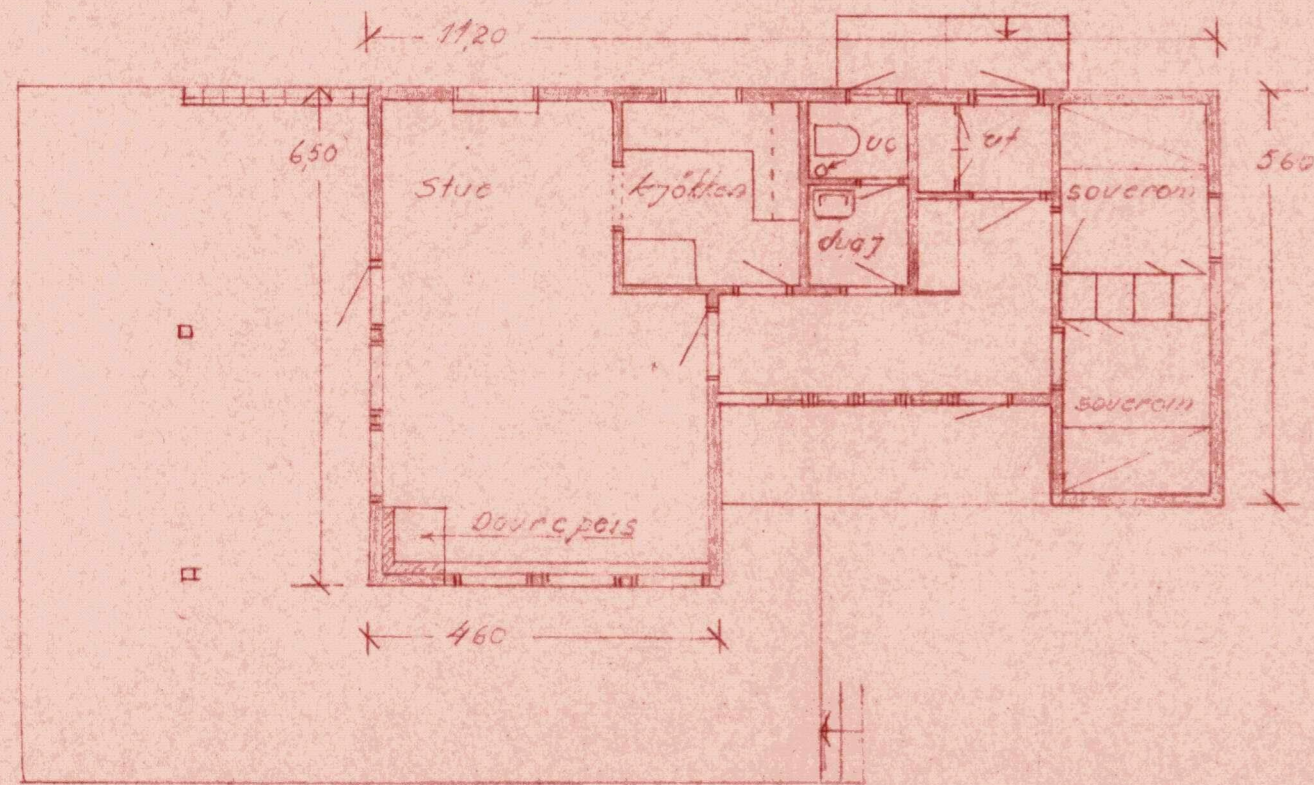


mot nord

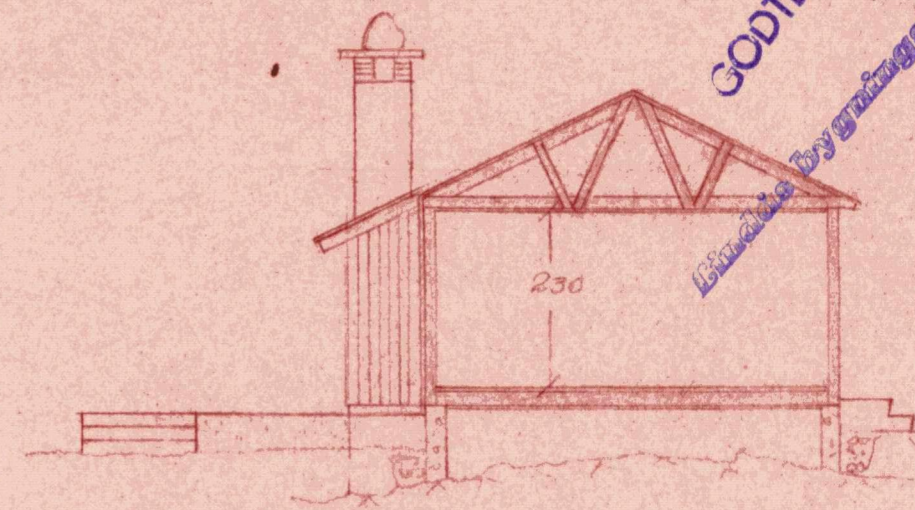

Sektion A-A

GODTEKE
Lindås byggesak den 18. 10. 68
R. Sjyn
Lindås kommune
Indre Lindås

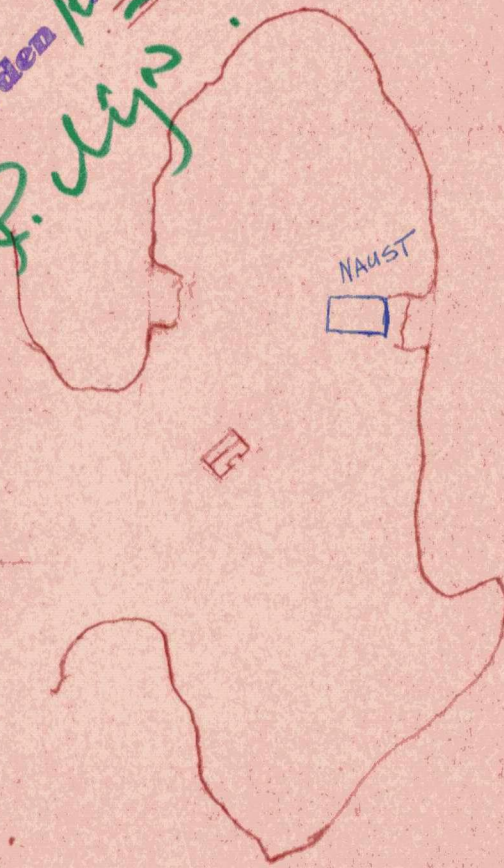

Situasjonsplan
Skala 1:500

Bergen den 3/5 1968
O. A. K. S. S.