


Borehull

Septiktank

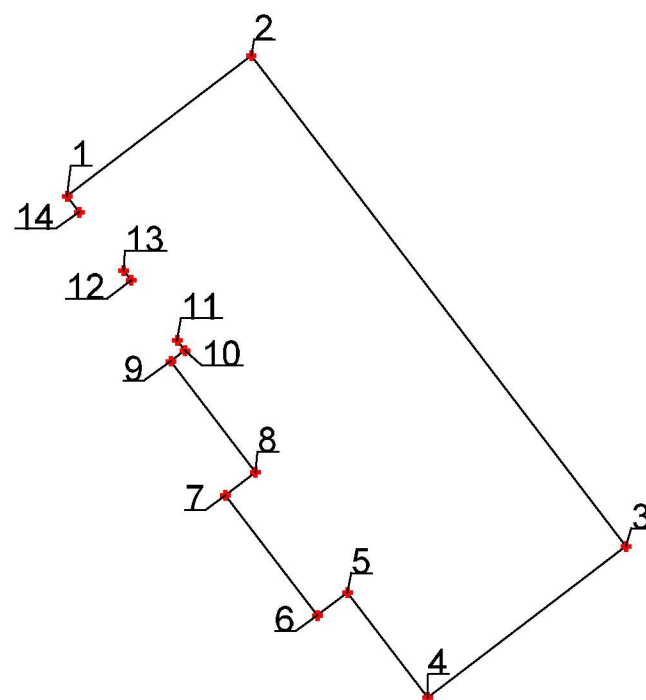

Koordinater topp grunnmur:

Id	Øst	Nord	Høyde
1	288220,247	6734235,879	43,7
2	288227,559	6734241,462	43,7
3	288242,426	6734221,988	43,7
4	288234,557	6734215,98	41,3
5	288231,371	6734220,153	41,3
6	288230,179	6734219,243	41,3
7	288226,538	6734224,012	41,3
8	288227,731	6734224,922	41,3
9	288224,363	6734229,334	41,3
10	288224,919	6734229,759	41,3
11	288224,616	6734230,156	41,3
12	288222,795	6734232,54	41,3
13	288222,492	6734232,938	41,3
14	288220,732	6734235,243	41,3

Borehull	288221,713	6734268,526	41,244
Septiktank	288189,842	6734229,866	35,984



**Alversund
Maskinstasjon A.S**

Dato 17.04.2023	Konstr./tegn MM	Godkjent	Målestokk 1:300	
ETRS89/UTM SONE 32N NN 2000 høyder				
Asbylt tegning Innmålt topp grunnmur Lurevegen 1447, 5912 Seim				Erstatning for: Erstattet av: 901
Henvisning:		Beregning:		Gnr/Bnr 58/177