

AVTALE OM GRENSE

Me er enige om dei i dag ~~attfunne~~ og nymerkte grensepunkta for hyttetomta, gbnr 341/43. Grensene for tomta vert definert av rette liner mellom punkta 1,2,3,4 i skissa nedanfor.

Skarpenes 22.06.2023




Gbnr 341/43



Gbnr 341/44



Gbnr 341/25

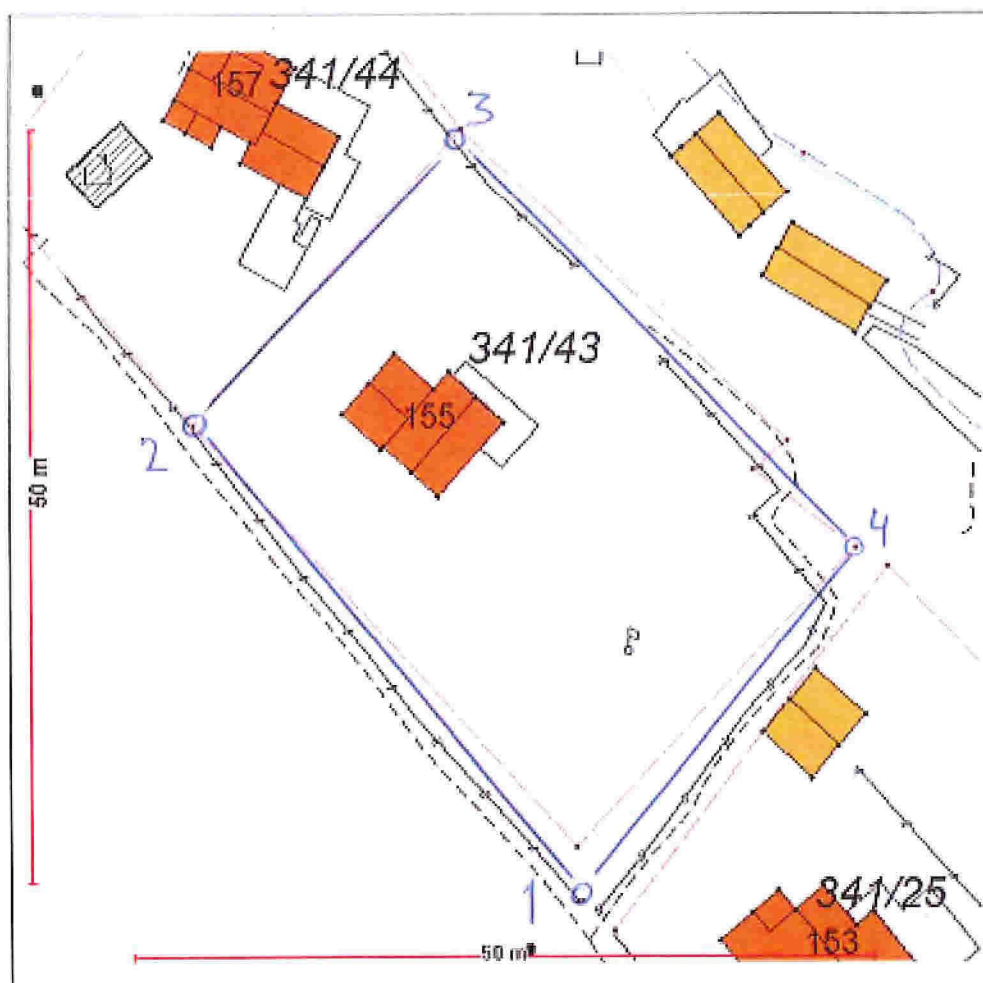

ALVER
KOMMUNE

13 JULI 2023