



2cm = 1m

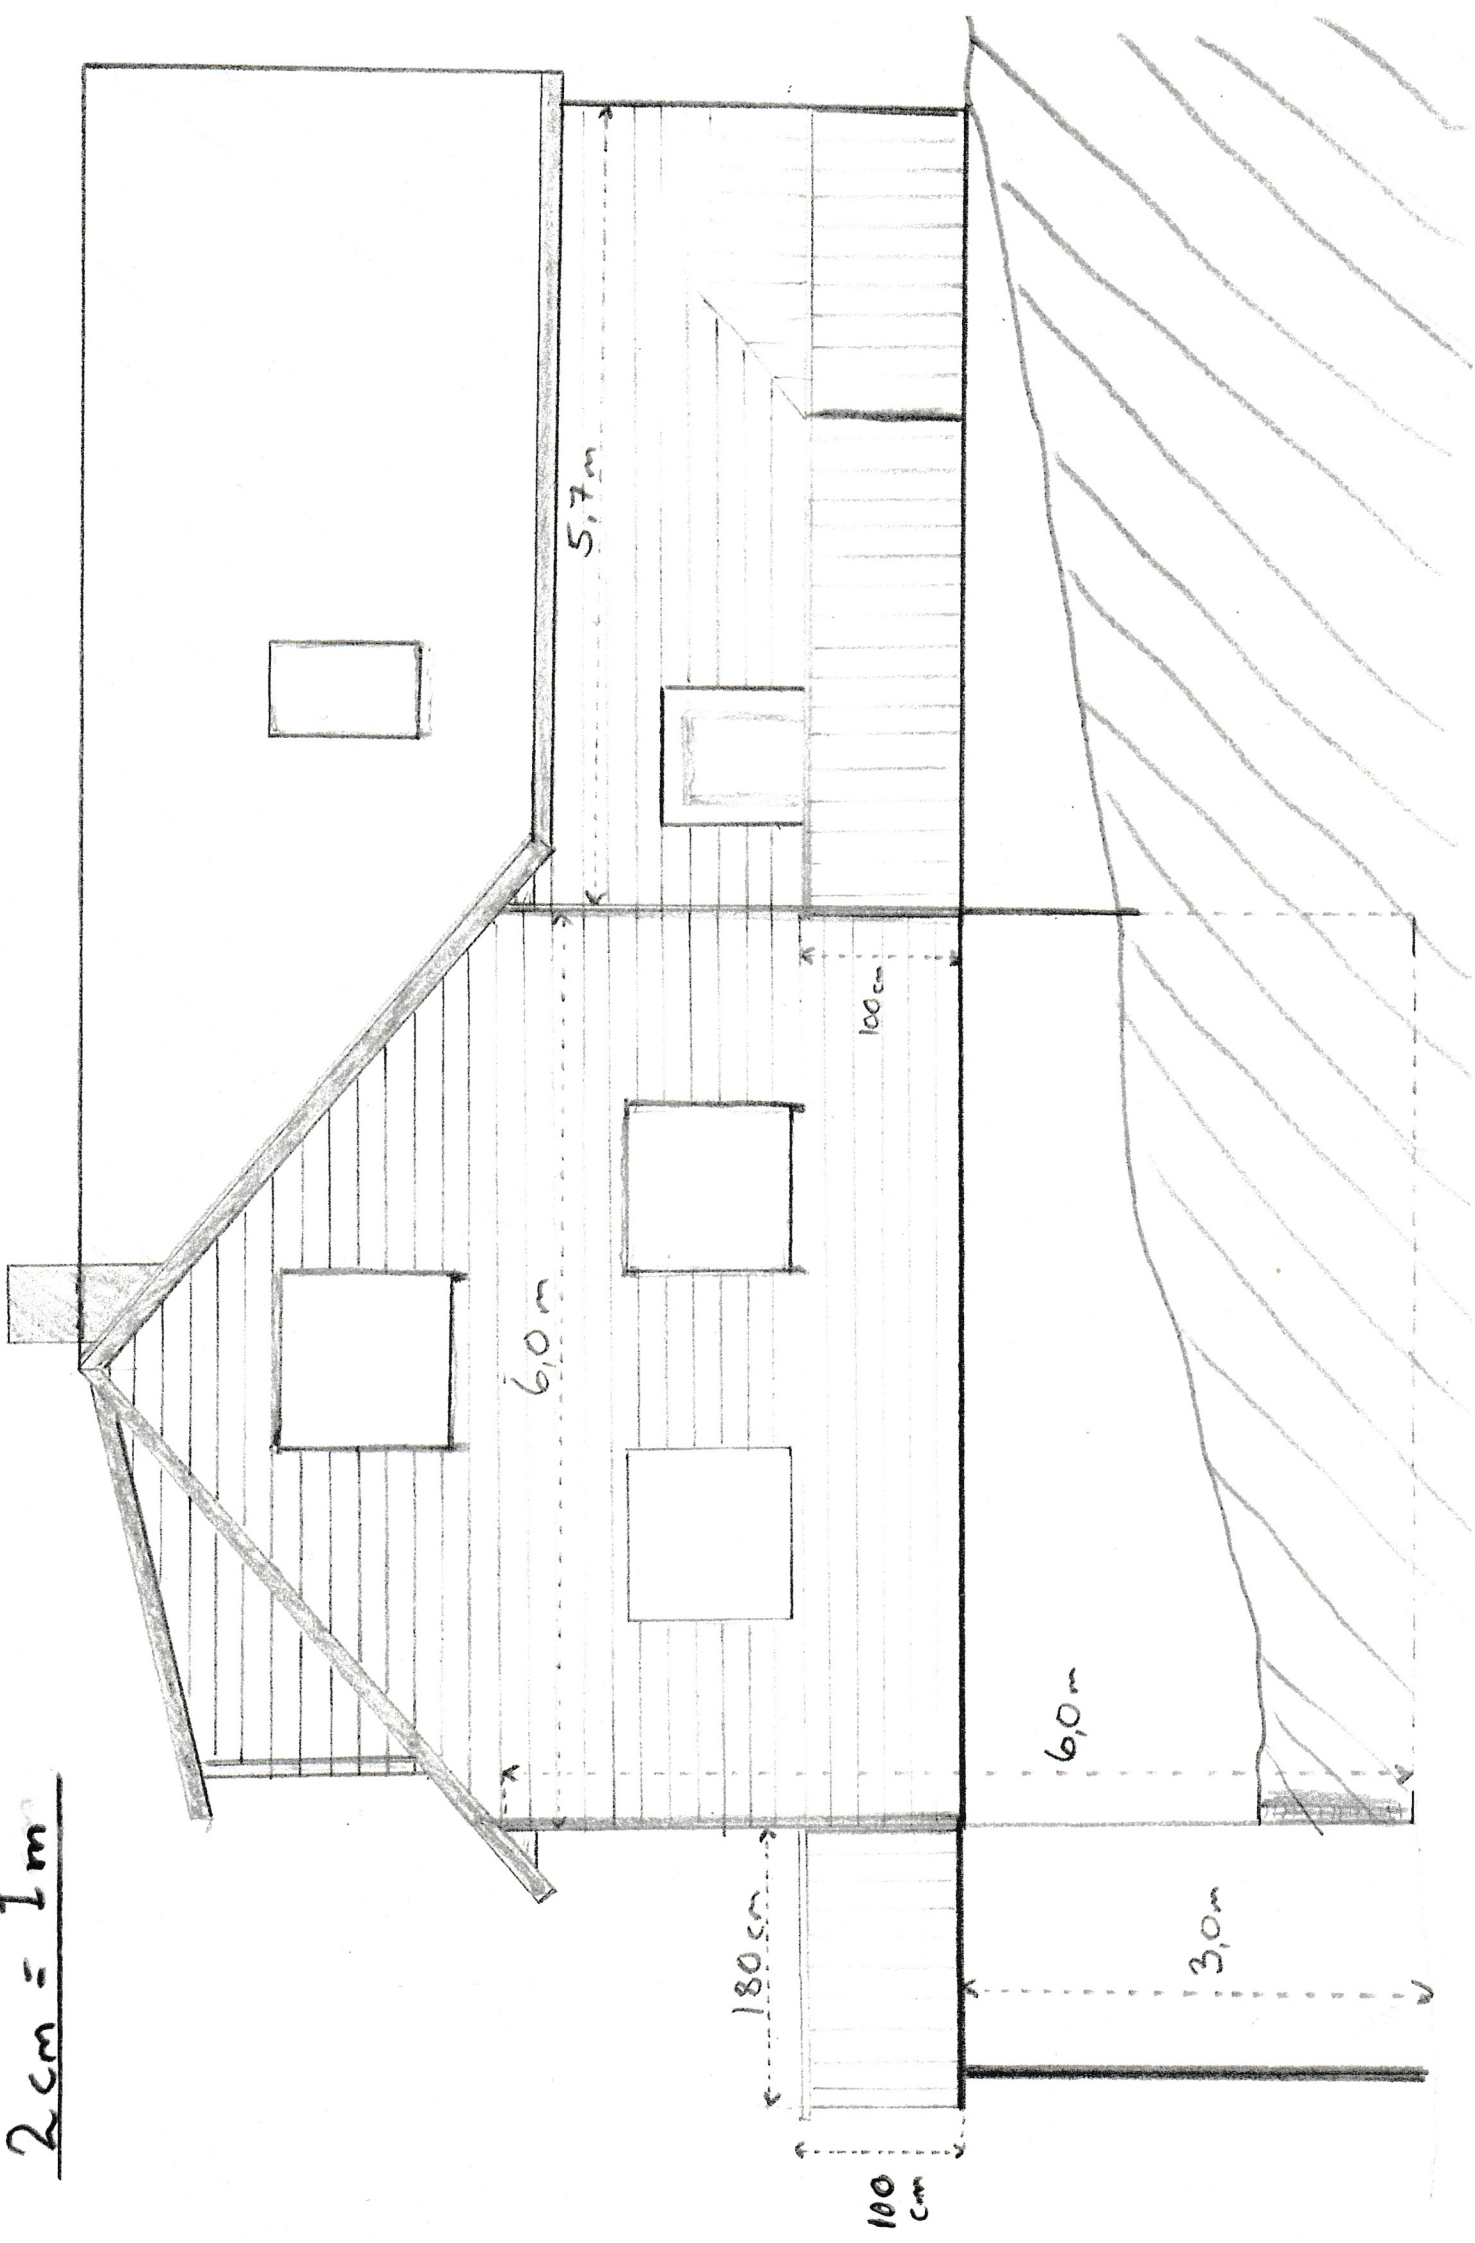


2cm = 1m

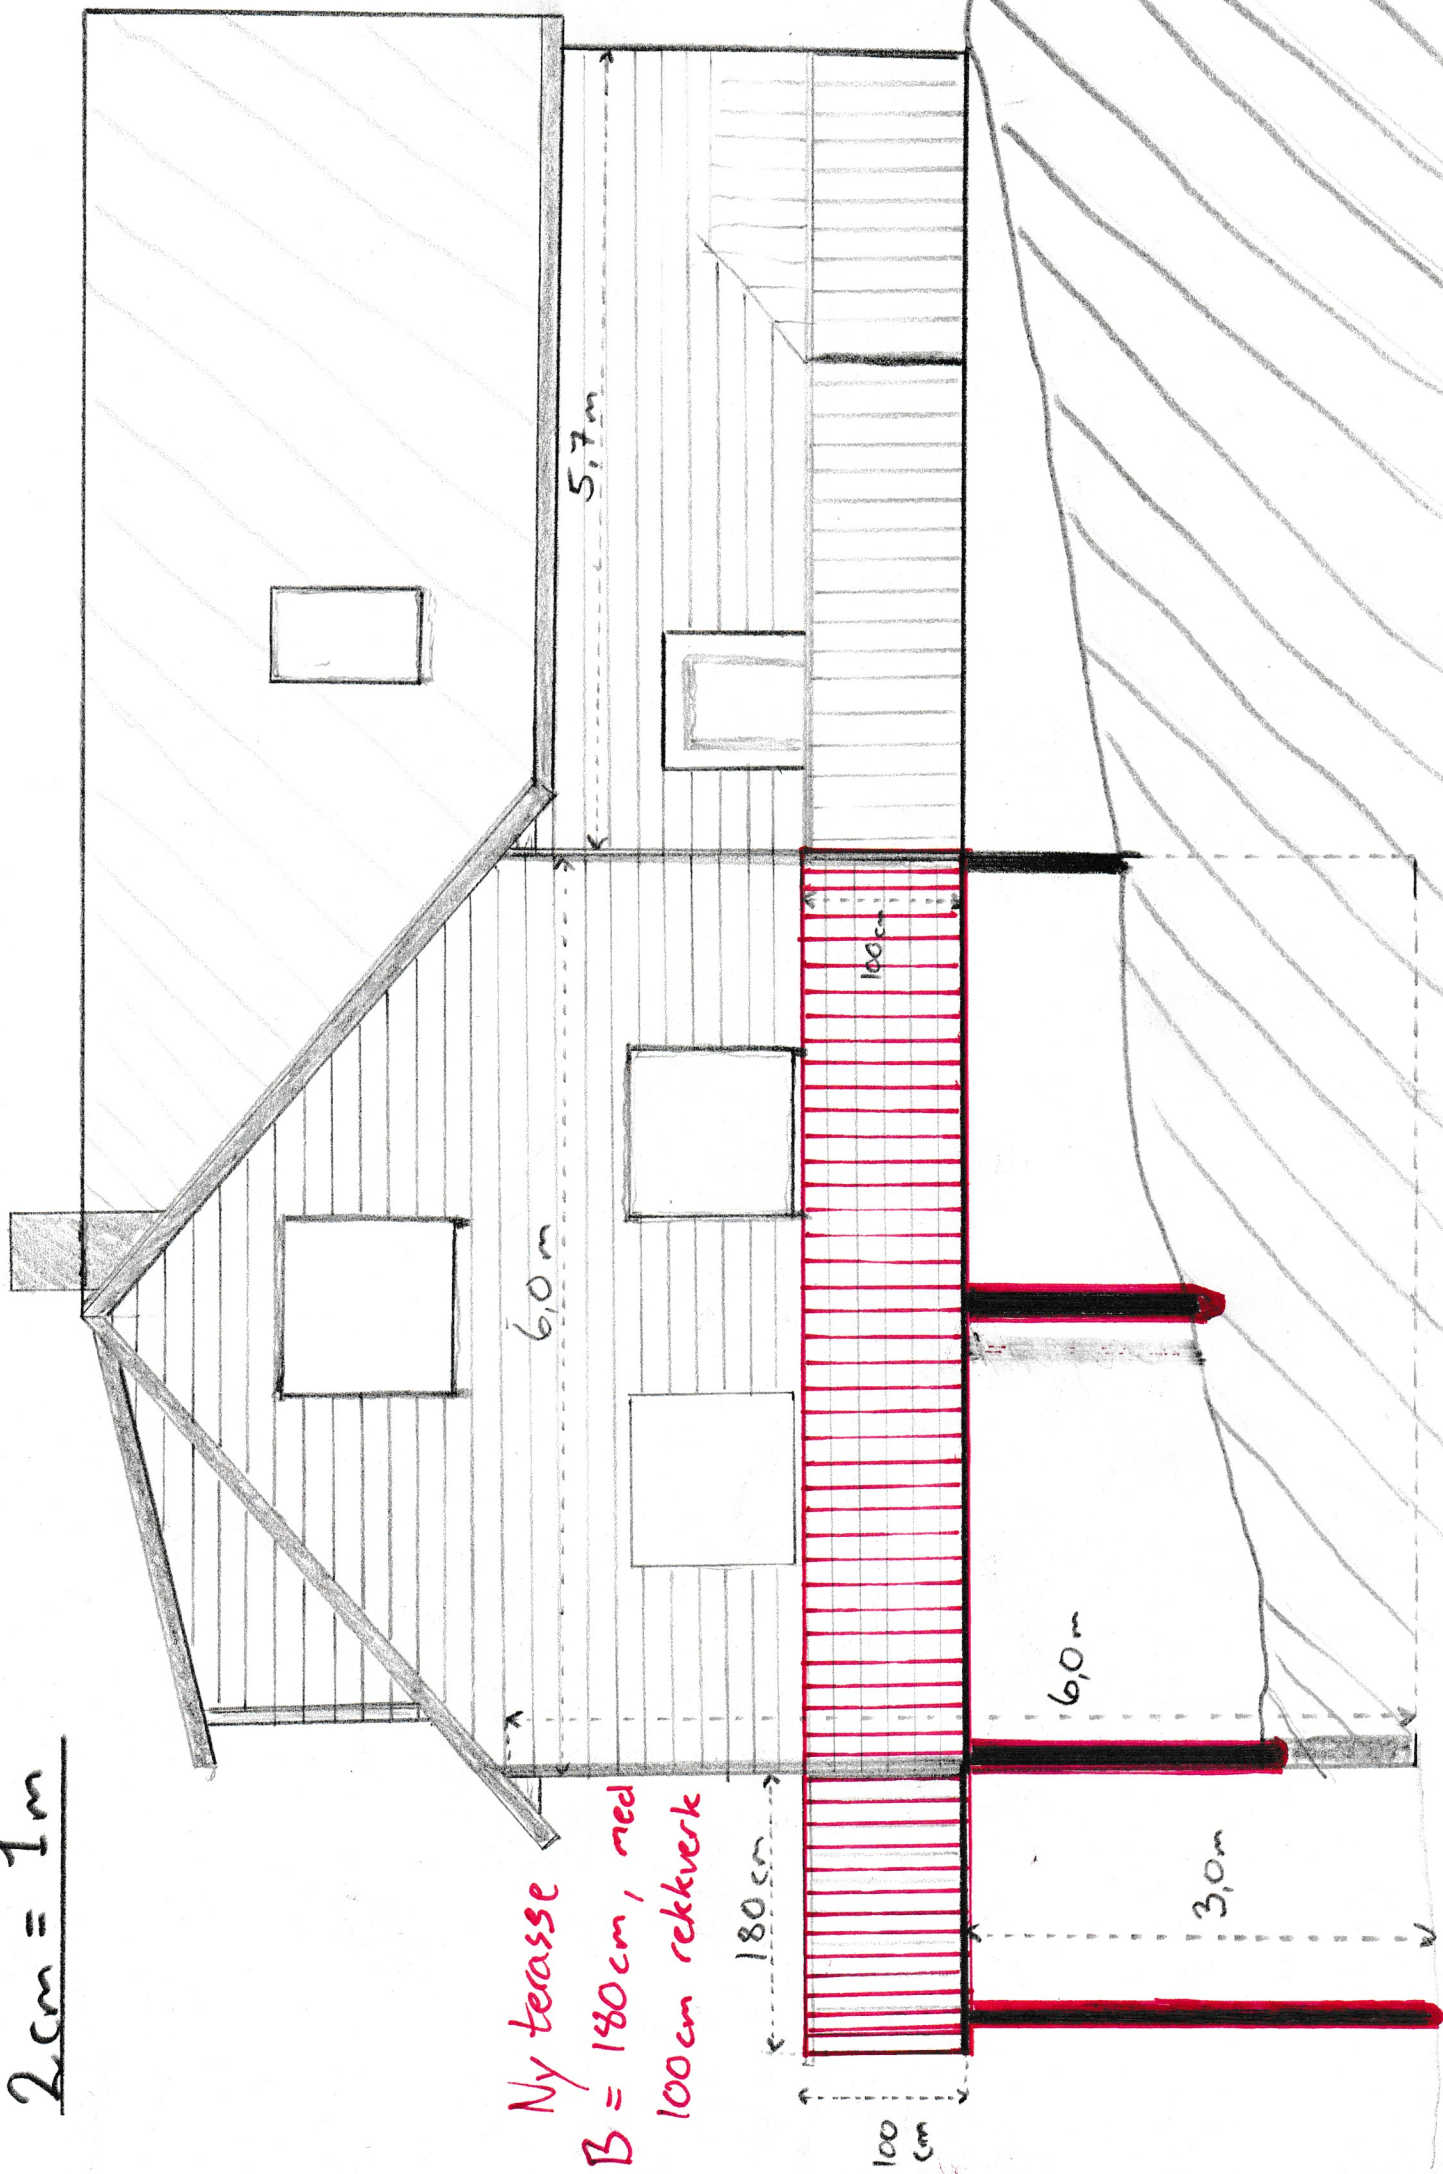

Ny terrasse
B = 180 cm, med
100 cm rekkverk

2 cm = 1 m

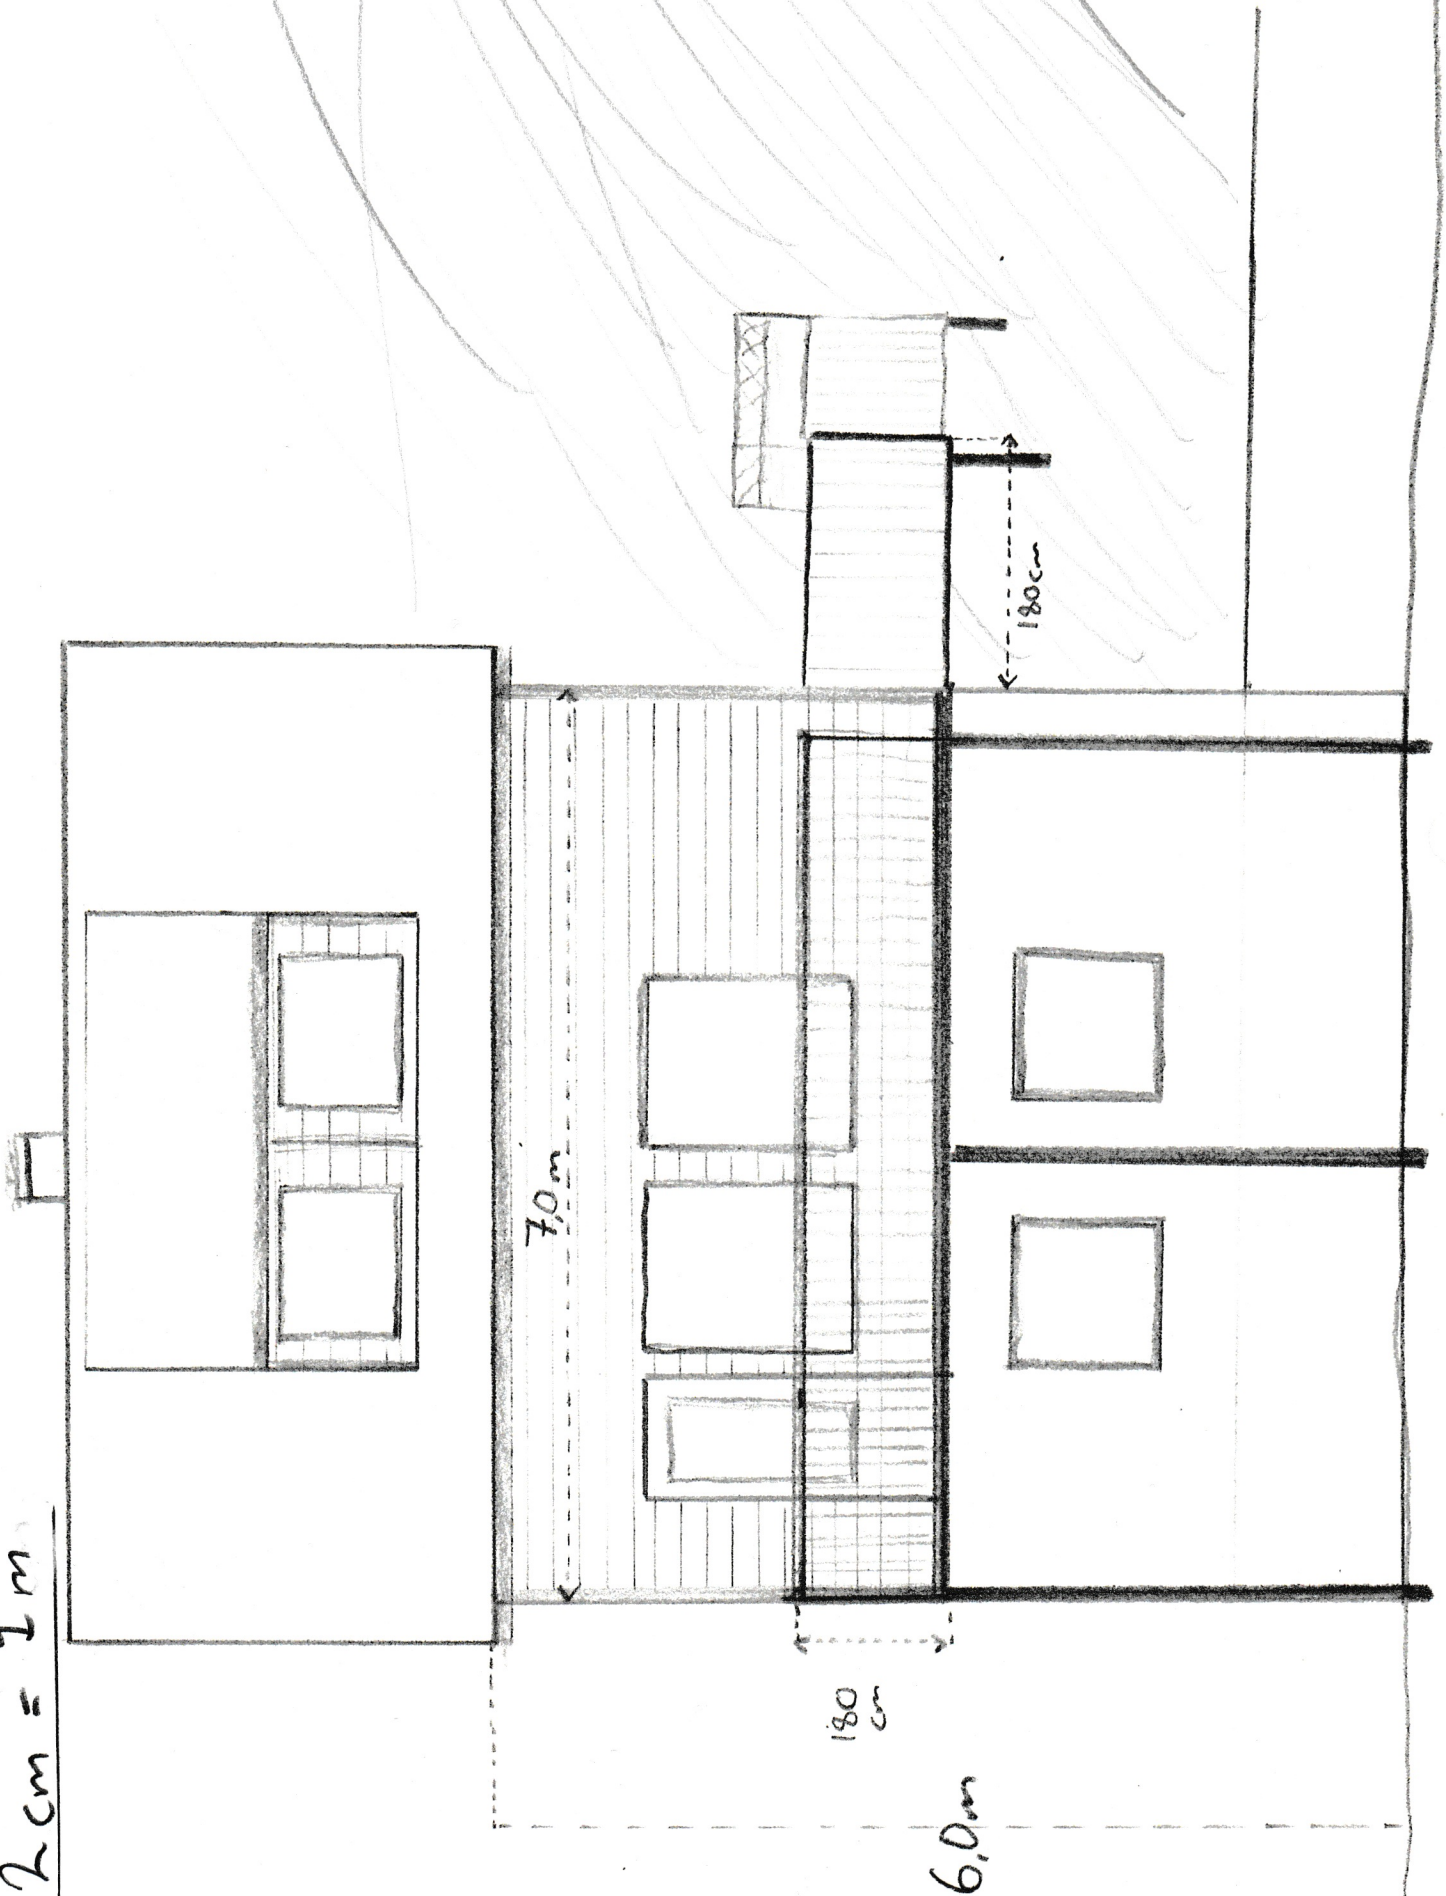

2cm = 1m

