


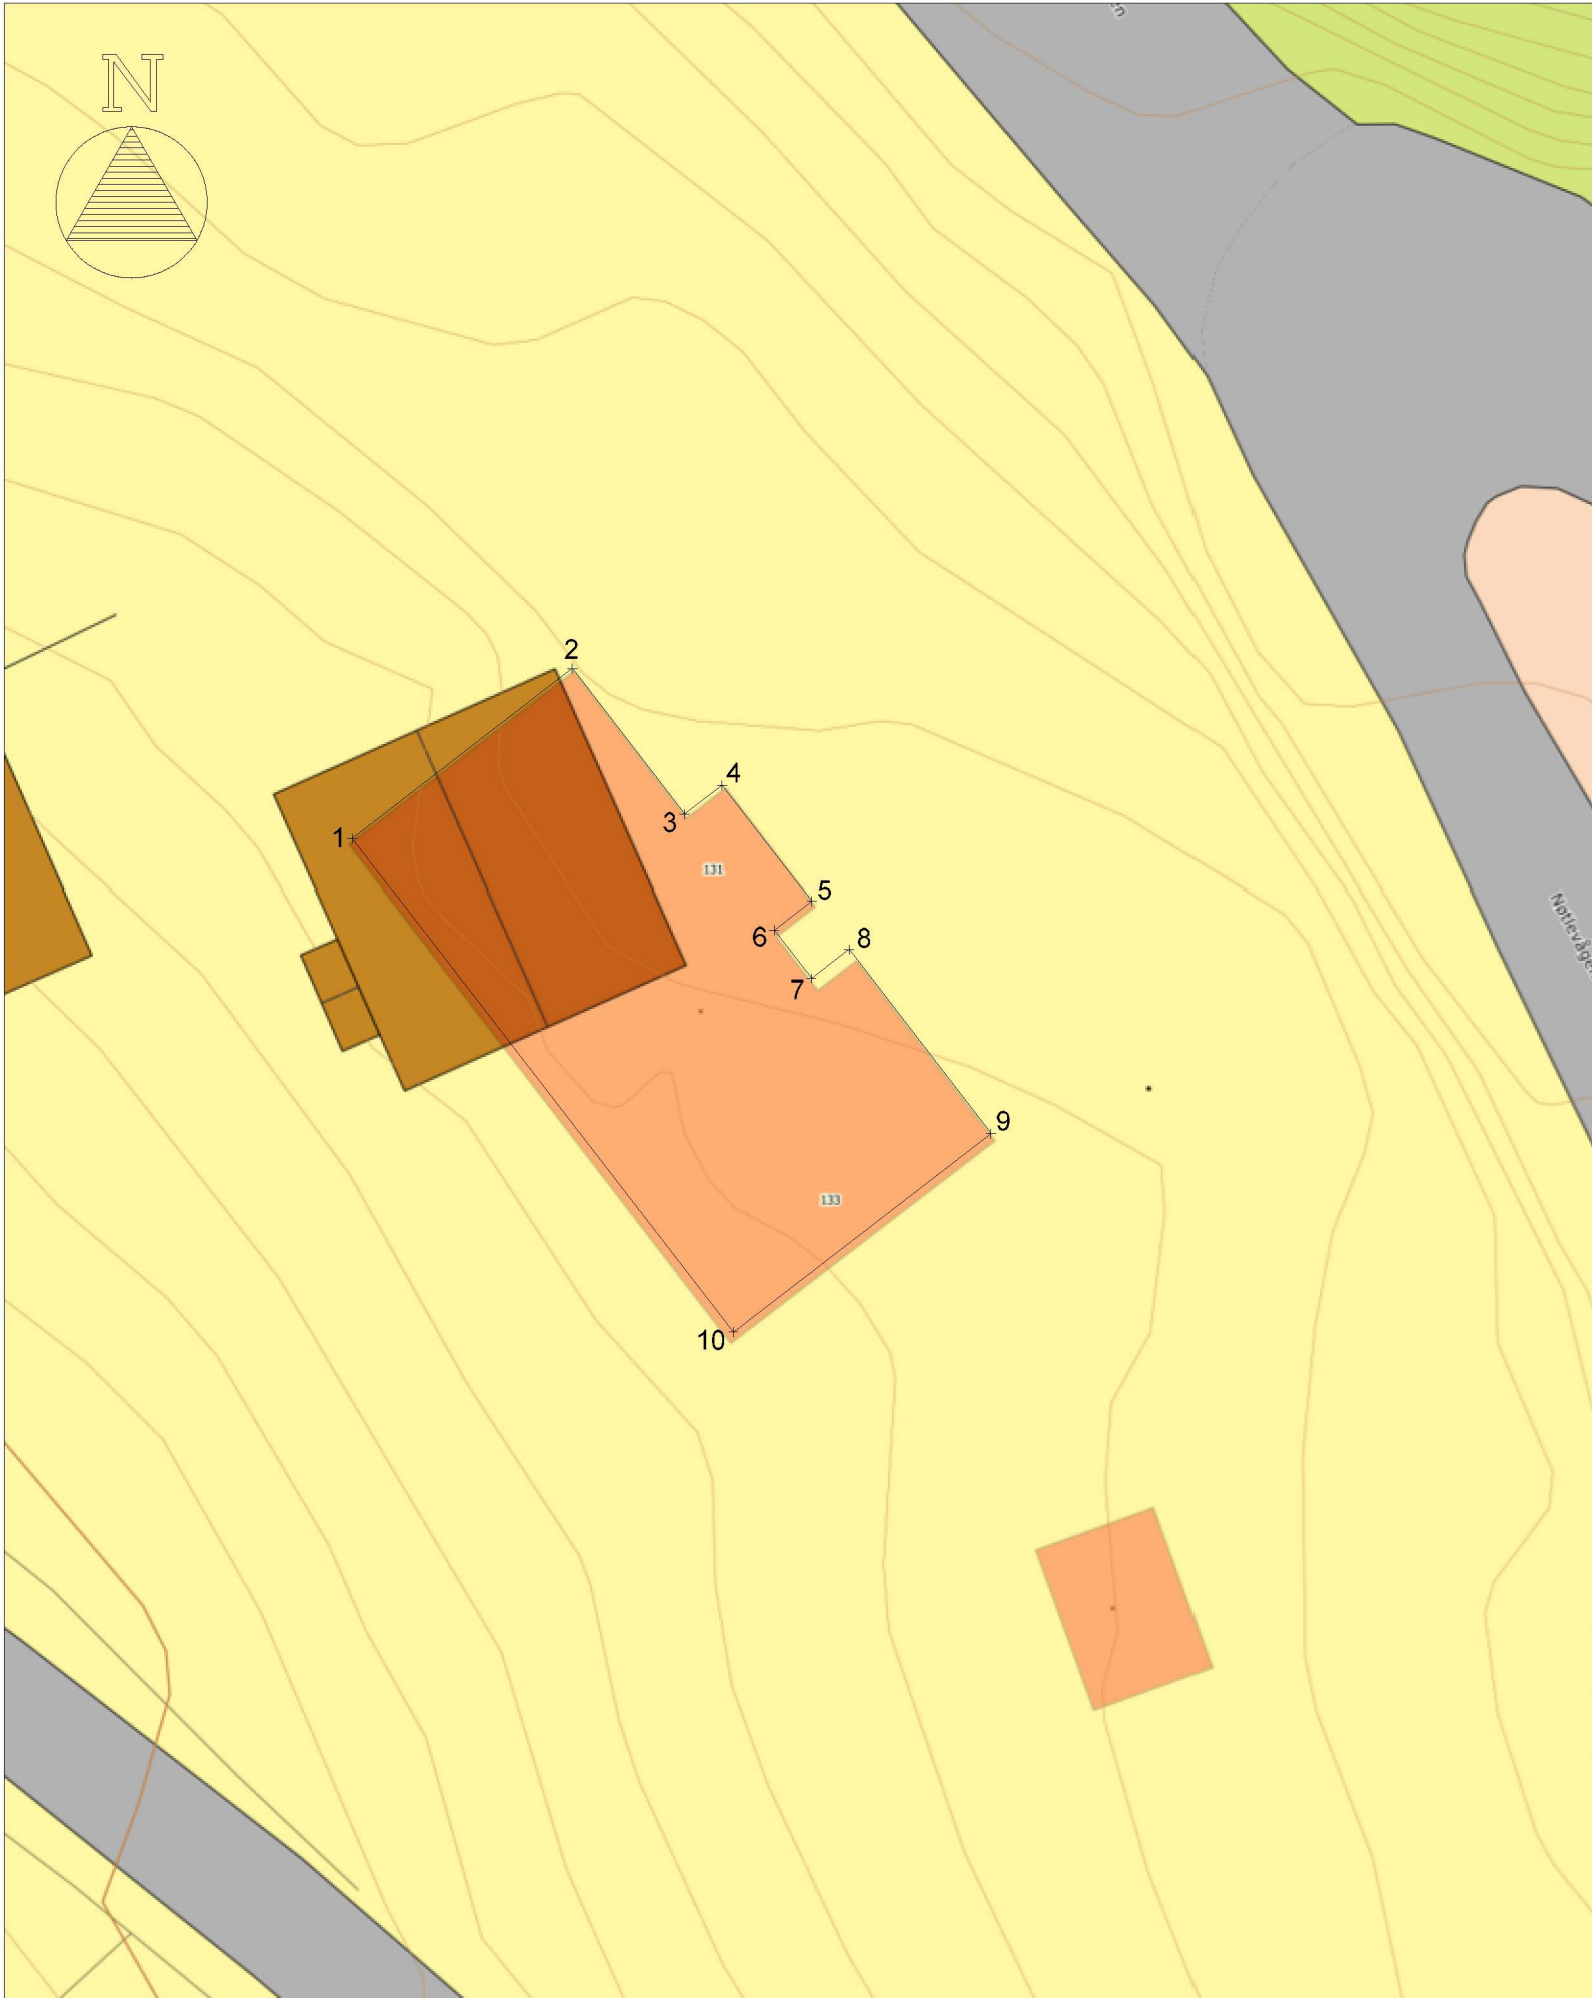

Koordinater for innmålt grunnmur:

Id	Øst	Nord	Høyde
1	288714,653	6728932,565	18
2	288720,472	6728937,054	18
3	288723,441	6728933,206	18
4	288724,431	6728933,969	18
5	288726,8	6728930,898	18
6	288725,811	6728930,135	18
7	288726,798	6728928,855	18
8	288727,788	6728929,619	18
9	288731,541	6728924,755	18
10	288724,732	6728919,501	18



Dato 08.08.2023	Konstr./tegnet	Godkjent	Målestokk 1:200	
ETRS89/UTM SONE 32N NN 2000 høyder				
Innmålt grunnmur Nøtlevågen 133, 5938 Sæbøvågen Gnr/Bnr 469/5				Erstatning for:
				Erstattet av: 901
Henvisning:		Beregning:		