



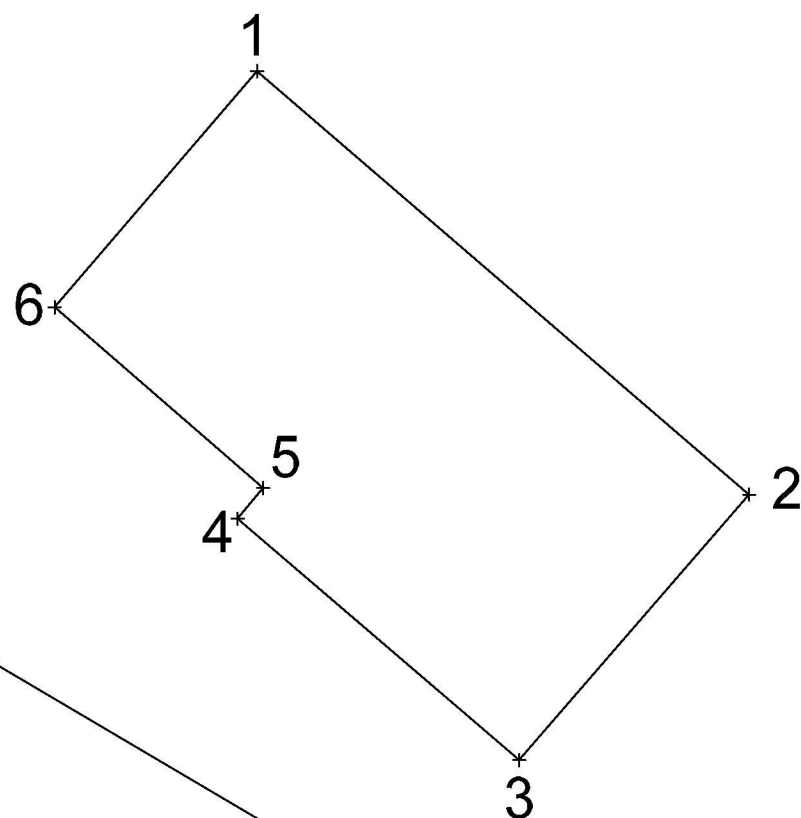

Koordinater for innmålt topp grunnmur:

ID	Øst	Nord	Høyde
1	288235,148	6732975,925	20,27
2	288244,909	6732967,524	20,27
3	288240,351	6732962,257	20,27
4	288234,763	6732967,044	20,27
5	288235,271	6732967,656	20,27
6	288231,133	6732971,241	20,27

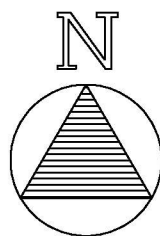

Alversund
Maskinstasjon A.S

Dato 10.01.2023	Konstr./tegnet MM	Godkjent	Målestokk 1:150		
ETRS89/UTM SONE 32N NN 2000 høyder				Erstatning for:	Erstattet av:
Grunnmurstegning Langeneset 165, Seim				901	
Henvisning:		Beregning:		Langenes	