


Tomannsbolig for Mjuebakkane AS
Bolig. Sog 6
Gnr.9.Bnr.28
i Meland kommune
Tegn.Byggm.Steinar Thunold
M.1:100

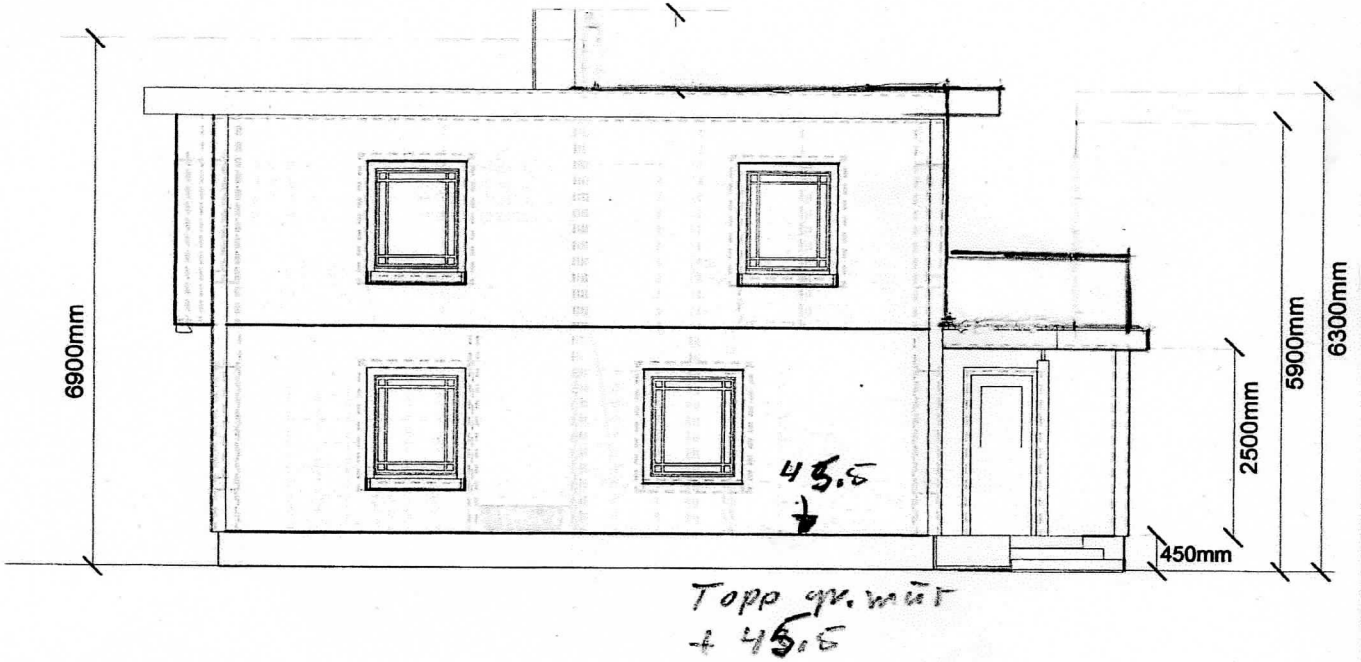

E8

Snitt



A

B

C