


Grøftkart drenering AGROS 138560 år 2020 -2023



Grøft starter i kum koordinat:	N 6716275	Ø 293710
Retningsendring (v/steingard):	N 6716287	Ø 293736
Retningsendring:	N 6716297	Ø 293748
Utløp i elv:	N 6716303	Ø 293762

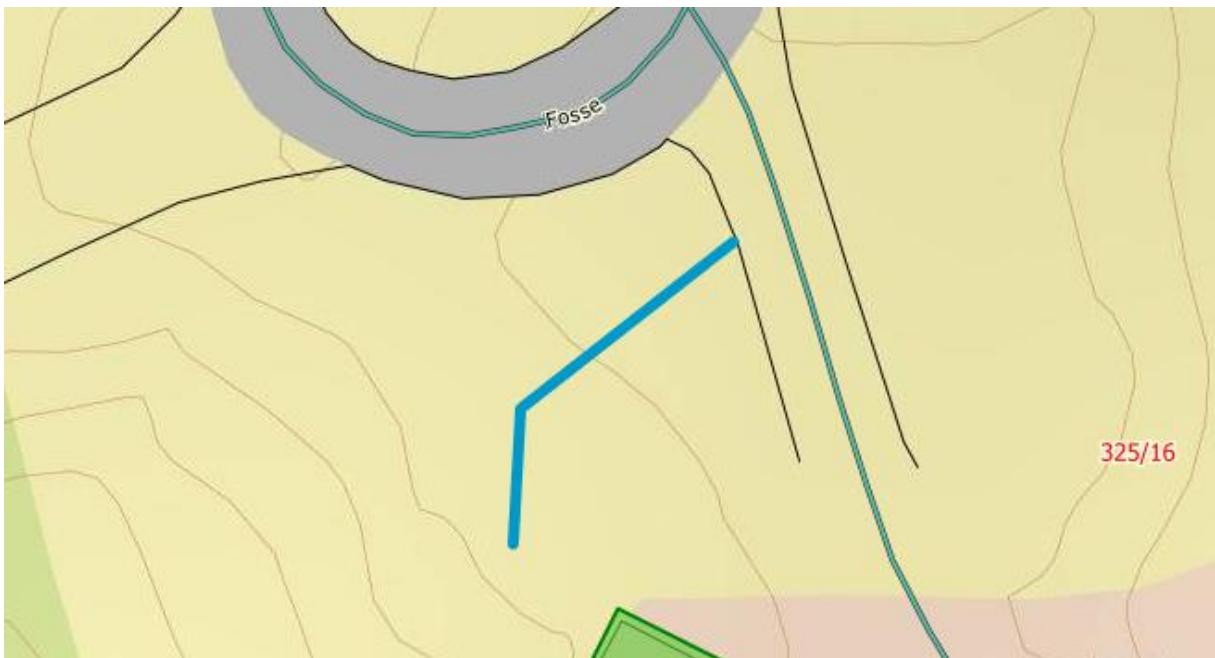

Grøft start:	N 6716204	Ø 293676
Retningsendring	N 6716211	Ø 293676
Utløp til vegfylling	N 6716219	Ø 293686