





748

10  
107  
140  
202  
349  
10

70  
70  
70  
65  
70  
72  
72  
25  
72  
72  
80  
72  
72

400

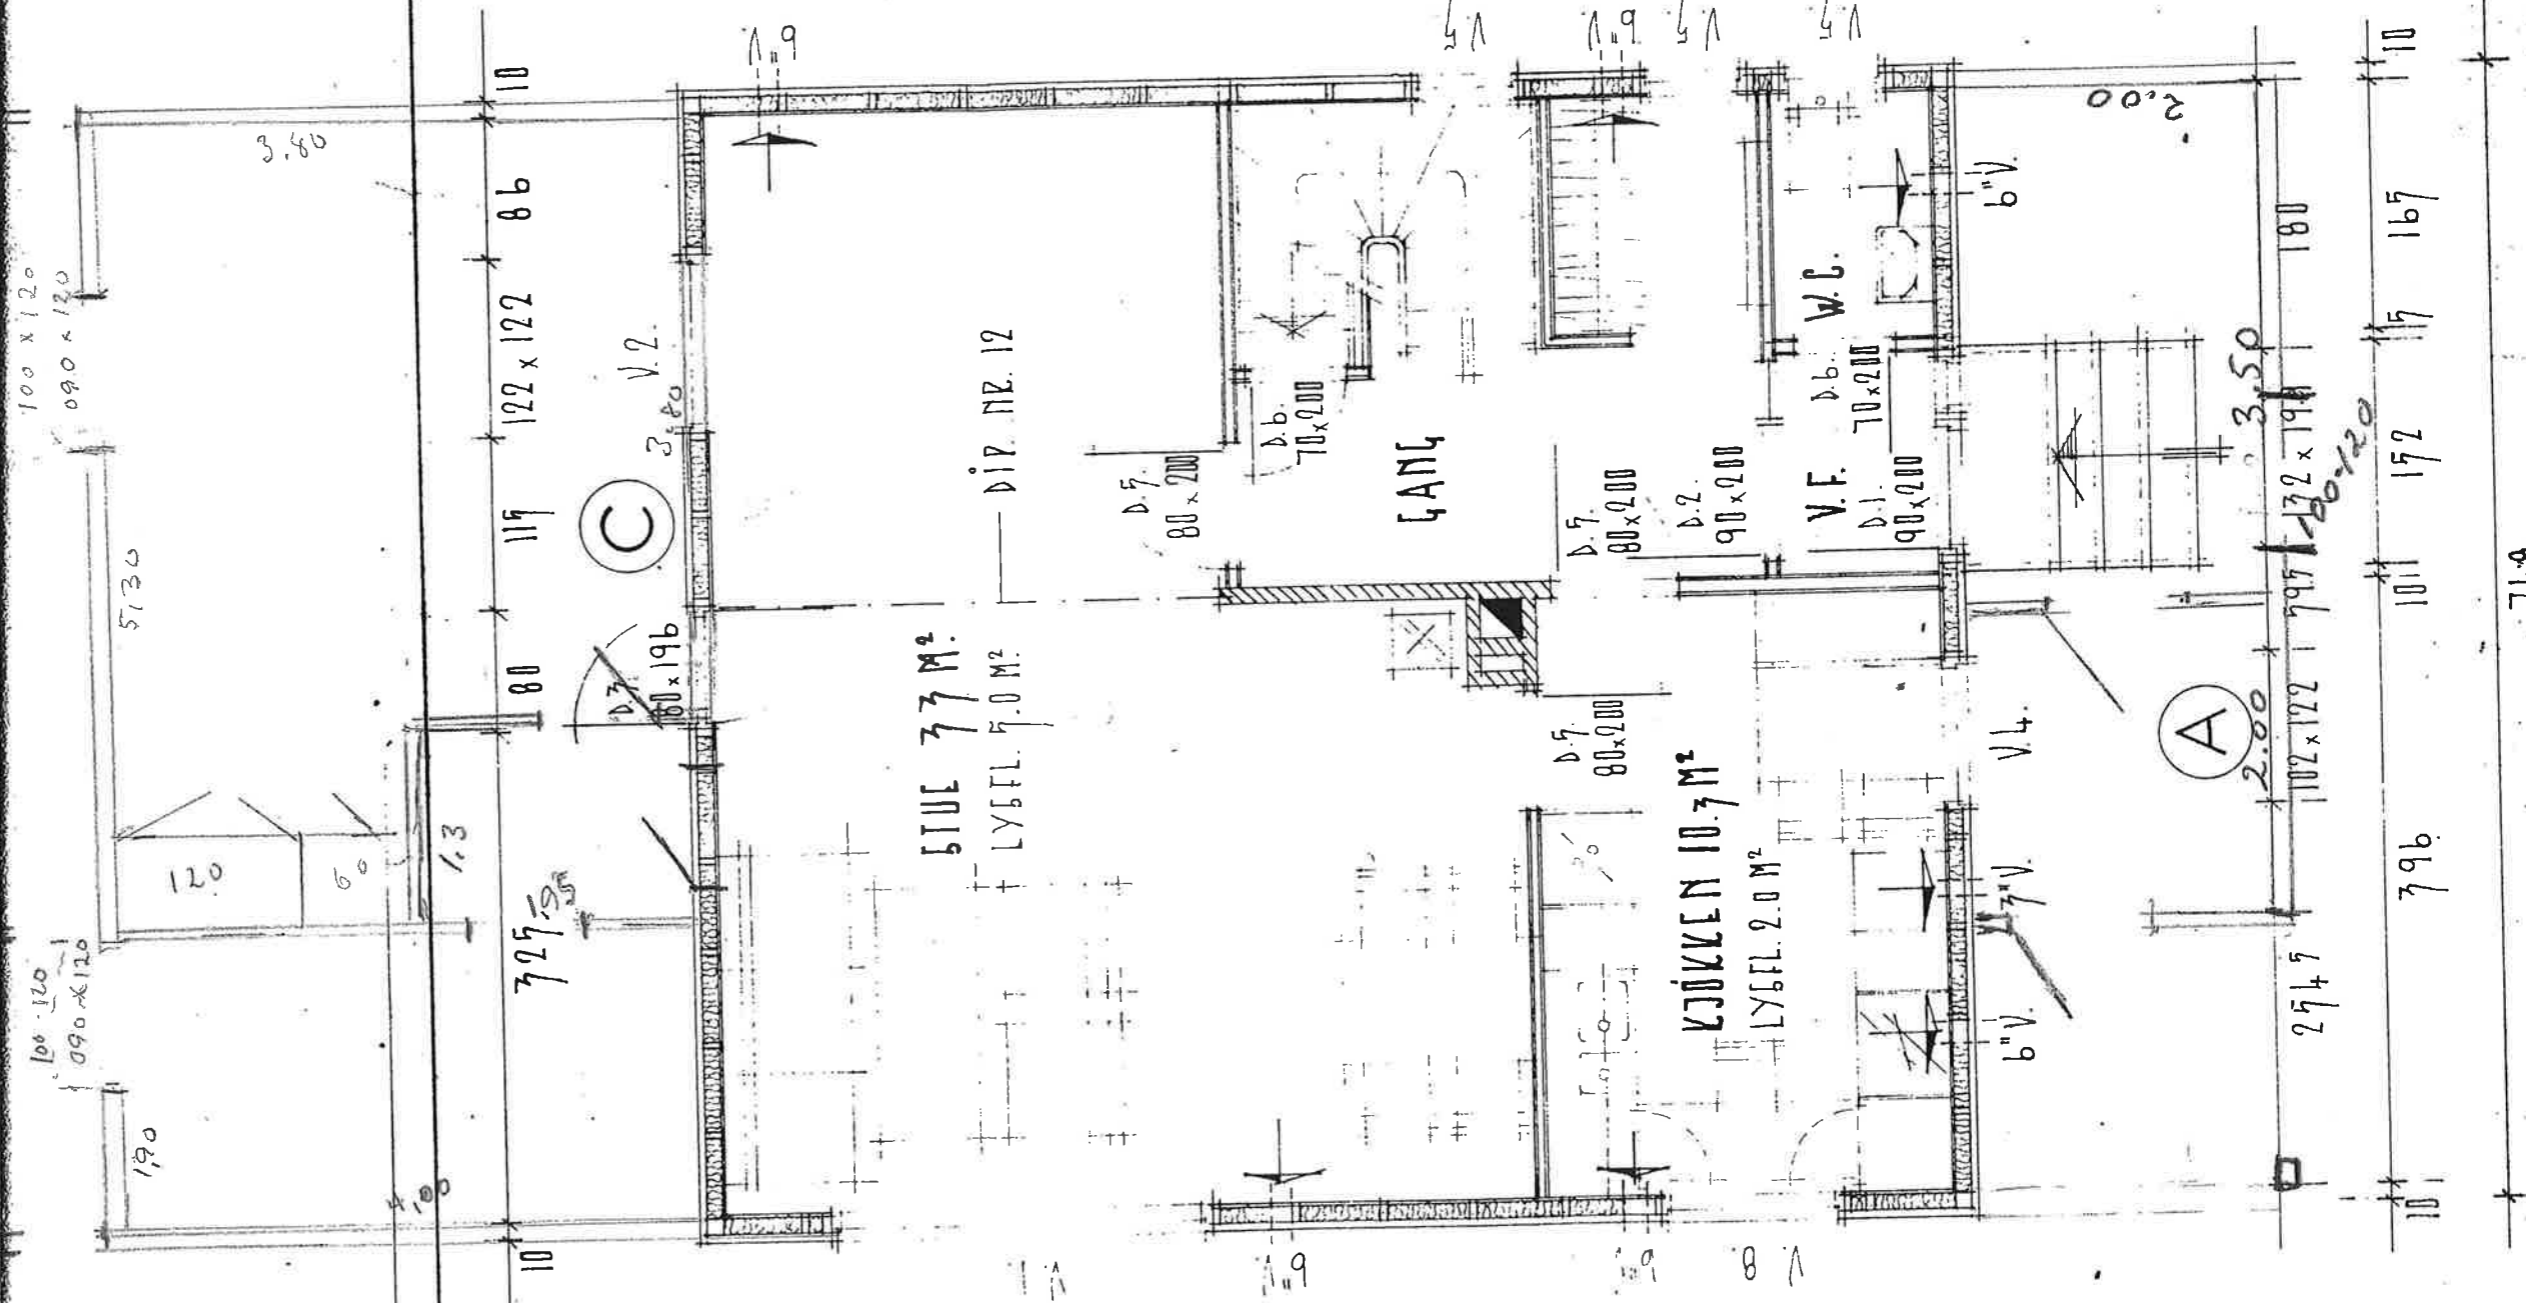

10  
267  
741  
715  
294  
715  
122  
117

252  
172  
294

10  
10  
10

837

10

17

167

101

152

796

10

71.4

2.00

W.C.

V.F.

D.I.

90x200

D.2.

90x200

D.1.

80x200

D.1.

80x200

D.1.

80x200

D.1.

70x200

(C)

(A)

V.2.

320

STUČE

77 M²

LYSEL.

5.0 M²

KJOKVEN

10.7 M²

LYSEL.

2.0 M²

DIP

NR. 12

3.80

071

190

5730

100 x 120

090 x 120

100 x 120

090 x 120

10

119

122 x 122

86

10

80

119

122 x 122

86

10

727















6"V

6"V

