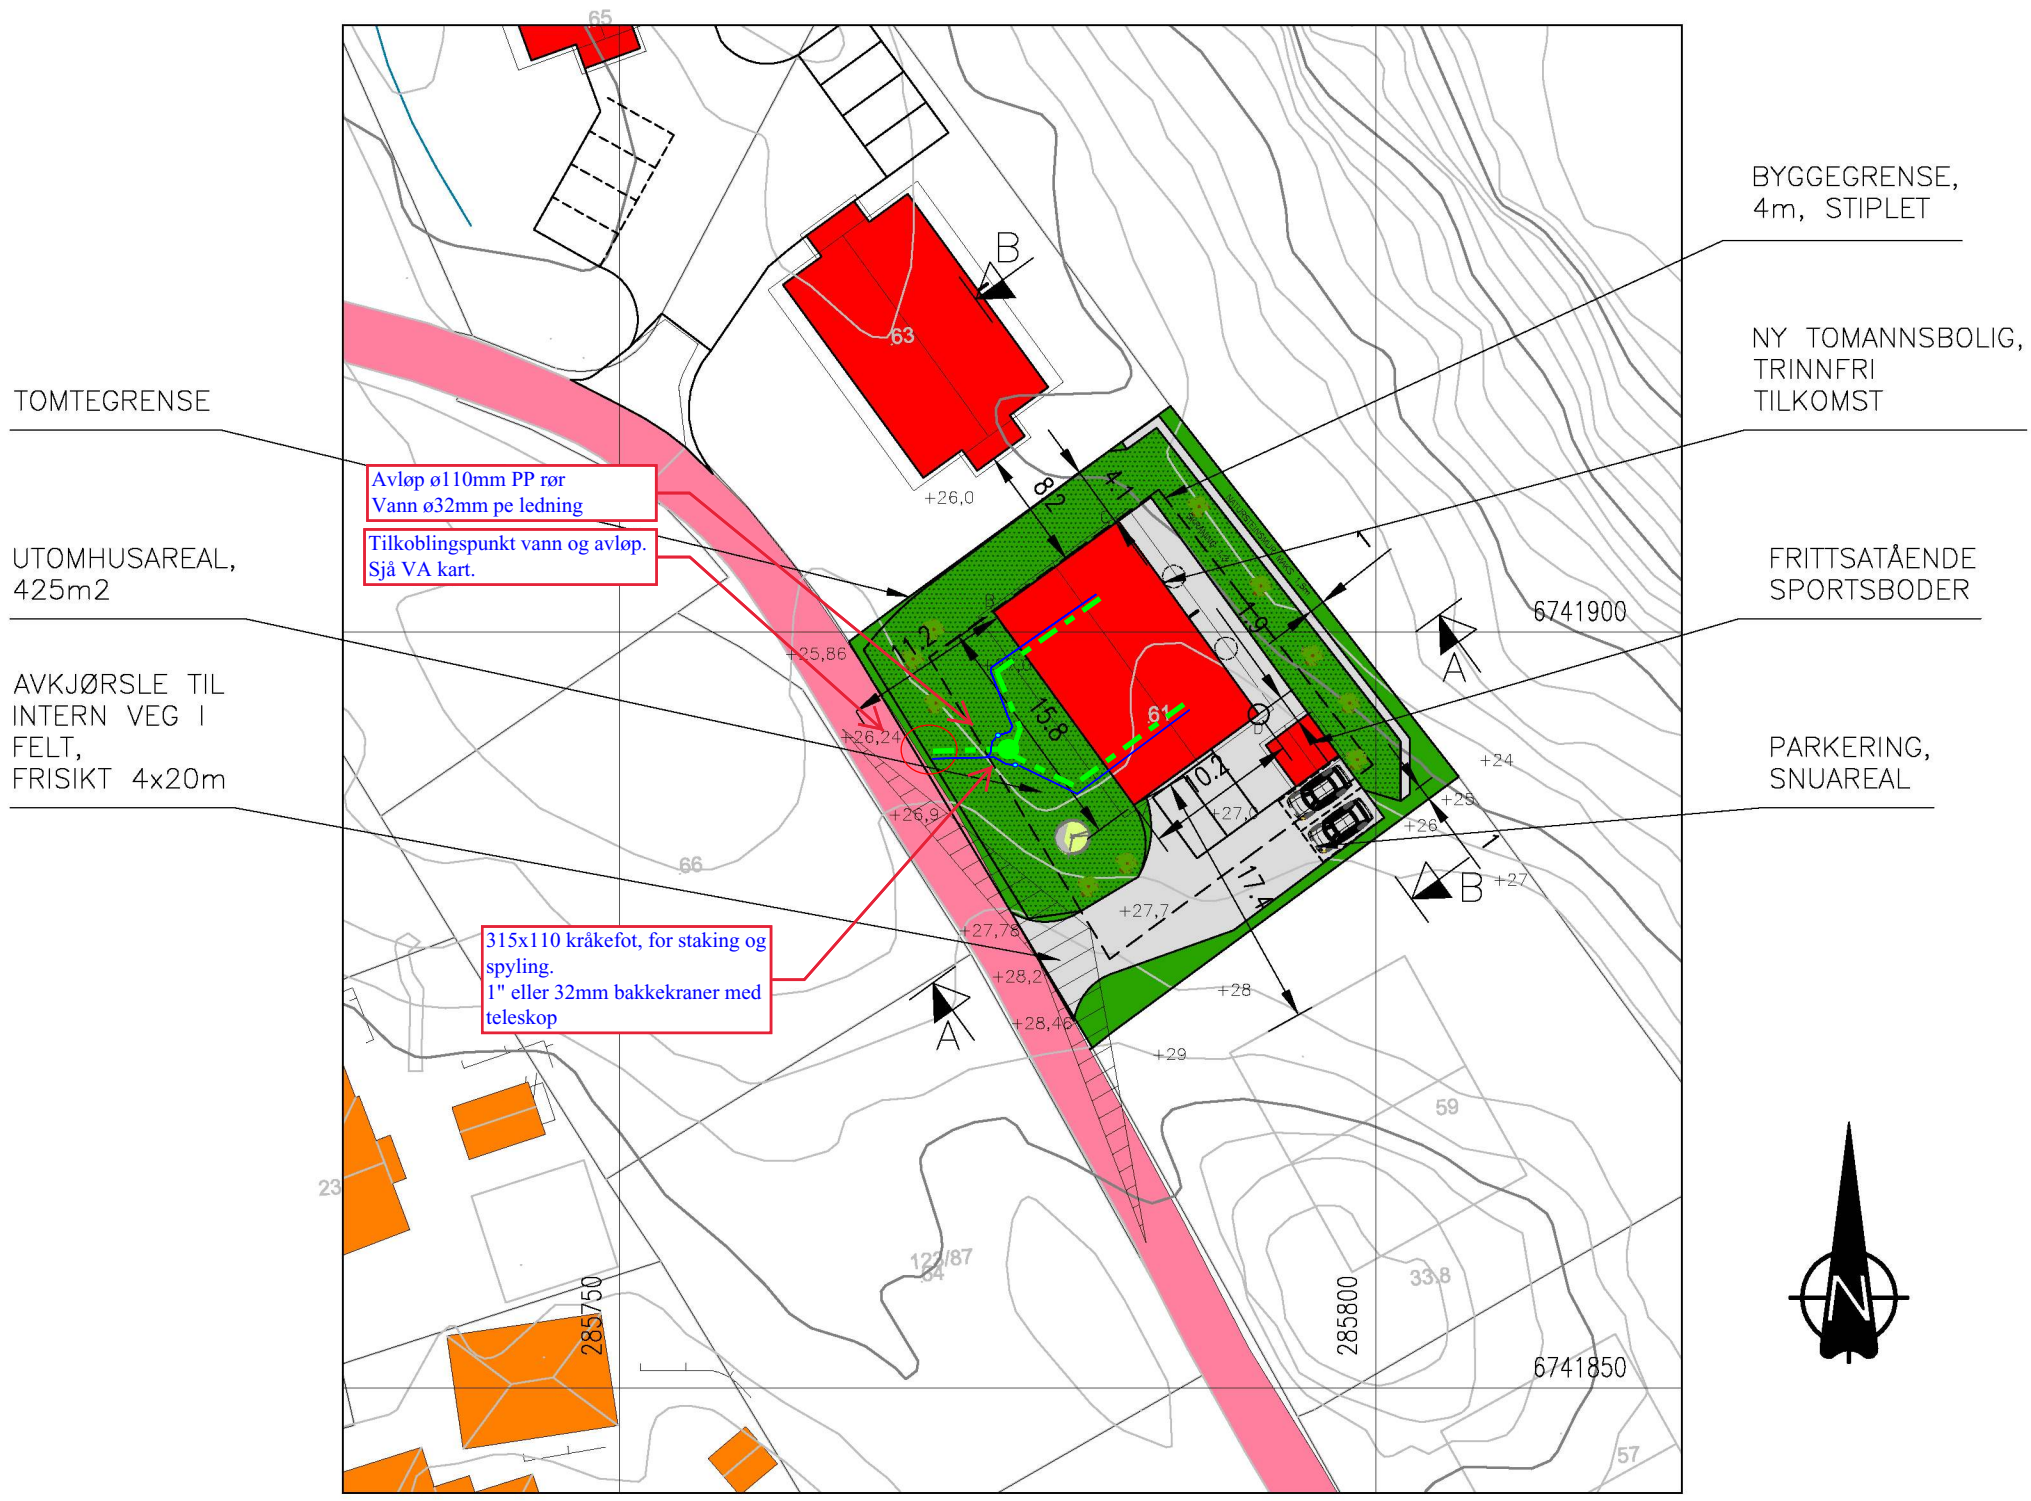

SITUASJONSPLAN

GNR.123, BNR.143, ALVER KOMMUNE

OK GULV: KOTE +27,2

FOR TERRENGPROFILER, SE TEGNING 19120017A11 OG 12.

VEST VVS AS

25.02.2020

Einar Stusdal

KOORDINATER HJØRNER BYGG:

A: 285784.0175
6741888.5281

B: 285774.7257
6741901.3071

C: 285782.9754
6741907.3056

D: 285792.2672
6741894.5266

REV.	DESCRIPTION	DATE/SIGN
B	FLYTTET HUS, SKRÅNING	06.02.20/LAH
A	UTEAREAL	04.02.20/LAH

NOTE!
* PART OF DRAWING MAY NOT BE SHOWN IN SCALE
* DO NOT TAKE MEASURES ON DRAWING
* ONLY RELAY ON GIVE DIMENSIONS

ACCORDING TO INTERNATIONAL LAWS, THIS DRAWING IS THE PROPERTY OF ARKOCONSULT AS. THE DRAWING CAN NOT BE USED, MADE PUBLIC OR HANDED OVER TO A THIRD PART WITHOUT OUR WRITTEN CONSENT. ANY INFRINGEMENT WILL LEAD TO LEGAL PROCEEDINGS.

SØREIDE BYGG AS

NY TOMANNSBOLIG, SØKN.TEGN.

REVISION/DATE: B/06.02.20

PROJECT NO.: 2020017

GBNR. 123/143, ALVER
SITUASJONSPLAN

DRAWING NO.: 19120017A10

arkoconsult
ARKOCONSULT AS, Postboks 103, 5291 Valest.f.
Tel.: 56390003 – Fax.: 56191130 – Mob.: 93241511
Mail: post@arkoconsult.no – Org.nr.: 918269665 MVA

SCALE: 1:500	FORMAT: A3
DRAWN: LAH	DATE: 29.01.20
CHECKED: OH	DATE: 03.02.20