


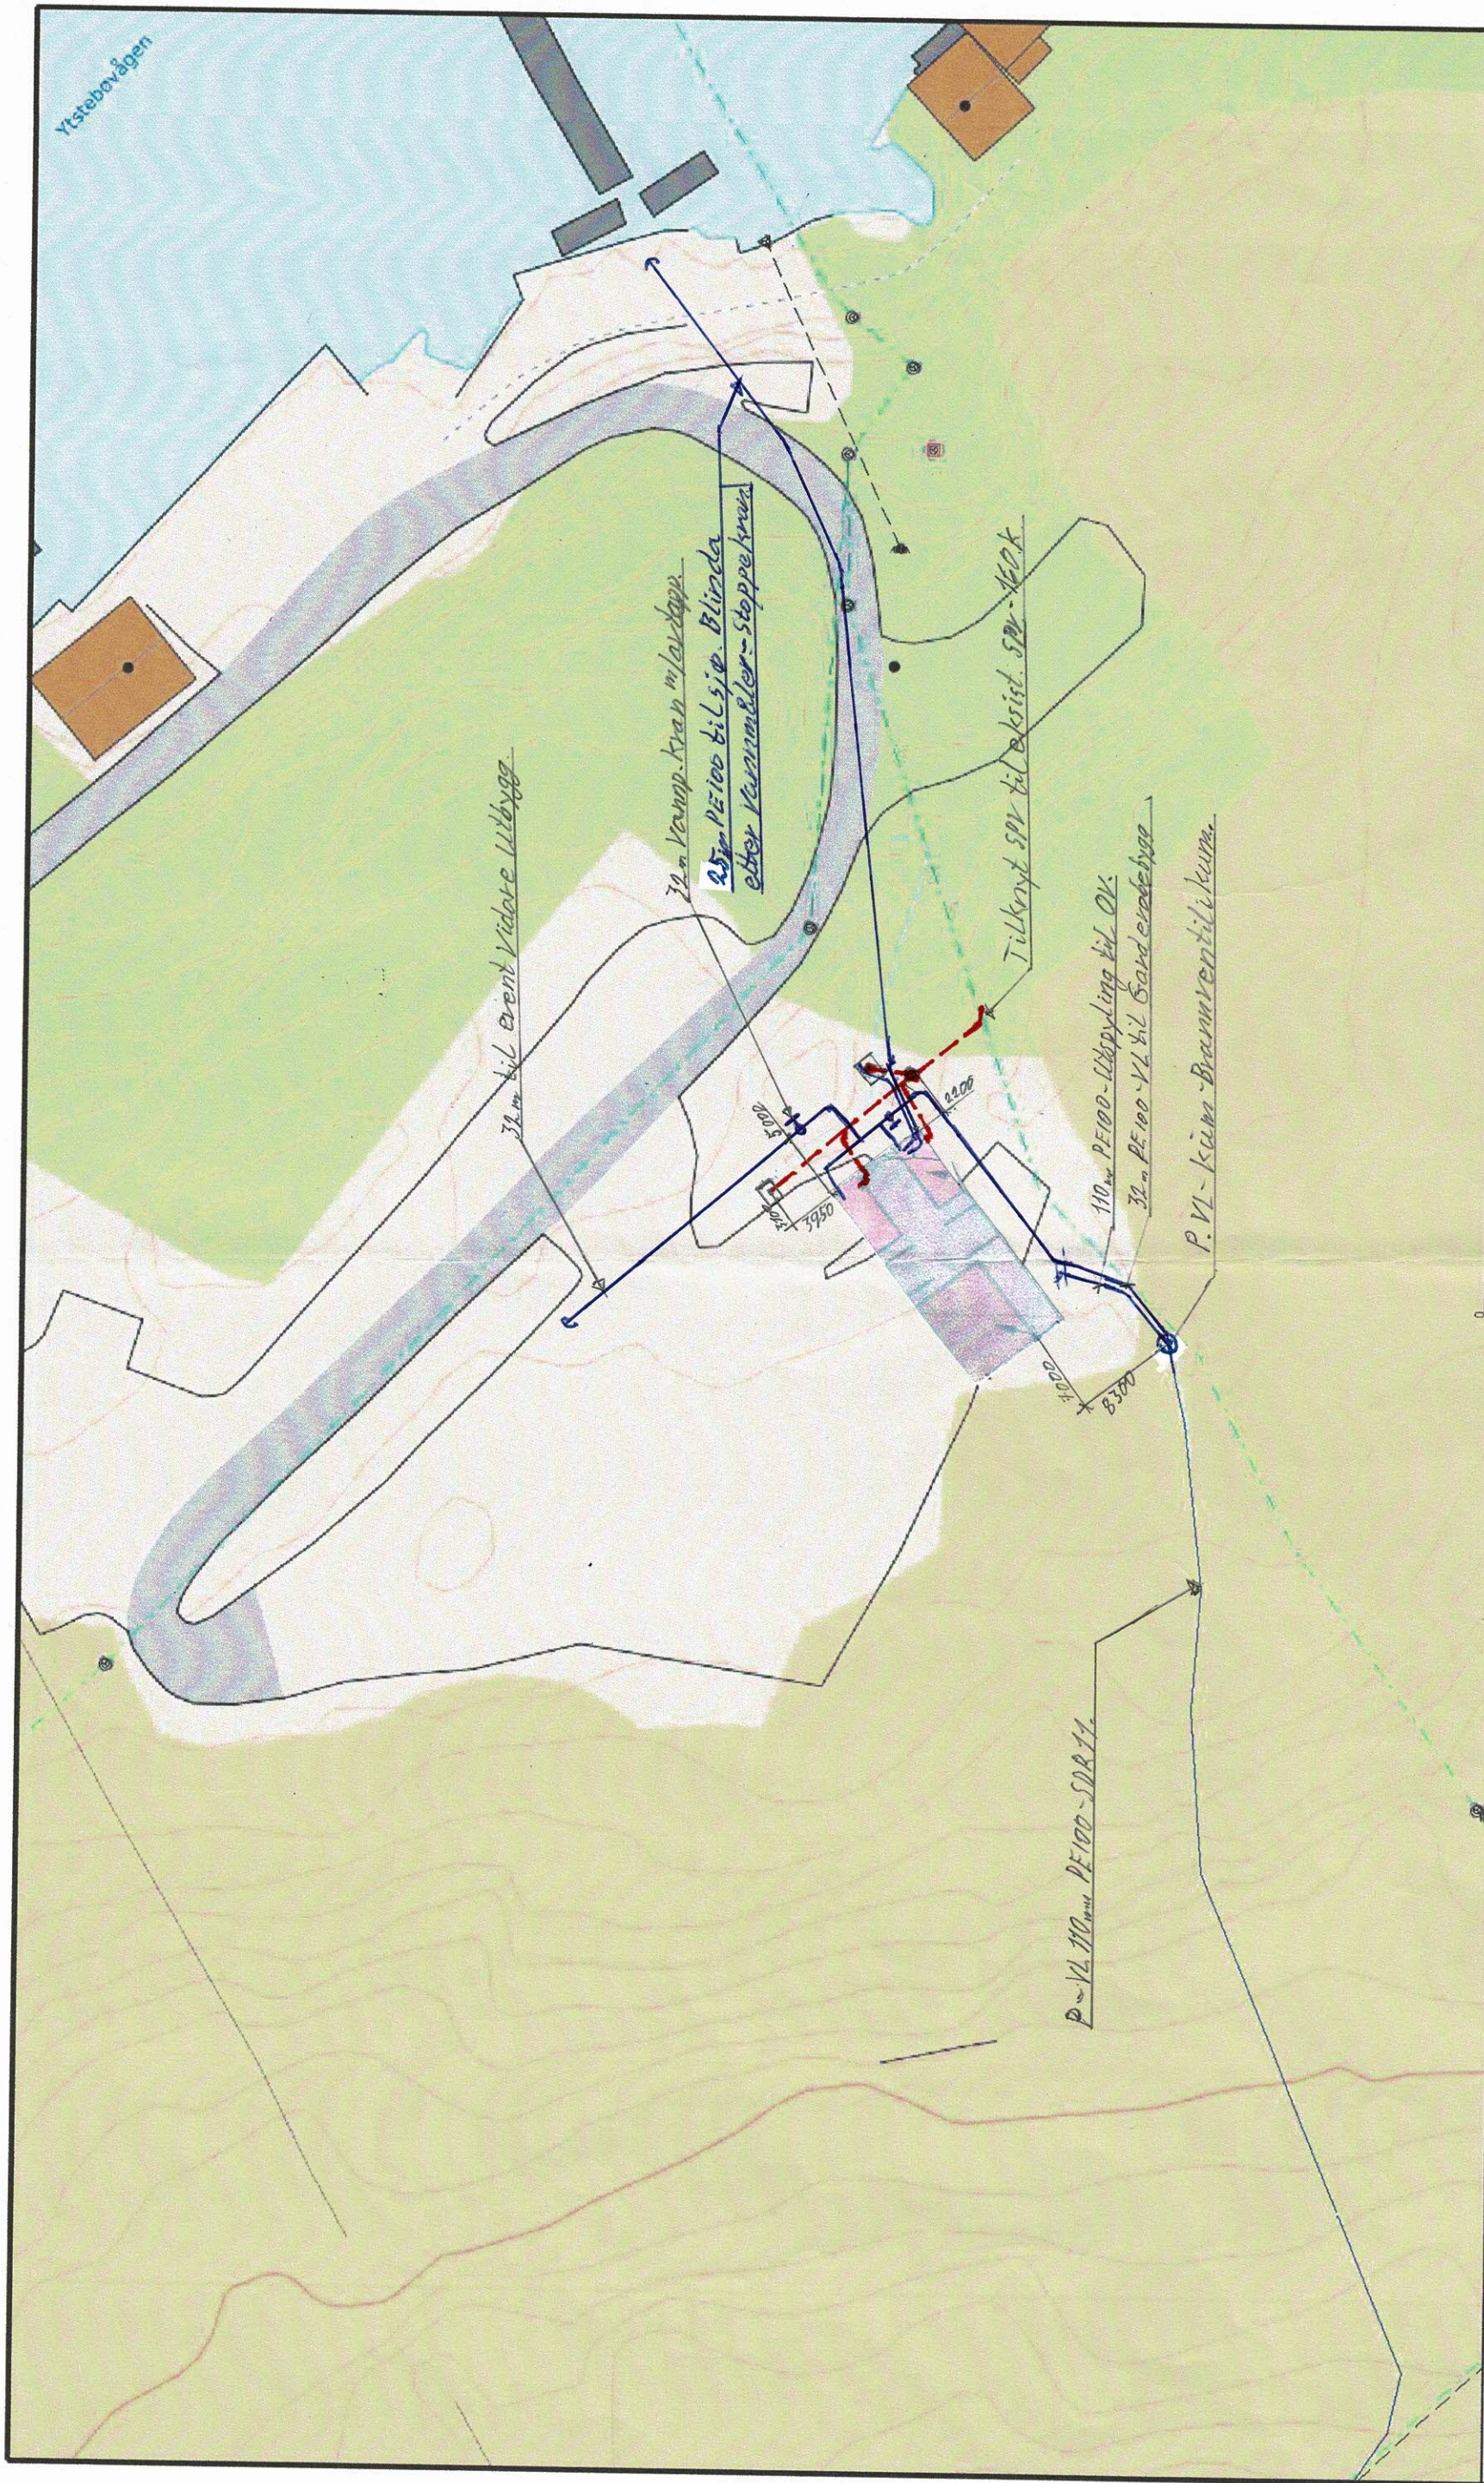

Roald Straume, Sjøbrekka 1, 5737 Sletta		Sletta Kai og Frixid		Sbnr. 488/6	
		Utr. VI - SPV Spedning		16.06.2027	
		LINDASBORG SANTER SPV HEDALSTED			
		Alver kommune VVA Avdeling		2021.02.02	
		N		II	
		1:500			