


# SITUASJONSPLAN

D 1/1

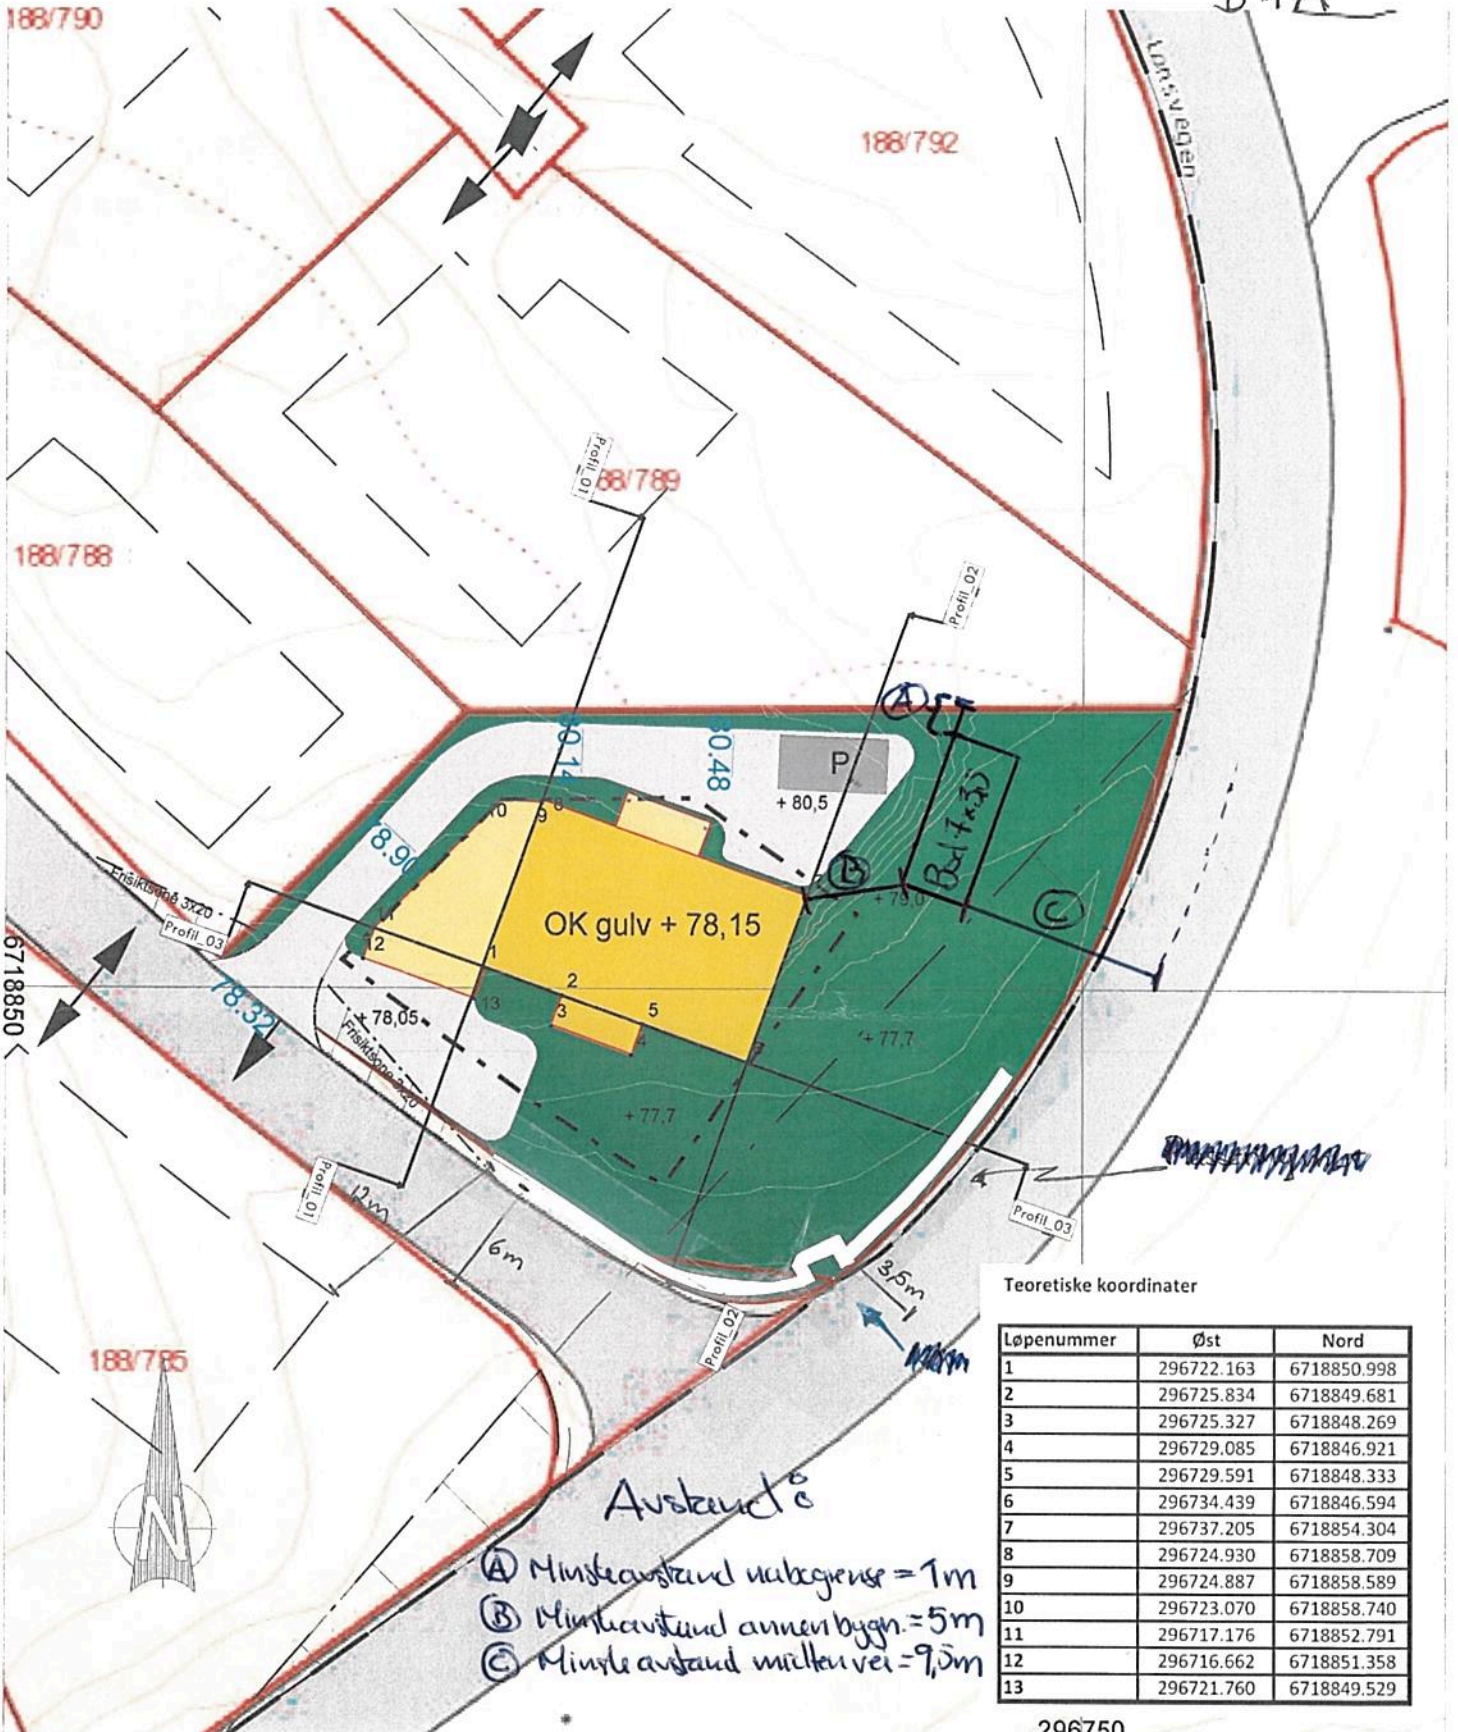

Teoretiske koordinater

Løpnummer	Øst	Nord
1	296722.163	6718850.998
2	296725.834	6718849.681
3	296725.327	6718848.269
4	296729.085	6718846.921
5	296729.591	6718848.333
6	296734.439	6718846.594
7	296737.205	6718854.304
8	296724.930	6718858.709
9	296724.887	6718858.589
10	296723.070	6718858.740
11	296717.176	6718852.791
12	296716.662	6718851.358
13	296721.760	6718849.529

296750

REV. ANT. REVIDERING GJELDER SIGN. DATO

## Tegnforklaring

<span style="background-color: yellow; border: 1px solid black; display: inline-block; width: 15px; height: 10px;"></span>	Bolig
<span style="background-color: orange; border: 1px solid black; display: inline-block; width: 15px; height: 10px;"></span>	Garasje
<span style="background-color: green; border: 1px solid black; display: inline-block; width: 15px; height: 10px;"></span>	Grøntområde
<span style="background-color: lightgrey; border: 1px solid black; display: inline-block; width: 15px; height: 10px;"></span>	Veg
<span style="background-color: grey; border: 1px solid black; display: inline-block; width: 15px; height: 10px;"></span>	Parkering
<span style="border-bottom: 1px dashed black; display: inline-block; width: 15px;"></span>	Andre sikringssoner



ANKO AS  
Fjøsangerveien 50C  
5059 Bergen  
Tel +47 5538 7870 Fax +47 5538 7871  
<http://www.anko.no>

TEGNET sh  
KONTR. gob  
MÅL 1 : 250  
DATO 19.04.2013

Villanger & Sønner AS  
Boligtomt Gnr 188, bnr 787 Knarvik  
Lindås kommune

Situasjonsplan

SAK NR. TEGN NR. REV.

906