


1:1000

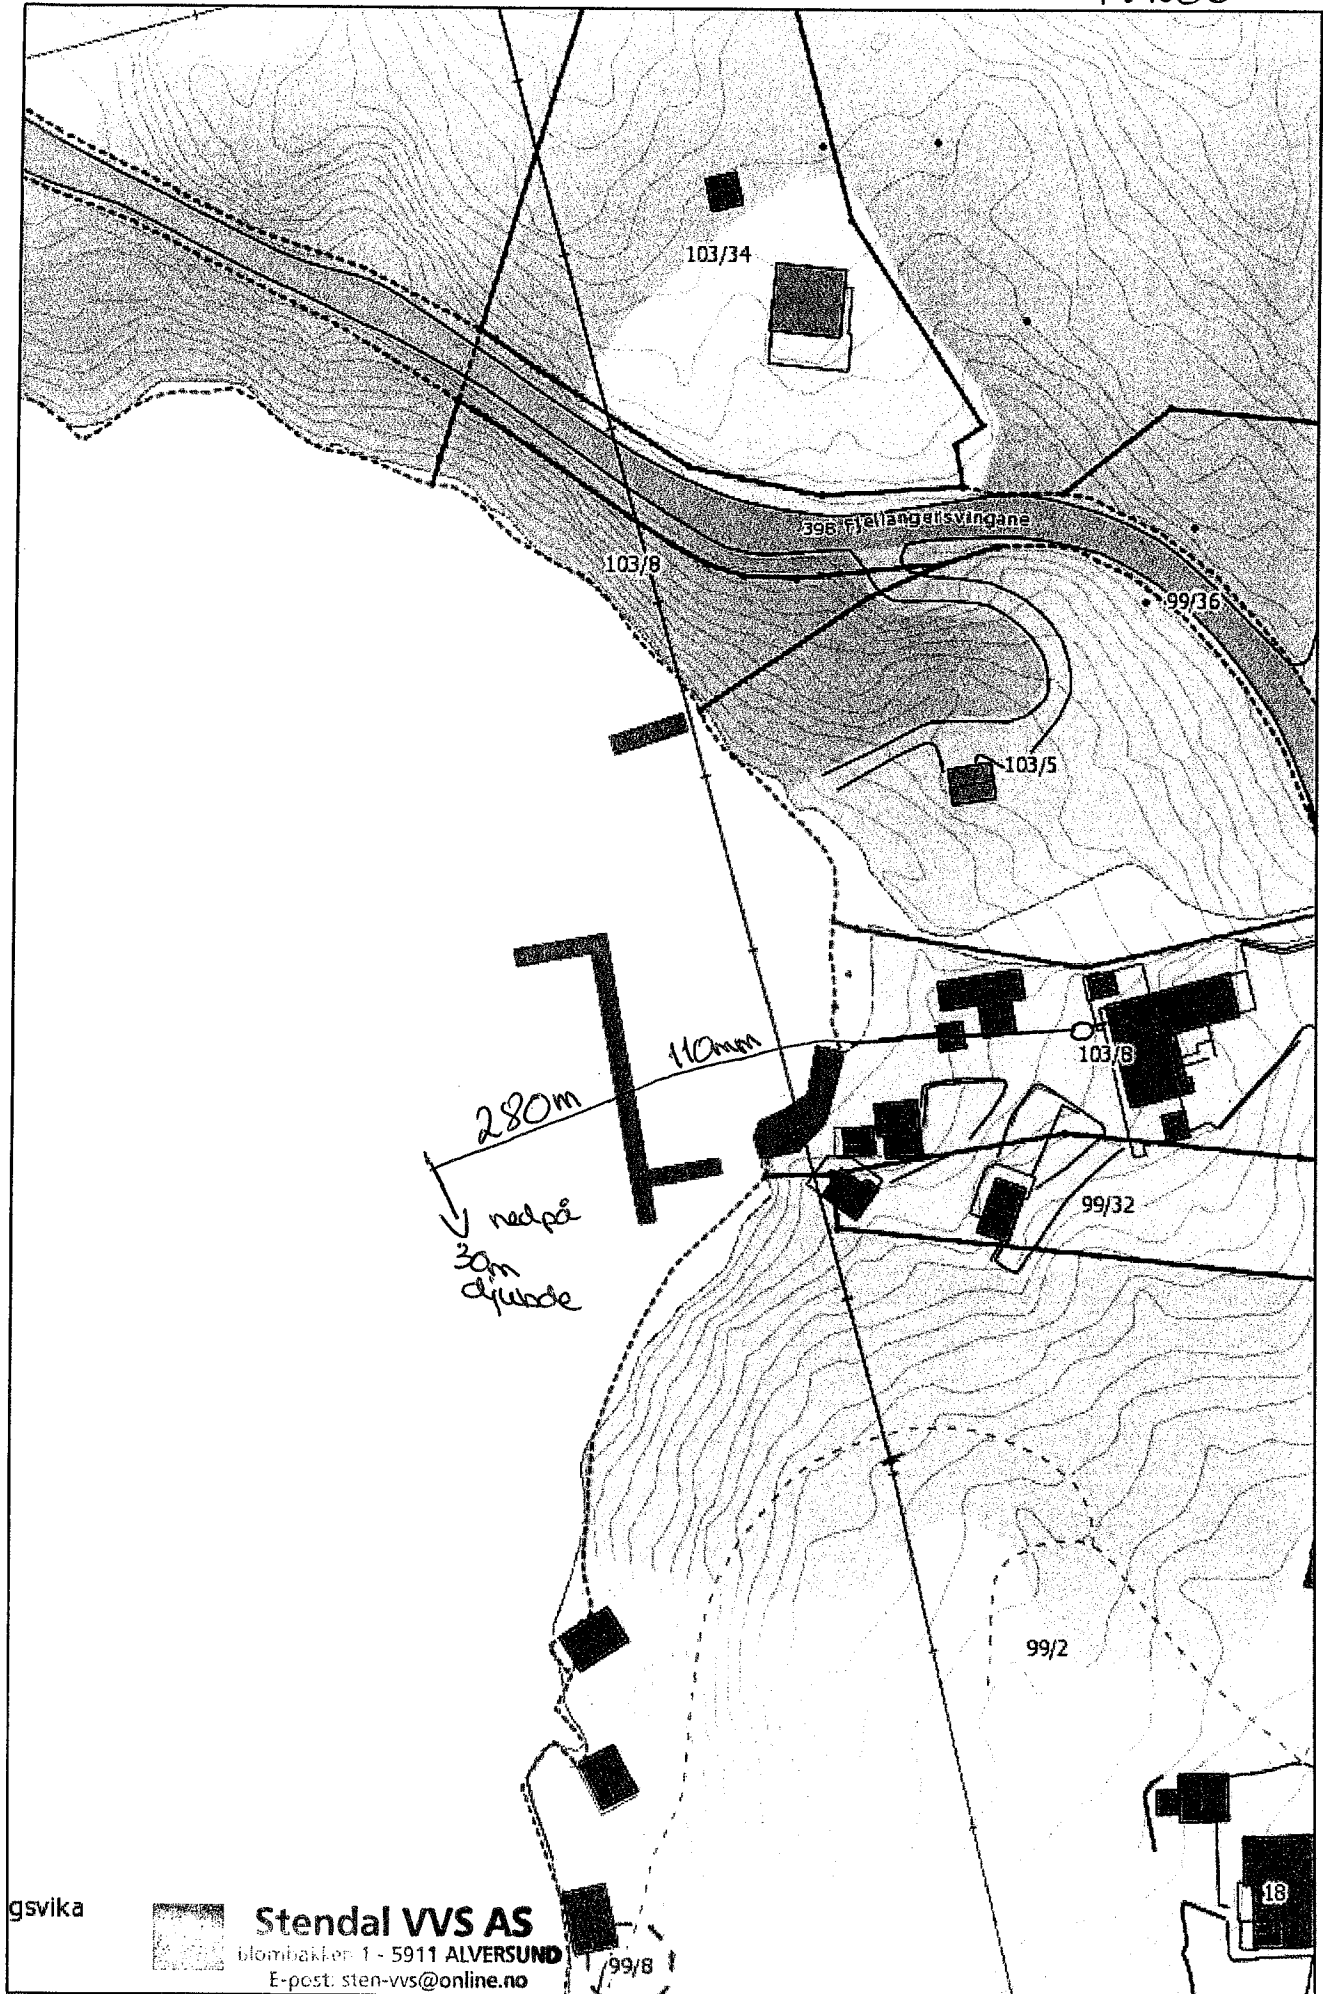

gsvika



Stendal VVS AS

blombakken 1 - 5911 ALVERSUND

E-post: sten-vvs@online.no

Org.nr. 980 626 180

99/8