



Syd.

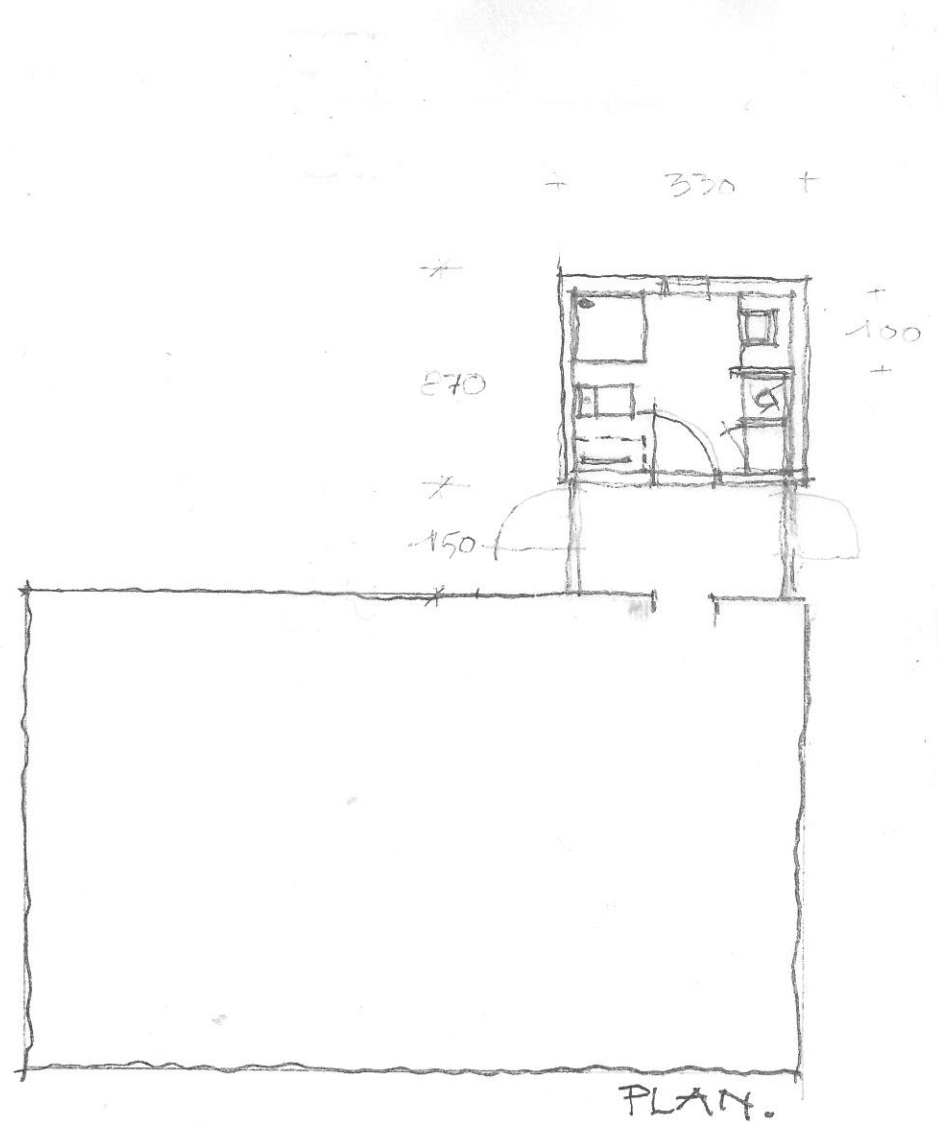


PLAN.

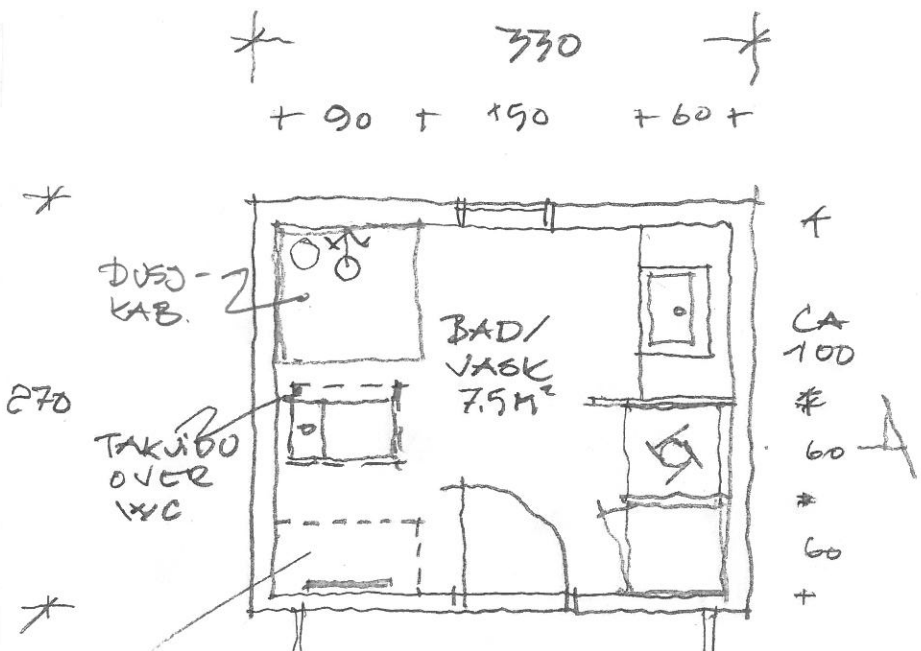

TØRKESTAV  
FOR KLÆR M.  
PANEL OCH  
UKDØR.  
ALT.-HØYSKAP.

PLAN M 1:50.

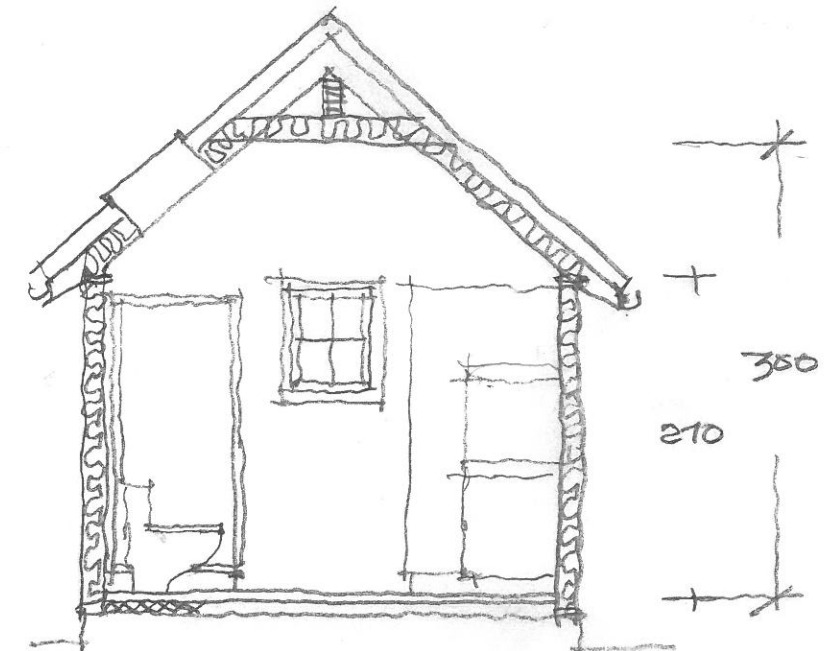

SNITT M 1:50.

TUA. GNR. 239. BNR. 15. 02.  
SKISSEPROSJEKTIL  
BADEHUS M 1:100.

REVISJON BADEHUS 13.05.06.  
BIV.ARK. E.MØRK. TLF. 41087748. 03.0516