


# GRUNNPLAN

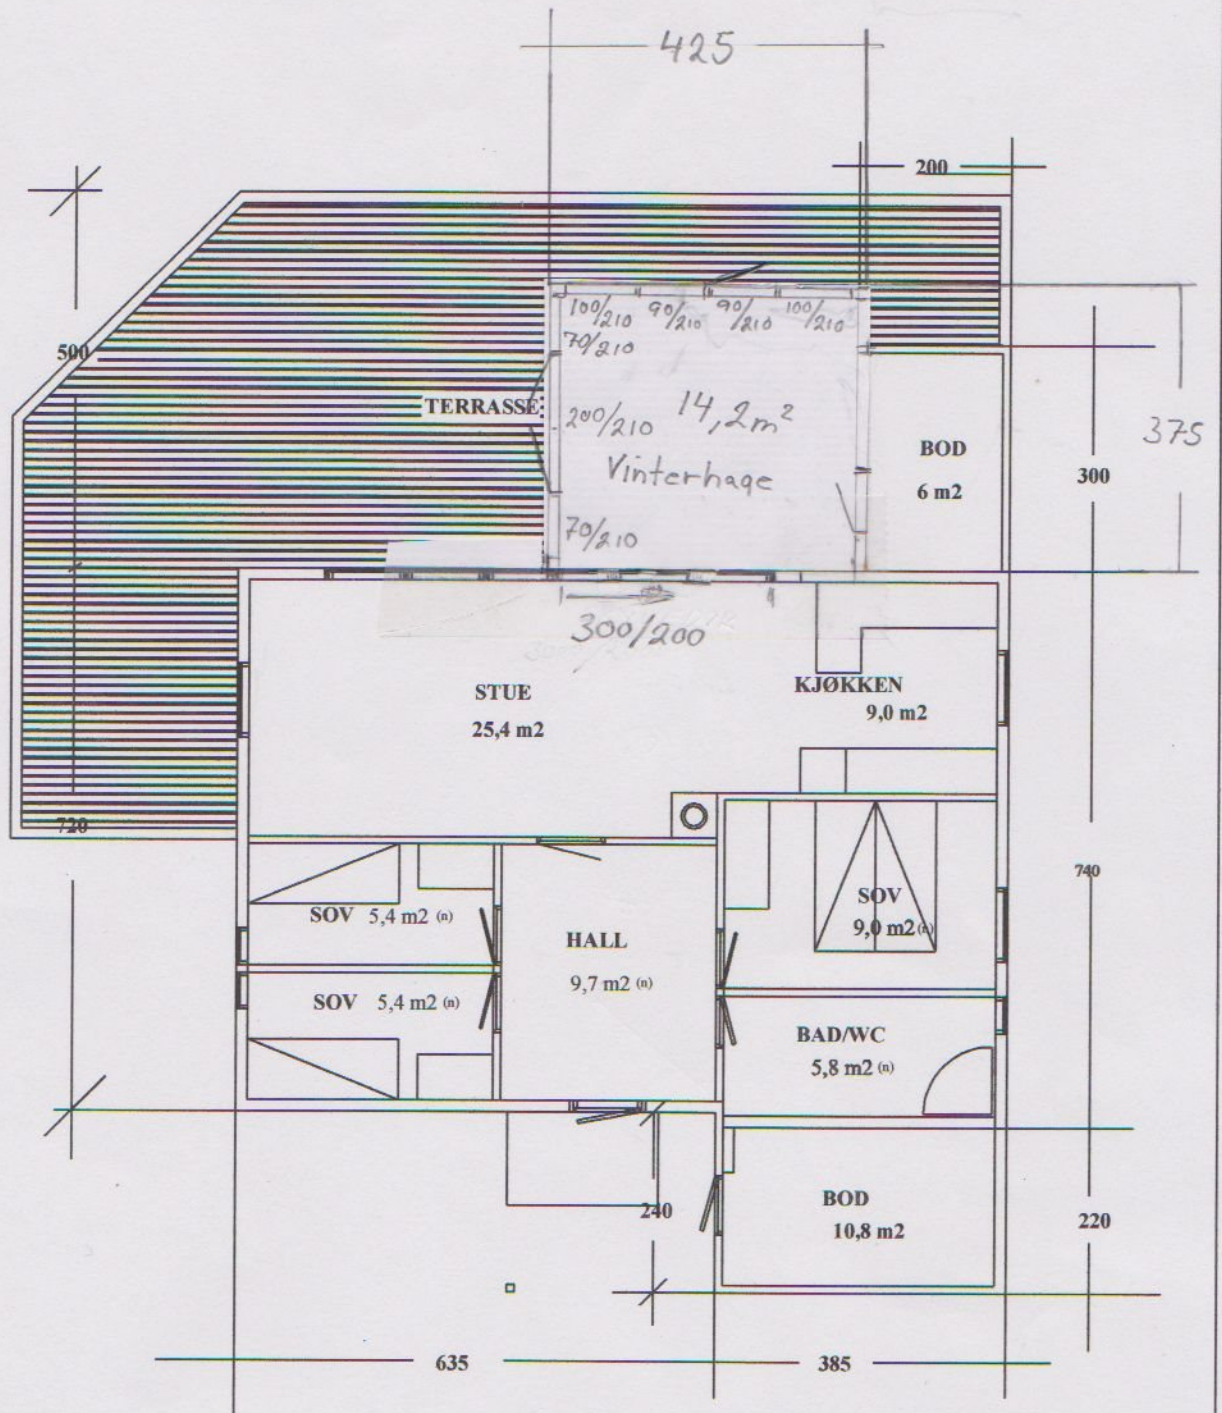

BRUTTO AREAL INKL BODER: 88,6 m<sup>2</sup>

VINTERHAGE 14,2 m<sup>2</sup>  
 NYTT BRUTTOAREAL INKL BODER 102,8 m<sup>2</sup>

LINDÅS, GNR 10 BNR 53  
 BOLIG FOR ELIN HAUGE  
 PLAN  
 M 1.100

BERGEN 17.11.03 J. R. AASEN