


Vedlegg 5.

12-May-2014

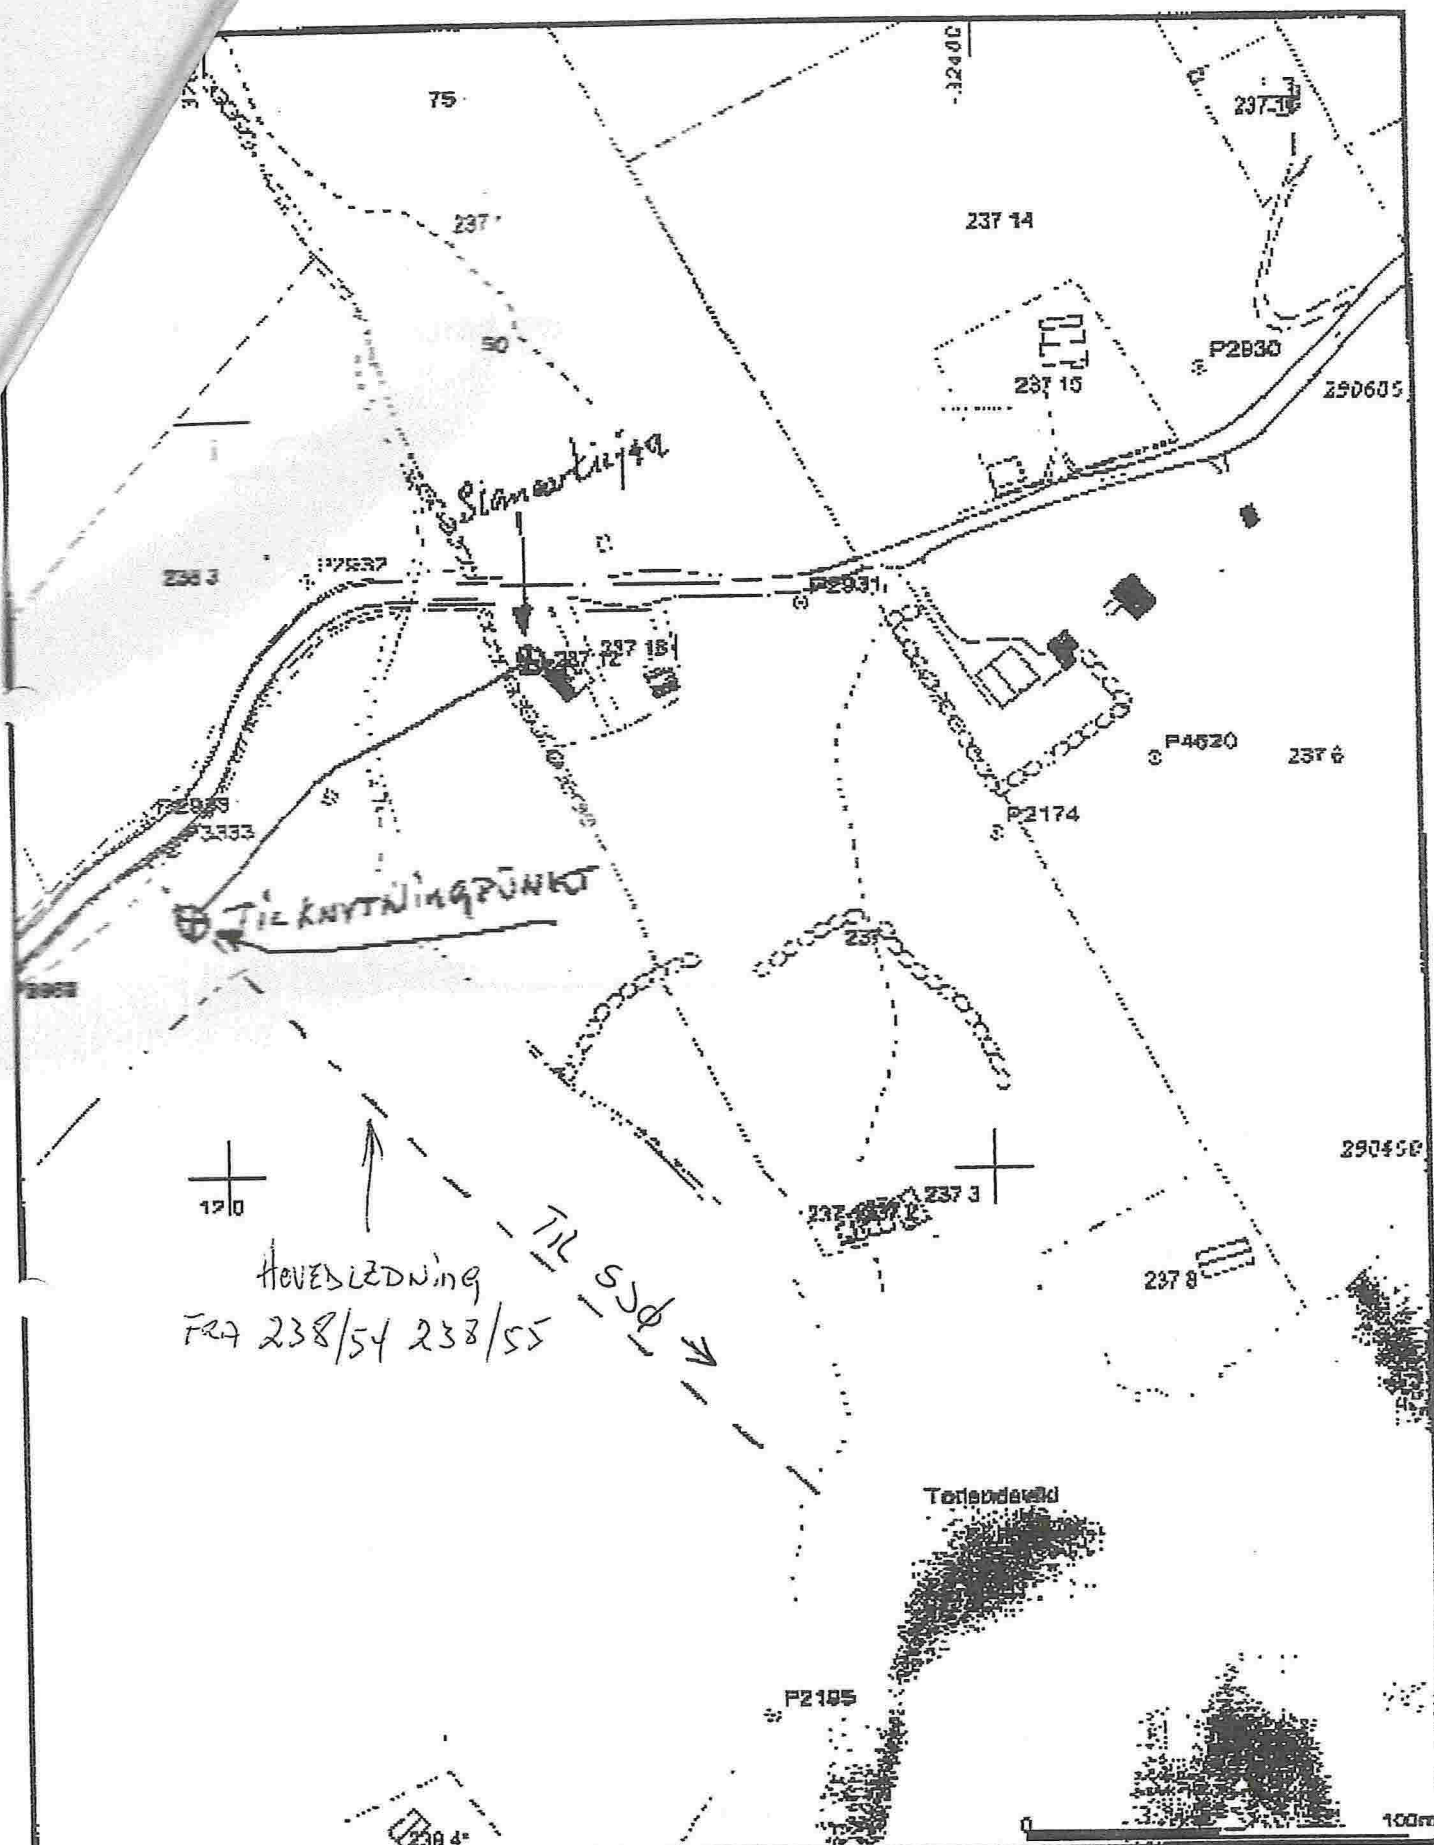

- | | |
|-----------------------------|-------------------|
| — Måle Grenser | — Våningdrus |
| — Raskvælte Grenser | — Stene busader |
| — Udegrenser | — Hytte/leirhus |
| • Tørringsmåle grenser | — Gressjett/uller |
| .. Kinnale uten grensepunkt | — Indre/lager |
| — Bølg | — Asen: bygg |
| • 1/4 ferske målestreker | |



Lindås kommune
Areal- og miljøavdeling

Tettland

Dato: 2005.03.25
Skala: 1:500

gnr237, bur 7



Skala: 1:2000