

SITUASJONSPLAN


GNR.137 BNR.217 , ALVERFLATEN, LINDÅS KOMMUNE

OK GULV BYGG 1: KOTE 55,2

OK GULV BYGG 2: KOTE 54,2


FOR TERRENGSNITT SE TEGNING 28312141A11-12

05.02.14


DATE/SIGN	RILI/BOLIG & EIENDOM	REVISION/DATE:	
	FLEIRMANNBOLIGER ALVERFLATEN	PROJECT NO.: 2012141	
REV. DESCRIPTION	SITUASJONSPLAN	DRAWING NO.:	
		28312141A10	
A UTVIDELSE TERRASSER	 ARKOCONSULT AS, Postboks 103, 5291 Volest.f. Tel.: 56390003 - Fax.: 56191130 - Mob.: 93241511 Mail: post@arkoconsult.no - Org.nr.: 997089782 MVA	SCALE: 1:500	FORMAT: A3
		DRAWN: LAH	DATE: 06.11.2012
		CHECKED:	DATE:



FASADE VEST

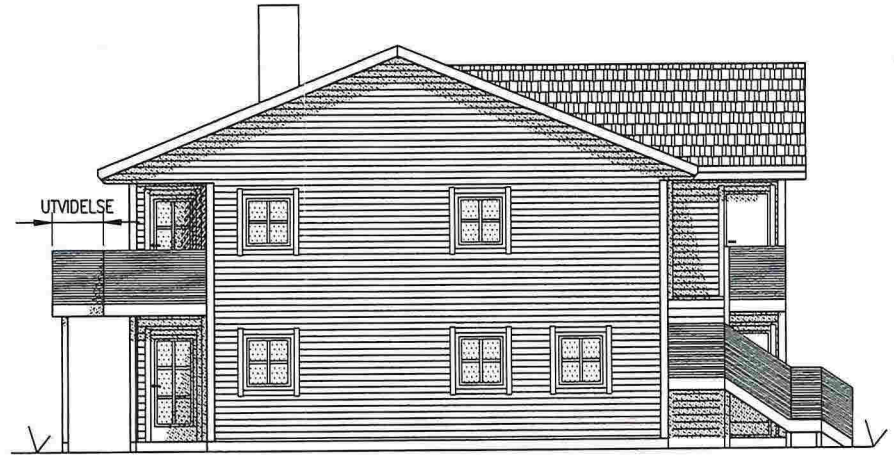

FASADE ØST

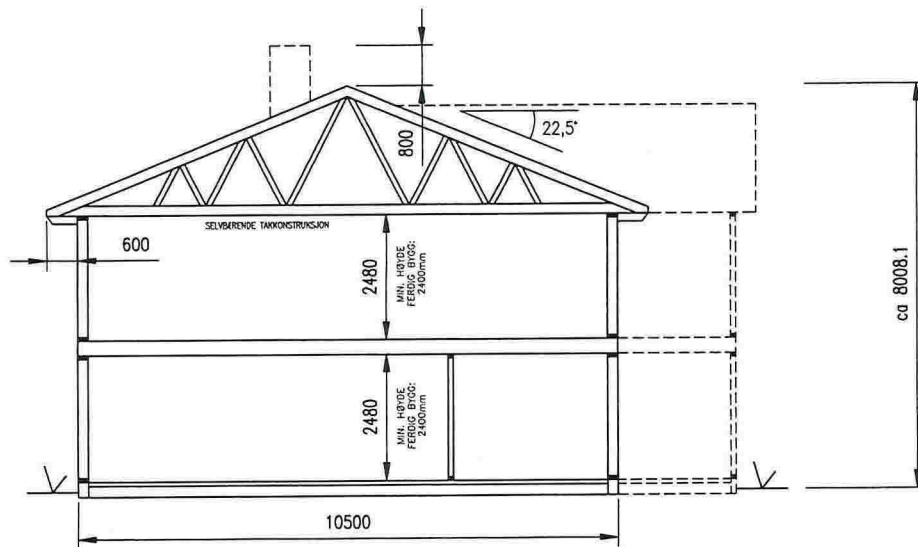


TYPISK SNITT


28.01.14/LAH	REVISION/DATE: C/28.01.14
25.02.13/PKT	PROJECT NO.: 2012141
02.11.12/LAH	DRAWING NO.: 28312141A03
DATE/SIGN	SCALE: 1:100
	FORMAT: A3
TERRASSER	DRAWN:
INNENDIG BOD	CHECKED:
VINDUER OG TRAPP ENDRET	DATE:
REV. DESCRIPTION	DATE:
<p>arkoconsult ARKOCONSULT AS, Postboks 103, 5291 Valest.f. Tel.: 56390003 - Fax.: 56191130 - Mob.: 93241511 Mail: post@arkoconsult.no - Org.nr.: 997089782 MVA</p>	



FASADE NORD

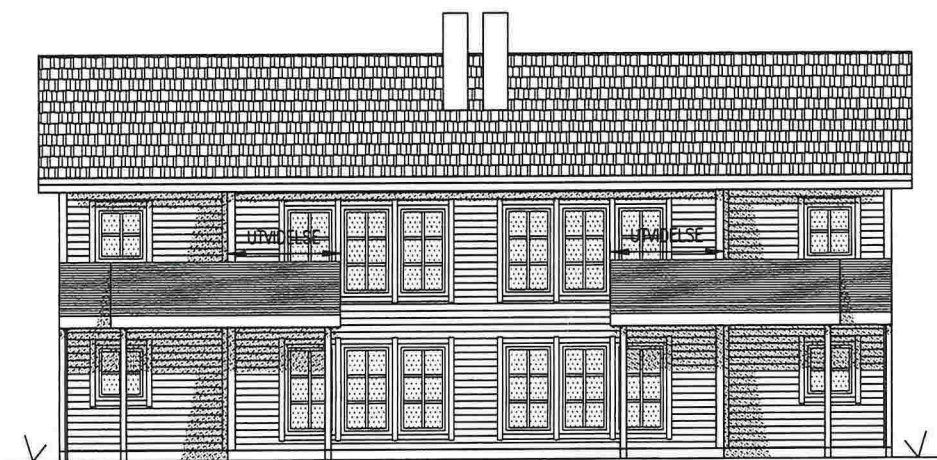

FASADE SØR

28.01.14/LAH	25.02.13/PKT	02.11.12/LAH	DATE/SIGN	RILI/BOLIG & EIENDOM	REVISION/DATE: C/28.01.14	
				4 MANN'S BOLIG ALVERFLATEN	PROJECT NO.: 2012141	
				FASADER	DRAWING NO.: 28312141A04	
C TERRASSER	B INNVENDIG BOD	A VINDUER OG TRAPP ENDRET	REV. DESCRIPTION	 ARKOCONSULT AS, Postboks 103, 5291 Valest.f. Tel.: 56390003 - Fax.: 56191130 - Mob.: 93241511 Mail: post@arkoconsult.no - Org.nr.: 997089782 MVA	SCALE: 1:100	FORMAT: A3
					DRAWN:	DATE:
					CHECKED:	DATE: