


E 293130

N 6720540

N 6720510

N 6720480

HPKT1

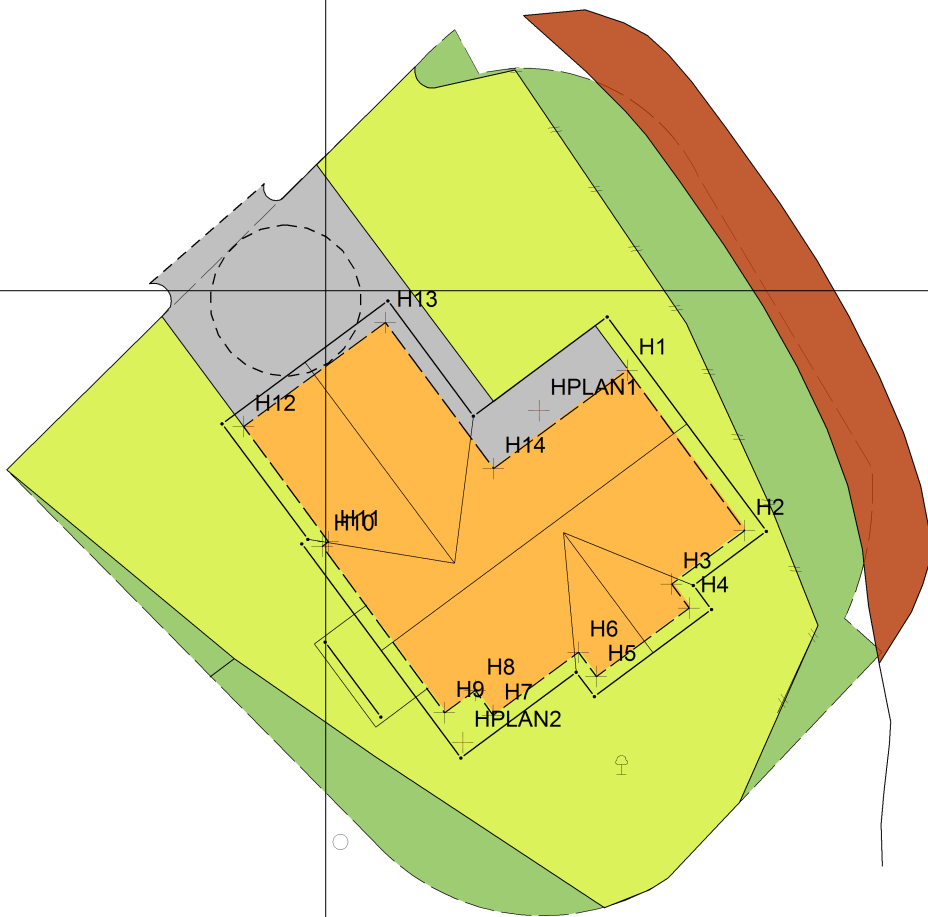

Gnr. 134 bnr. 449  
INNMÅLT GRUNNMUR  
25.09.2015  
Målestokk 1:300  
Medaas Oppmåling