



Plan 1 etasje 1:100

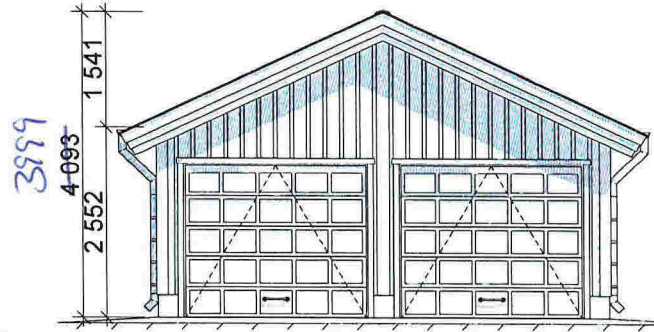


Fasade 1 1:100

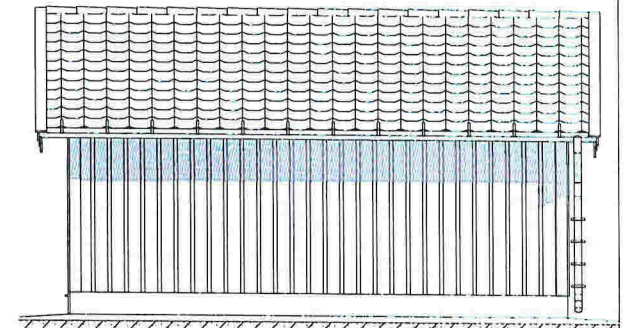


Fasade 3 1:100


BRA
35,9 m²
BYA
39,6 m²

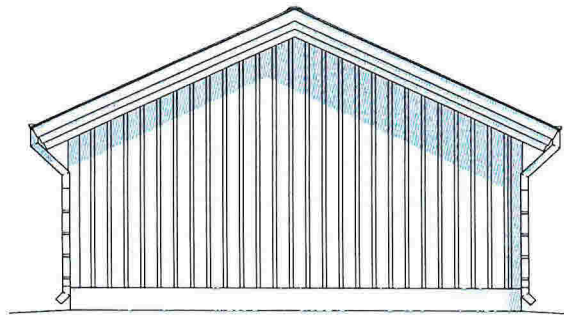

Fasade 2 1:100

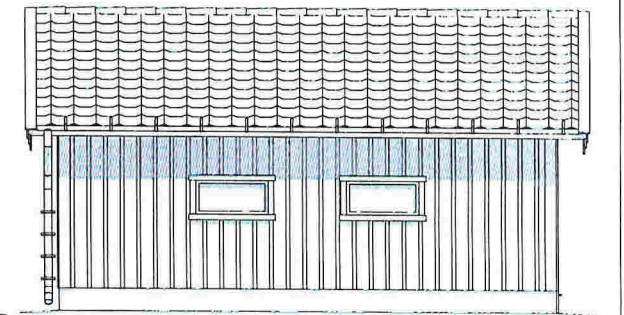

Fasade 4 1:100

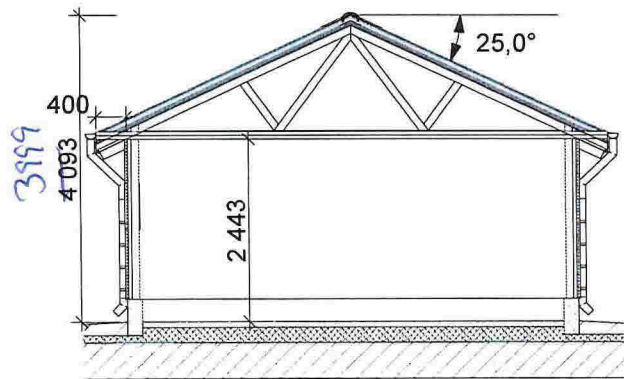

Snitt 1:100

Byggemeldingstegning



HEIMDALL 6000x6600

Målestokk:
1:100