


rev 8.8.16 fjernet trapp

Plan, snitt garasje 1:50


Åge Nilsen

06.07.16 P.K


Rev 21.04.16 senket takvinkel

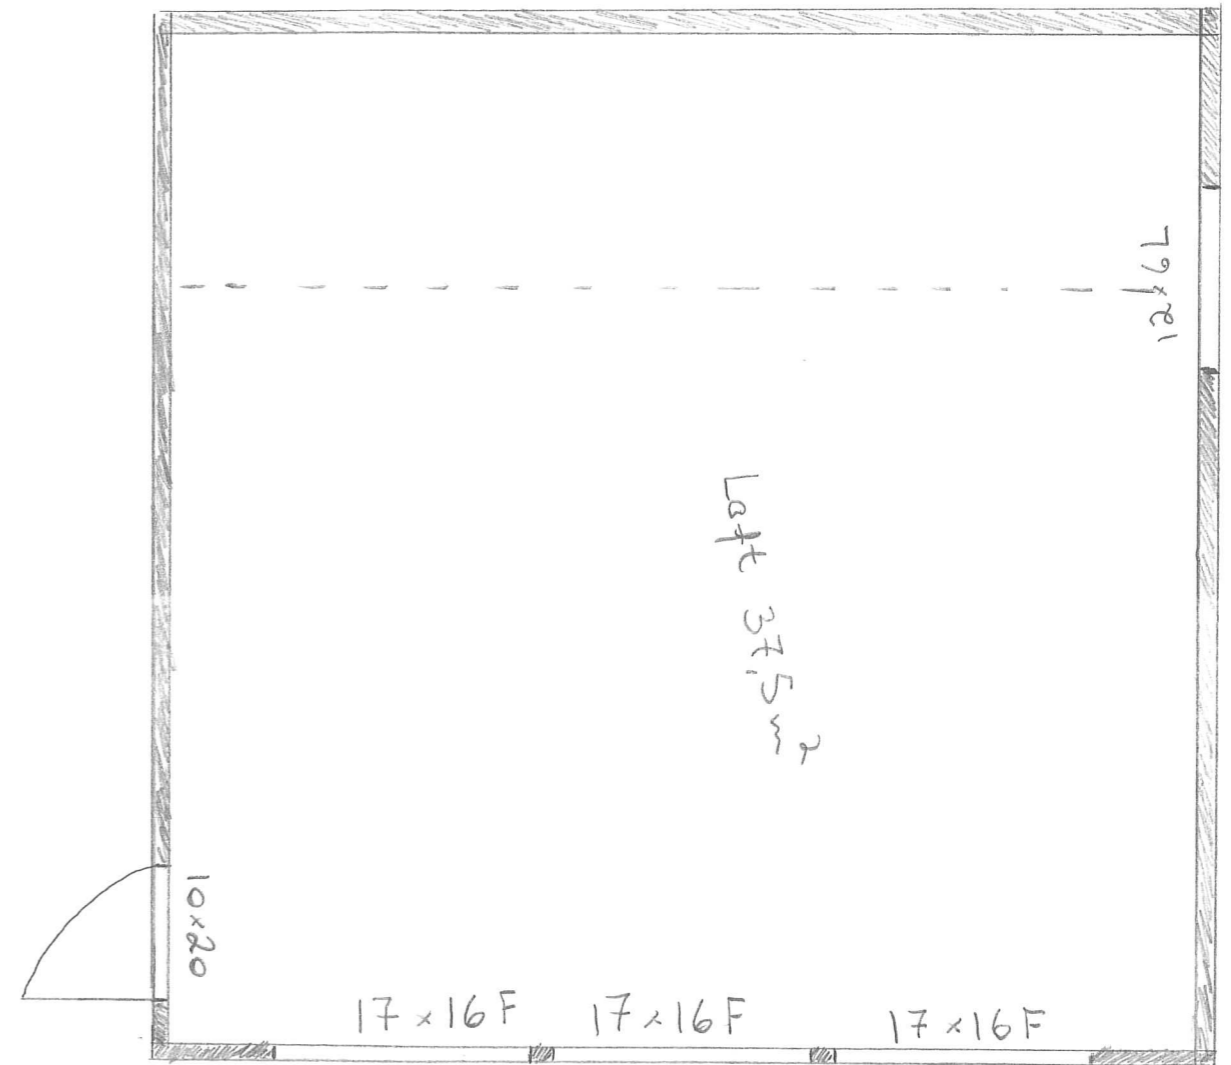

Plan loft Garasje
Åge Nilzen 06.04-16 R.K
Mål 1:50

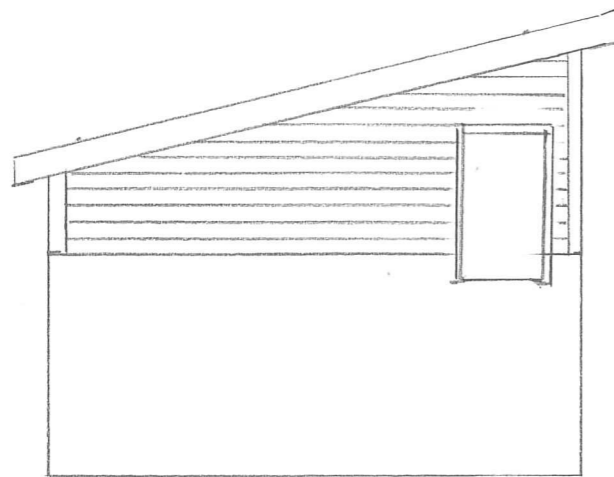


Fasade Øst

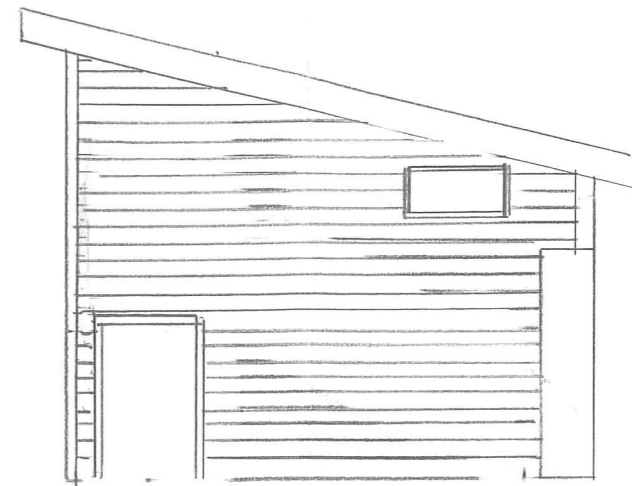

Fasade Vest



Fasade Nord

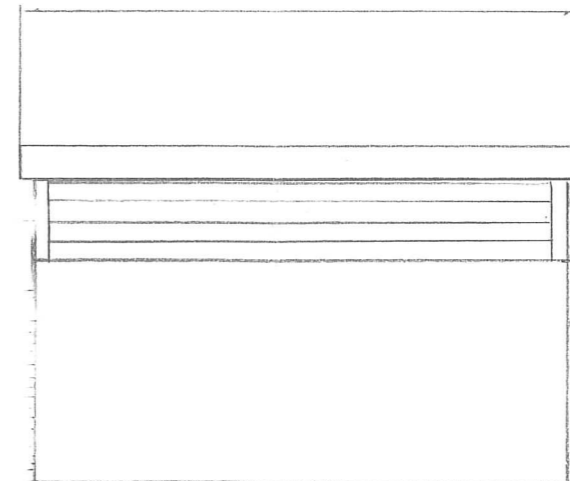

Fasade Sør

rev 8.8.16 flyttet dør 2.etg

rev 17.06.16 fasade Nord

Fasade garage 1:100

Åge Nilsen 06.08.16

Nedre Mangerhus 10

G/Bnr 137/748