
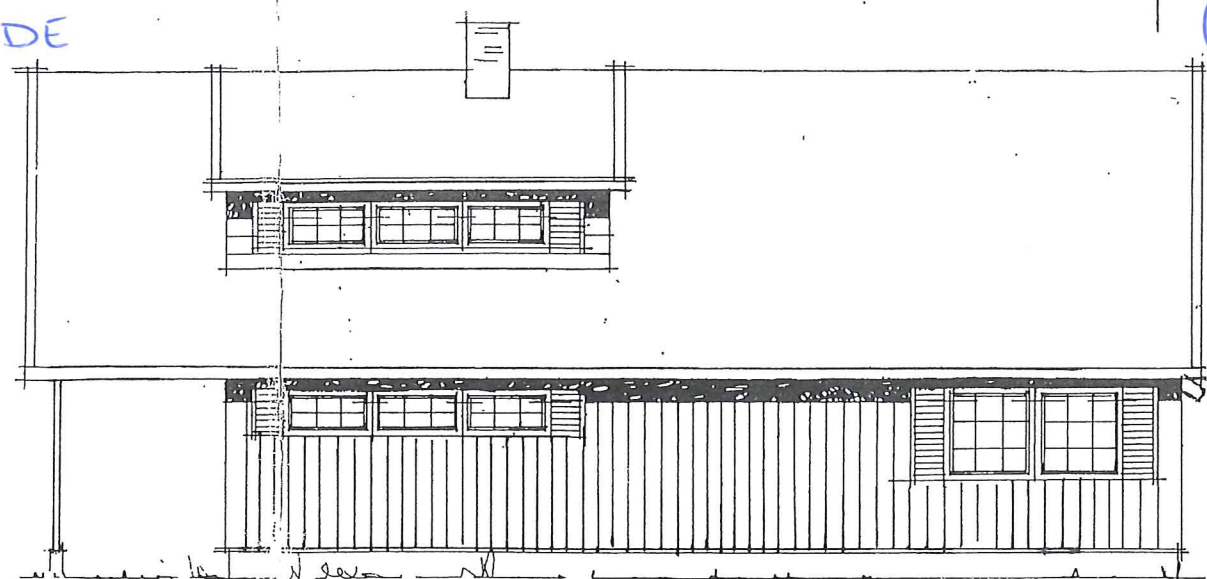




EKSISTERENDE FASADE

E

Denne tegning er A/S Byggstandard sin eiendom; og må hverken helt eller delvis kopieres (jmr. lov om åndsverk);

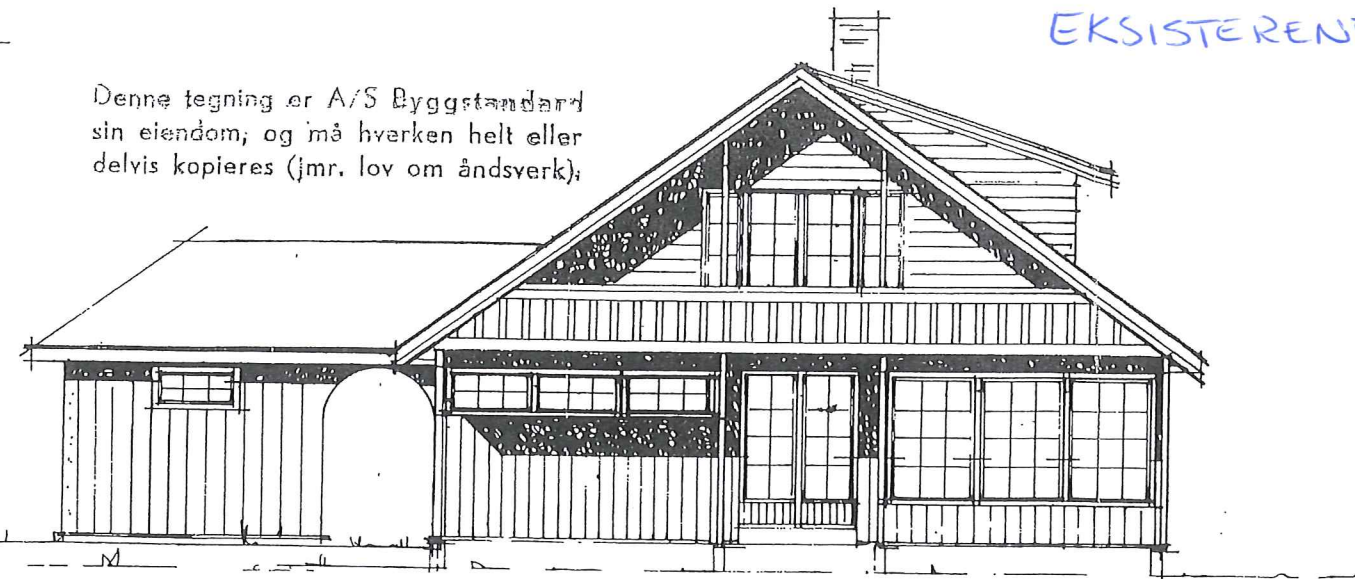


990

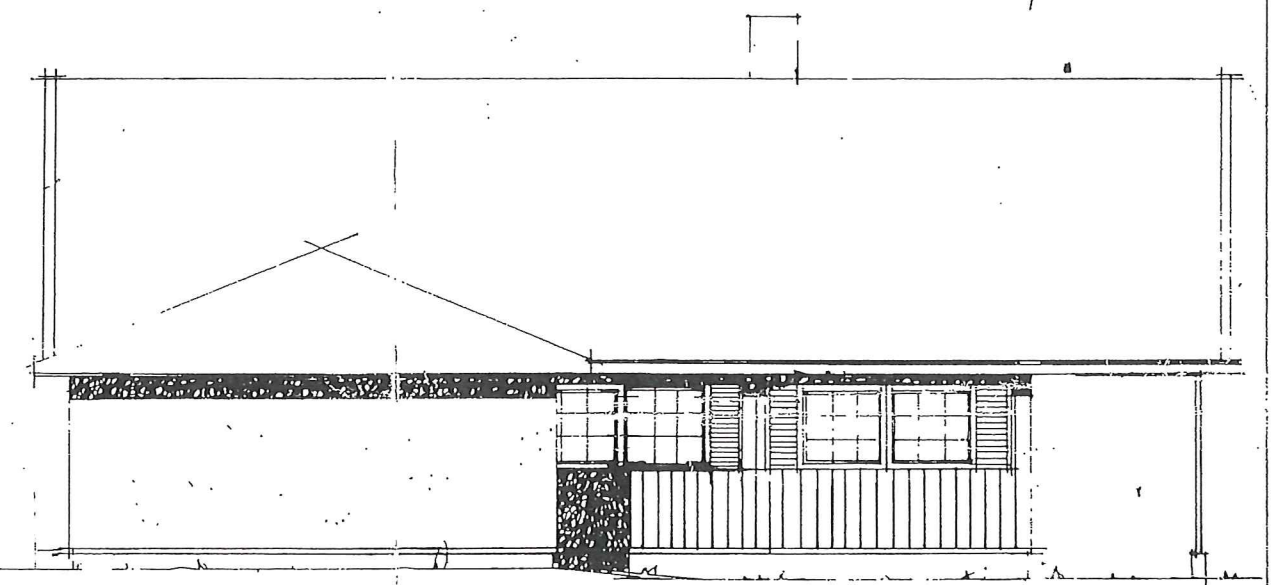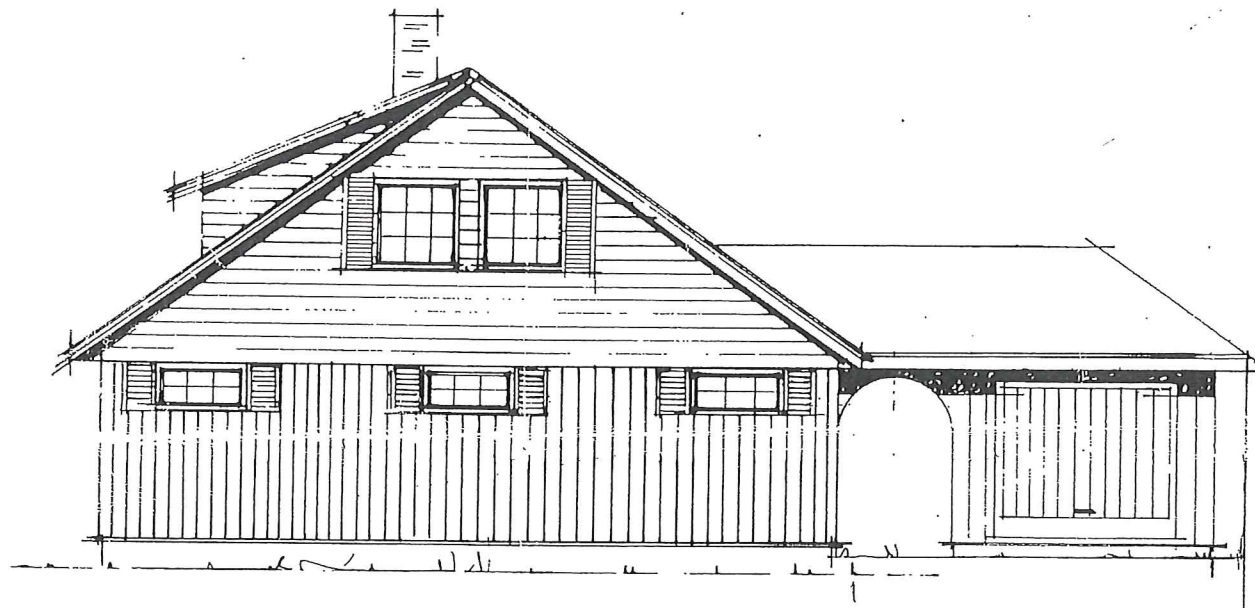

1290

1287



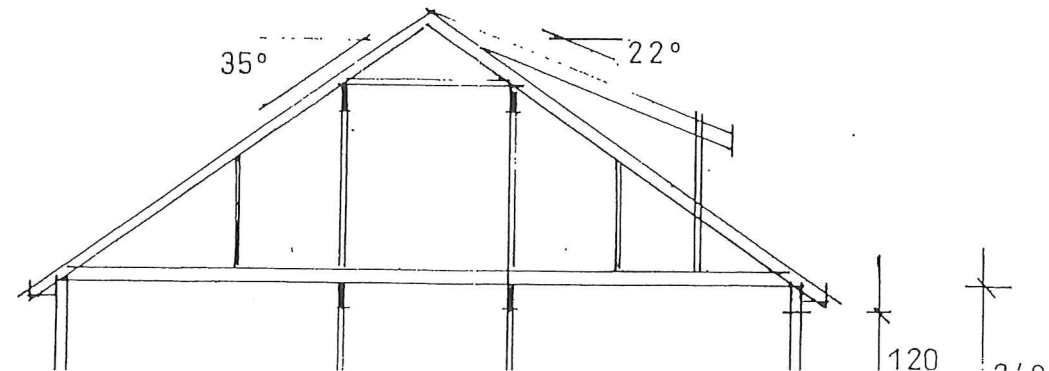


ARKIV

HAND
BYGNINGS
01

LINDÅS KOMMUNE
TEKNISK ETAT



EKSISTERENDE PLAN

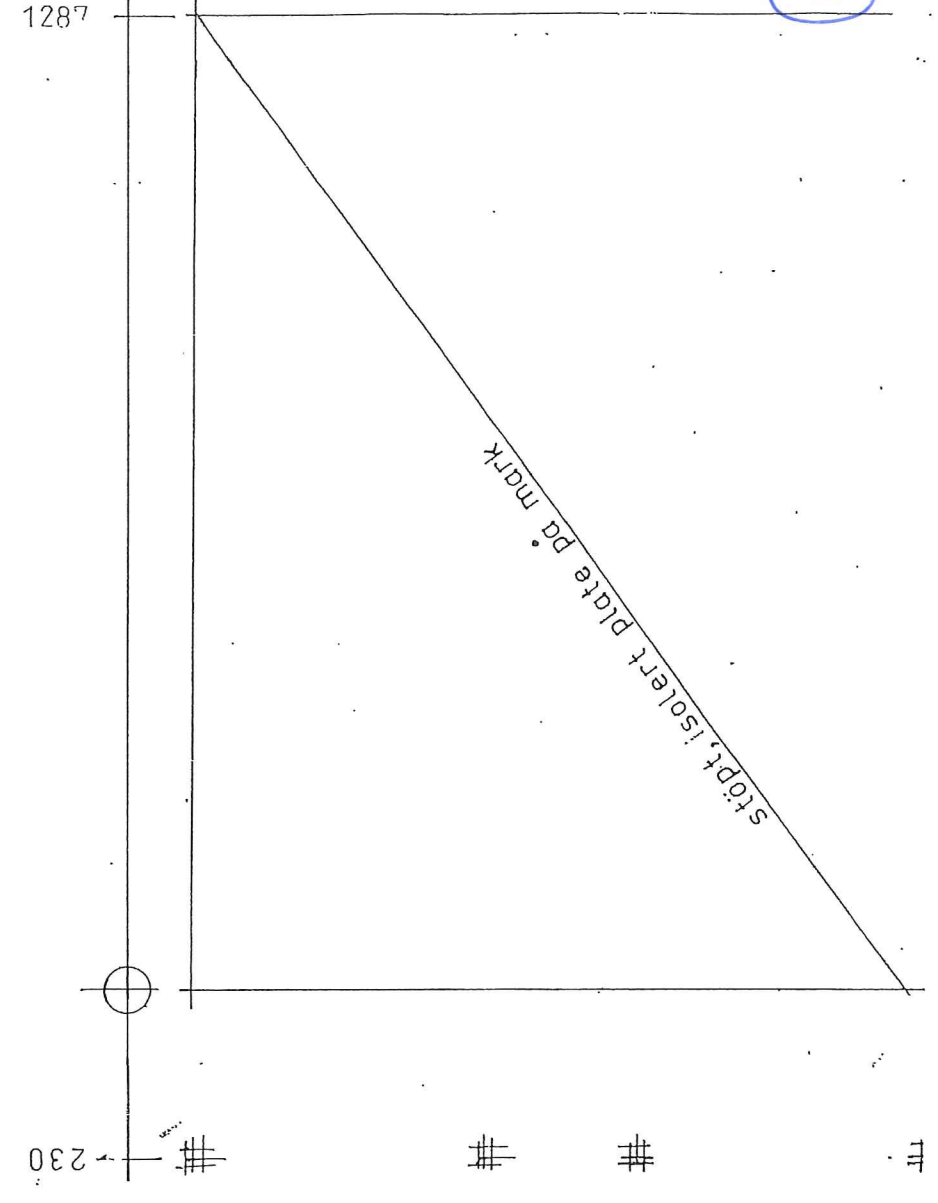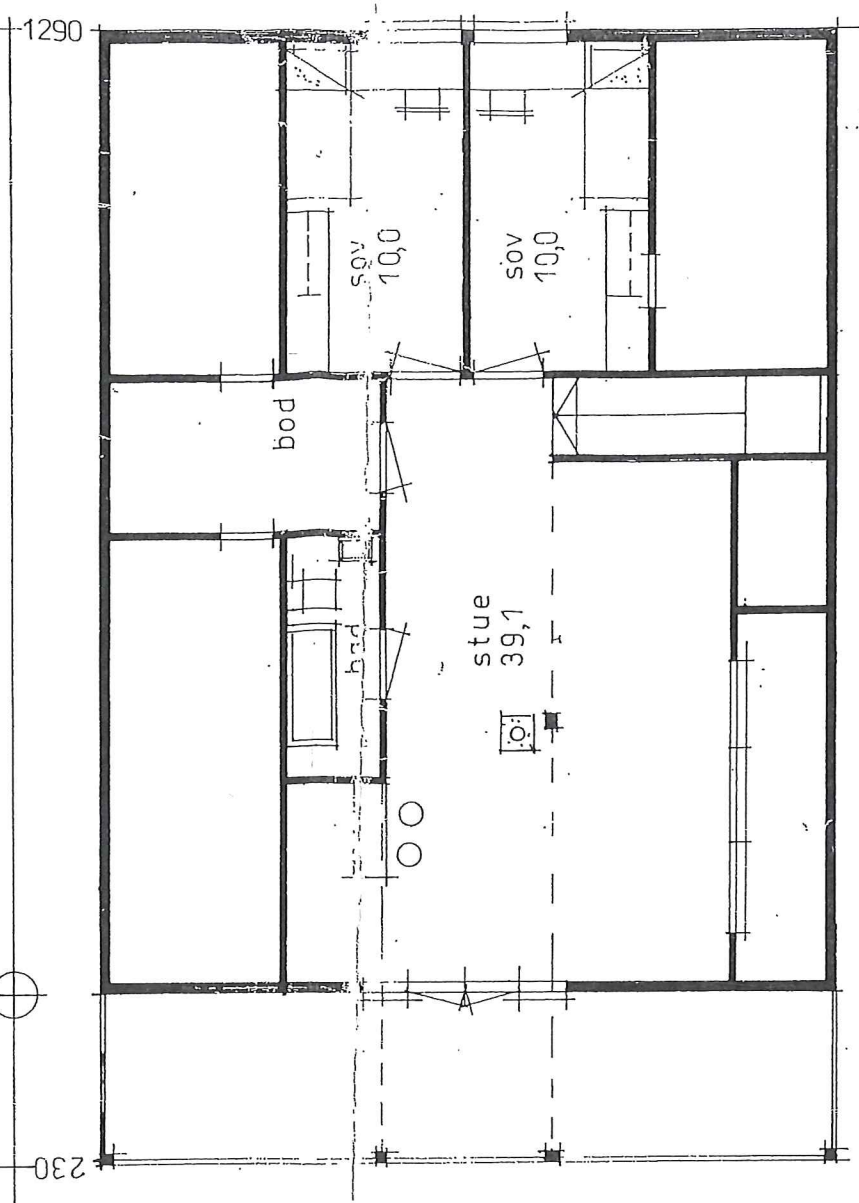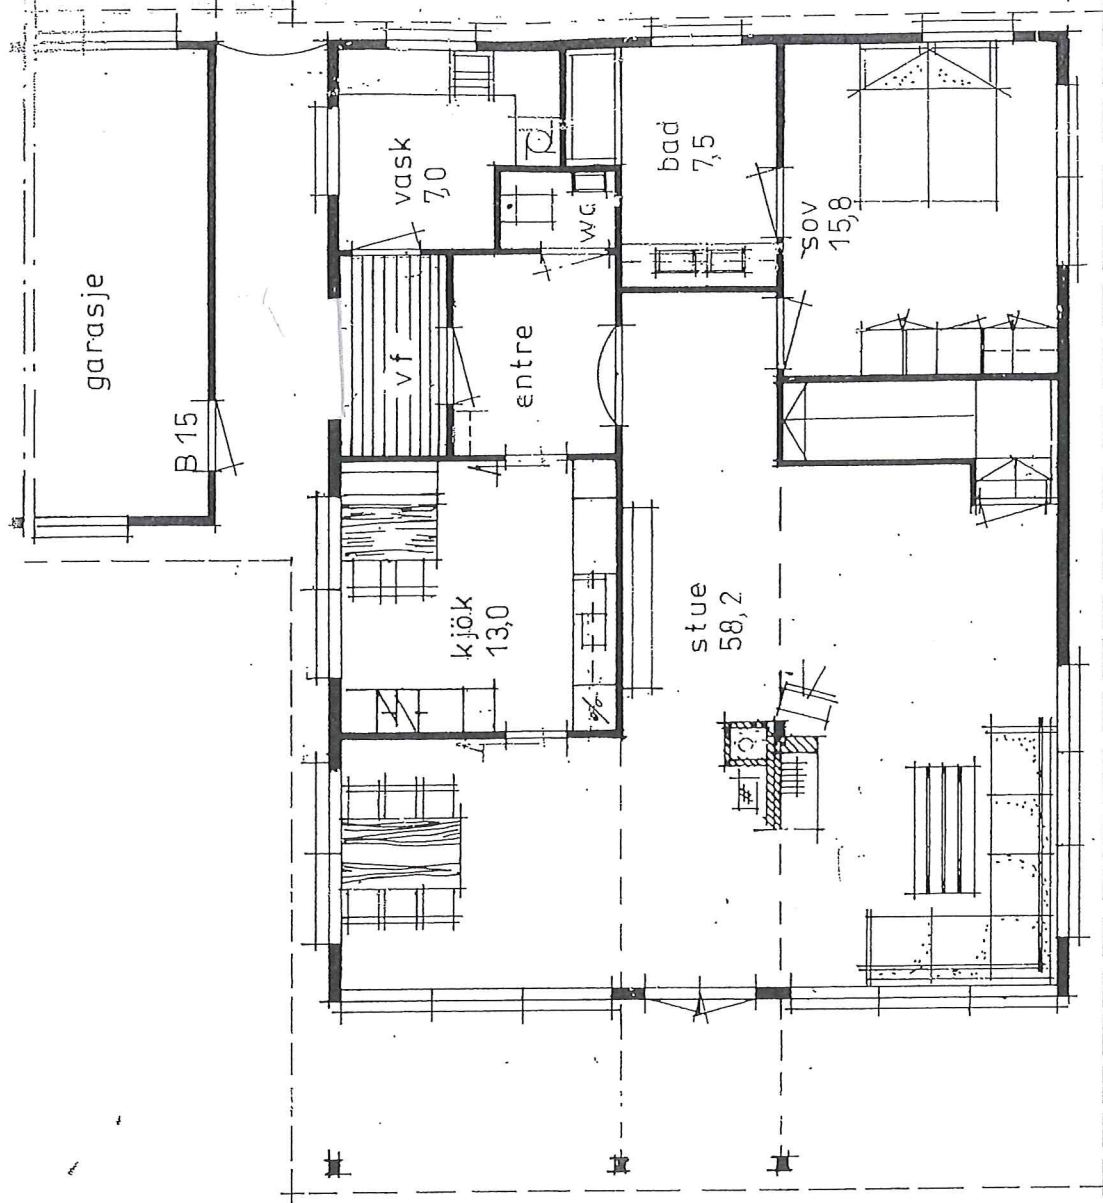

NY FASADE



E

Denne tegning er A/S Byggstandard sin eiendom, og må hverken helt eller delvis kopieres (jmr. lov om åndsverk);

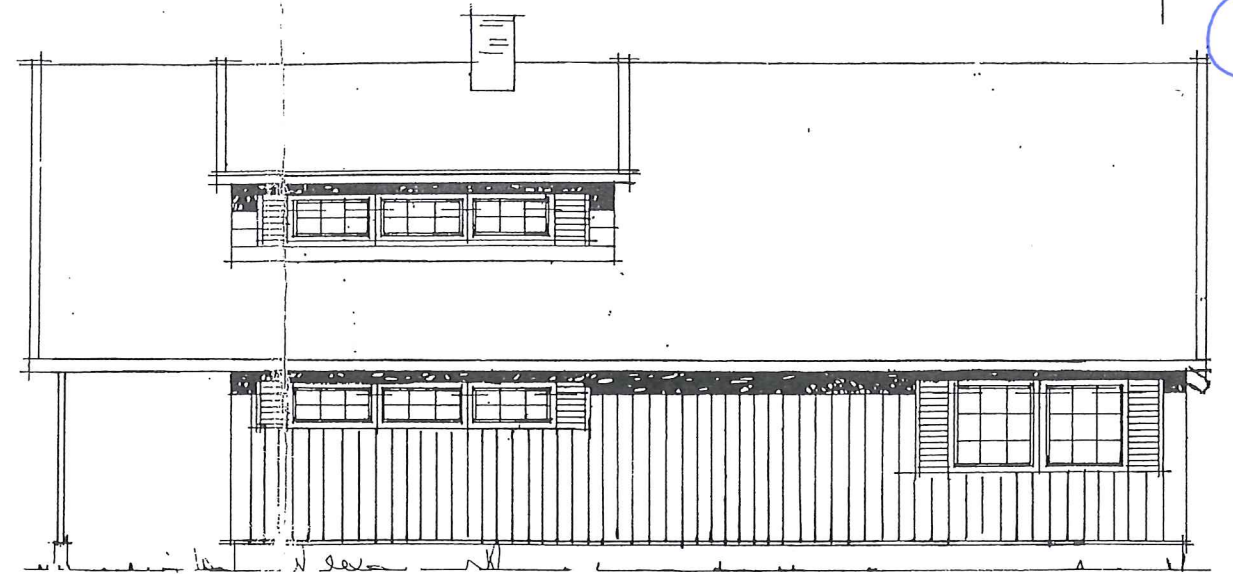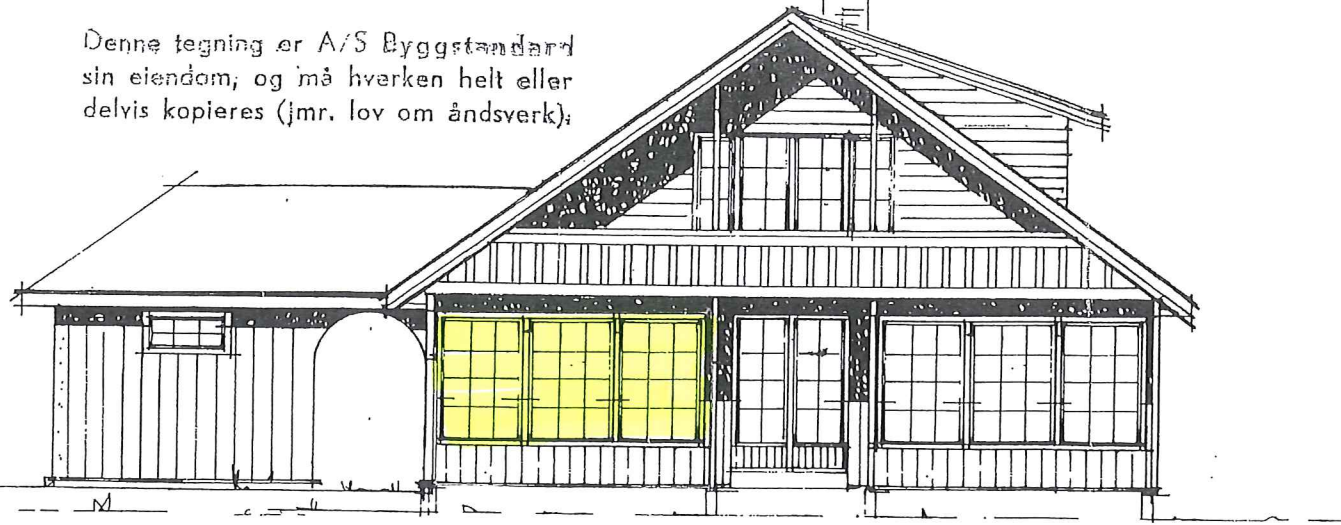


990

9.90
5.50
15.40

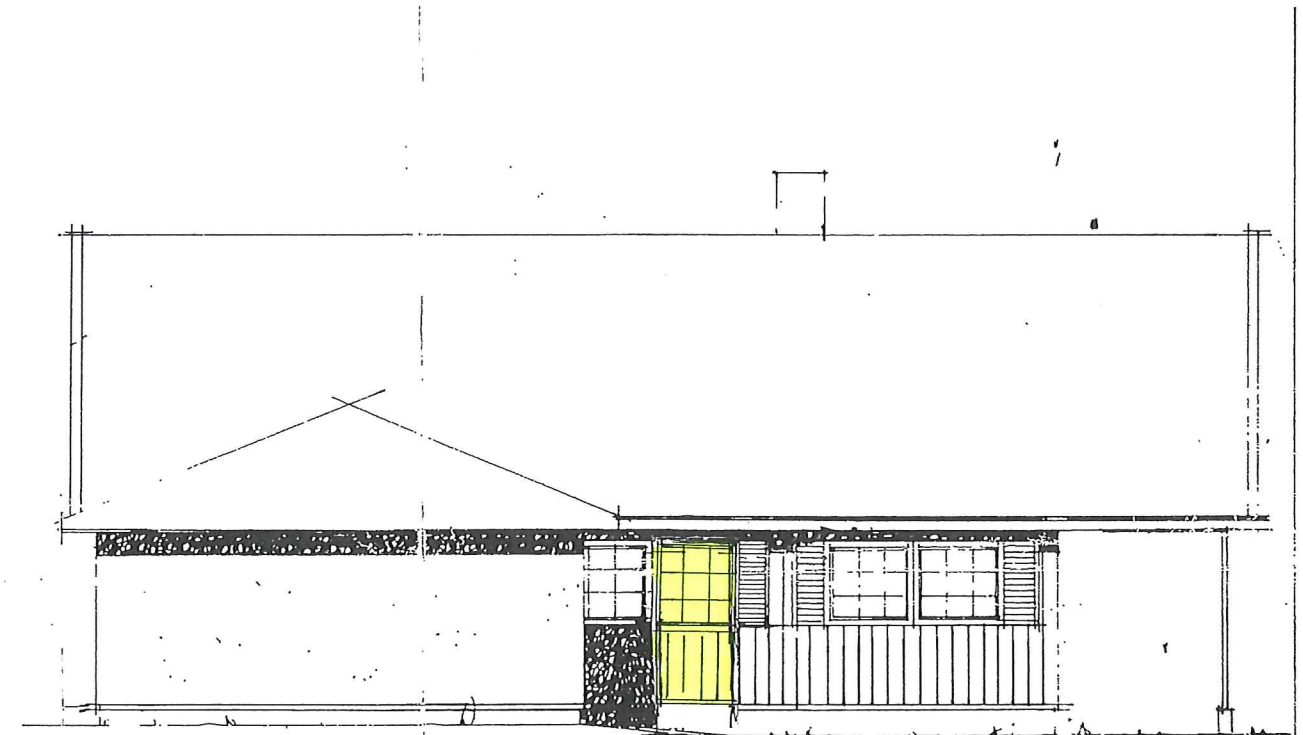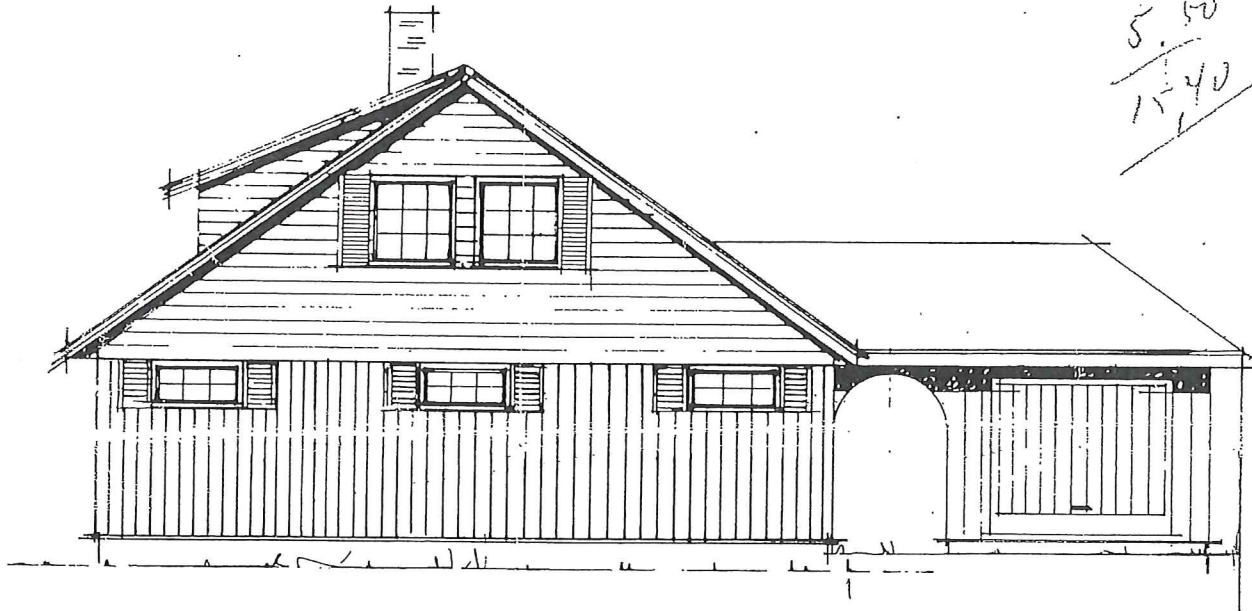

1290

1287

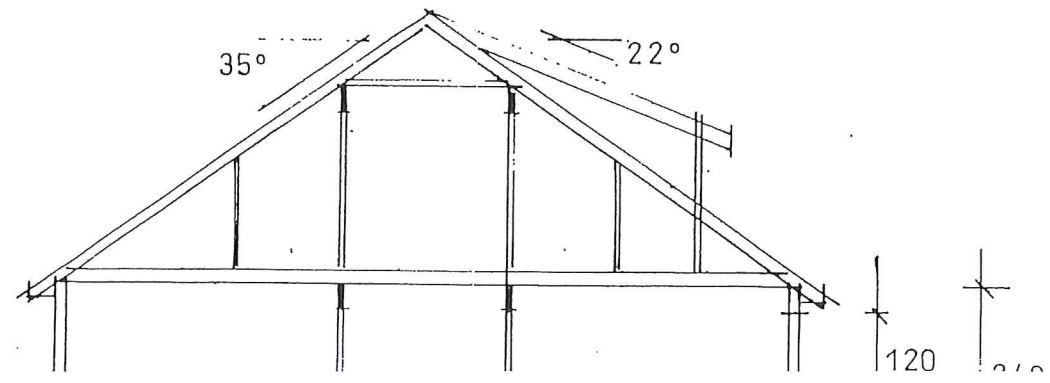

HAND
BYGNINGS

LINDÅS KOMMUNE
TEKNISK ETAT

ARKIV

