



Hovedplan
Braf 114 m²

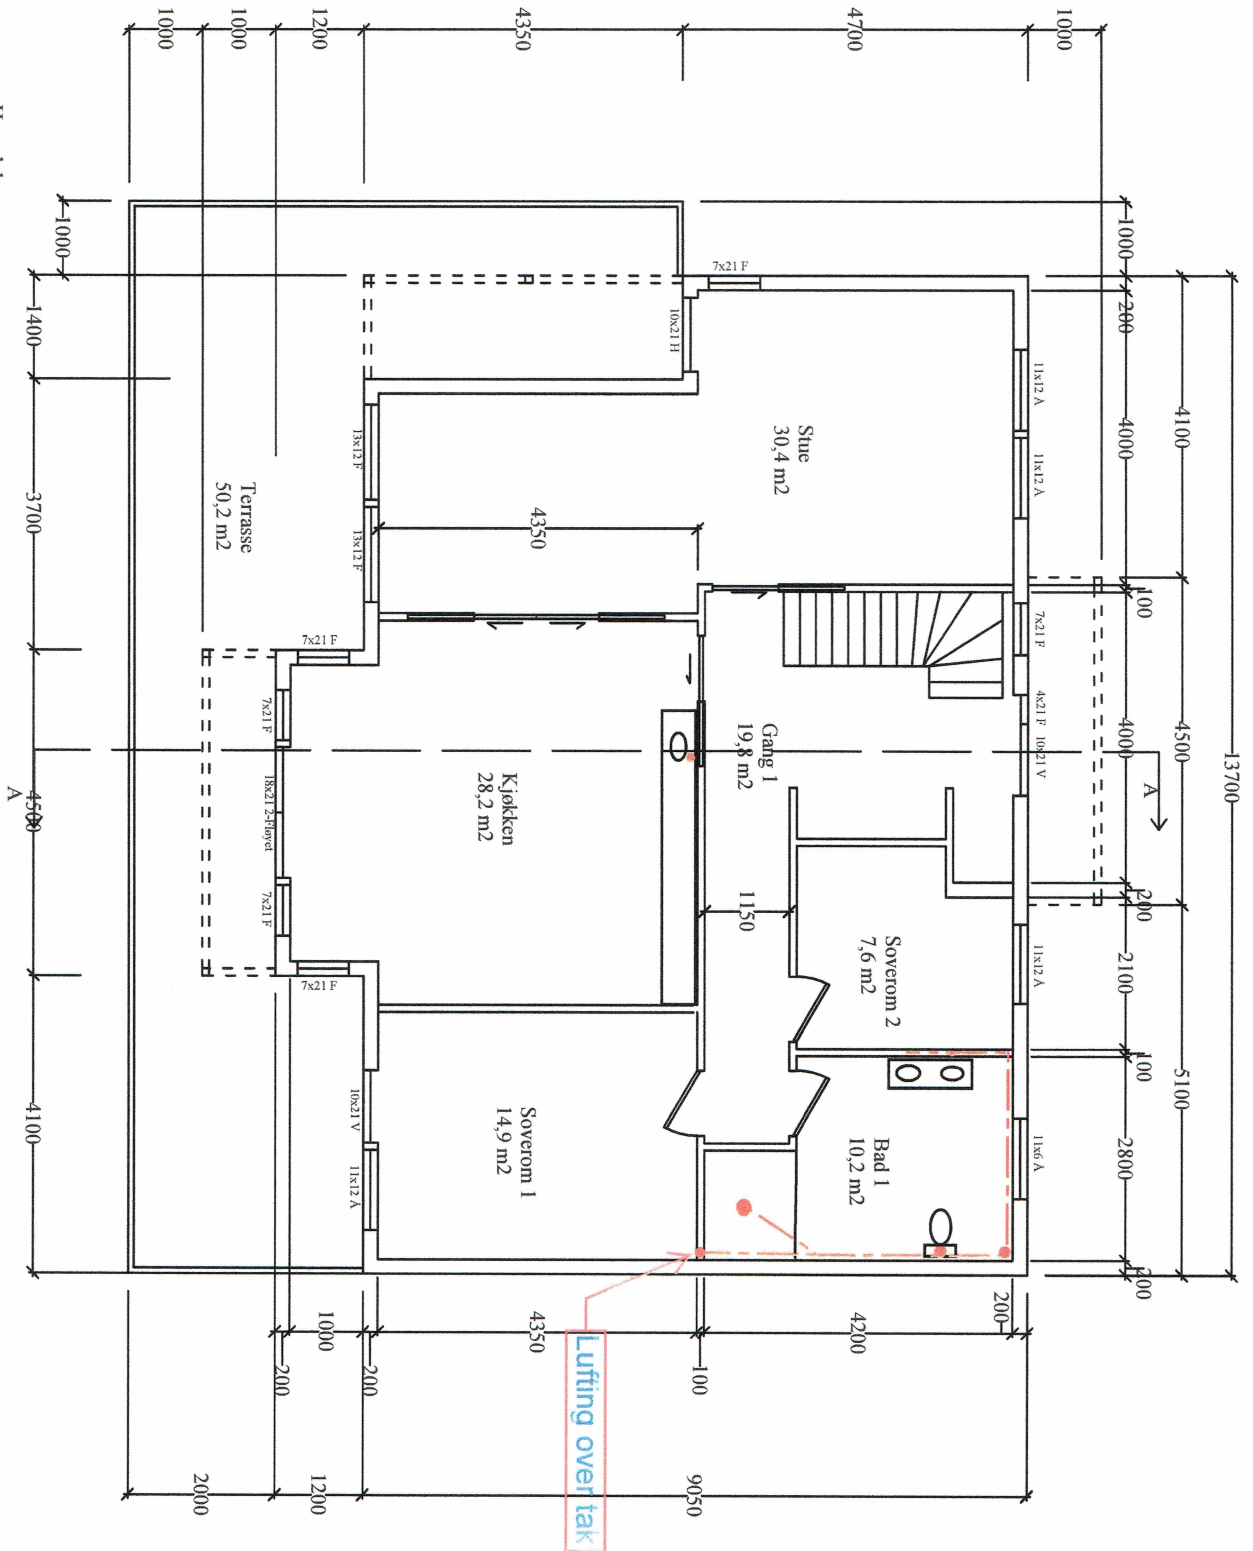

REV.	DATO	REVISJONEN GJELDER		SIGN.	
Dato:	10.11.2016	Konstr. /Tegnet	Gnr./bnr:	Målestokk:	Tiltakshaver:
Tittel:	Enebolig m/ garasje			1:100	Daniel Reknes
				Erstatning for:	Erstattet av:
Henvielse:		Beregning:		Format:	A4