



Plan 1.etg.

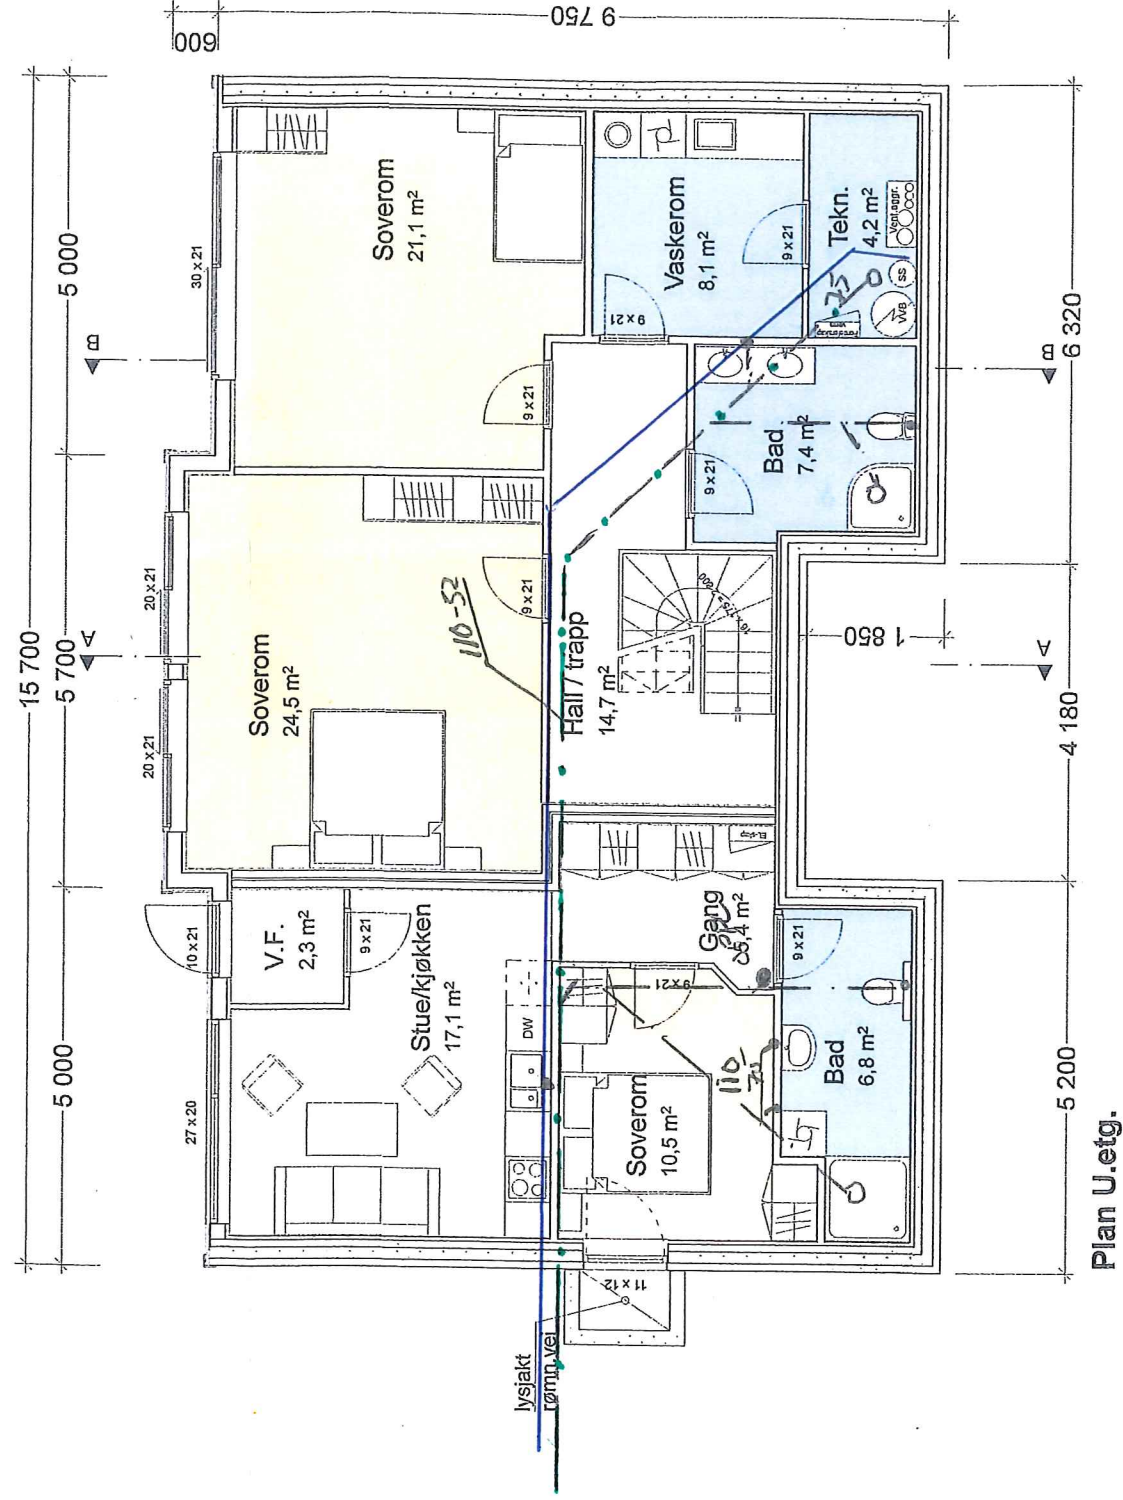


Plan U.etg.

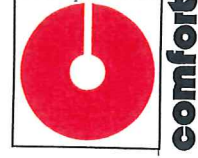


COMFORT KNARVIK
 AS Haugland VVS
 Lyngveien 2,
 5914 ISDALSTØ
 56 35 77 90
 knarvik@comfort.Las
 www.comfort.no

Rev.	Dato:	Rev. gjelder	Tiltakshaver:	Prosjekt:	Tegnet dato:	Målestokk:
			Sasa Misur	Helleåsen. Gnr.202, Bnr.161.	28.11.2016	1:100
				Tittel:	Prosjektnr.:	Tegningsnr.:
				Plan U.- og 1. Etasje	45716	A20-01
						Rev.

Aulap

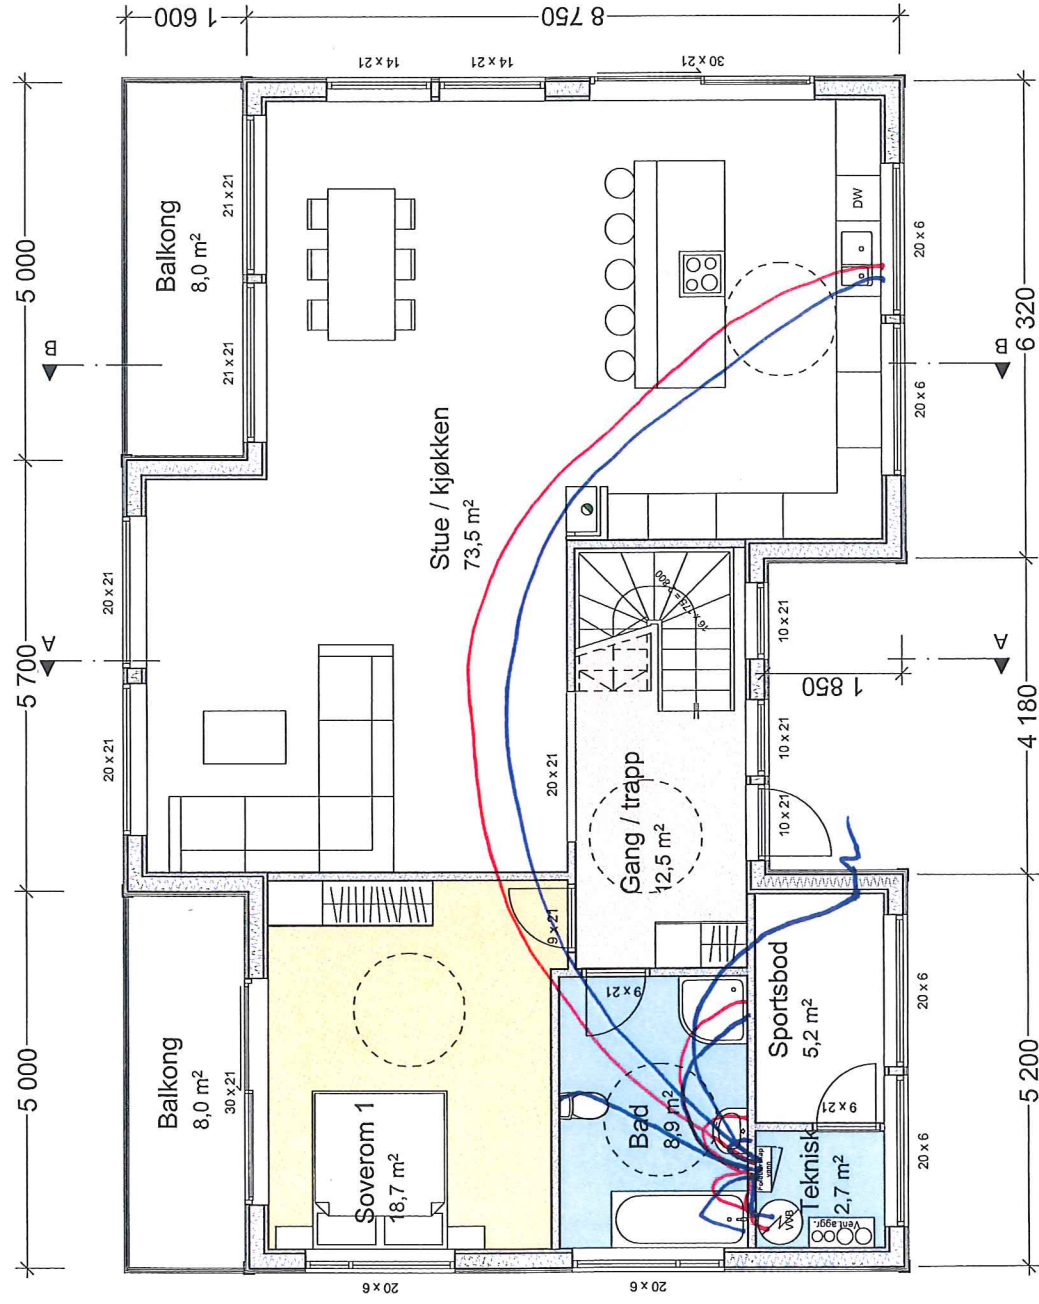

Plan 1.etg.

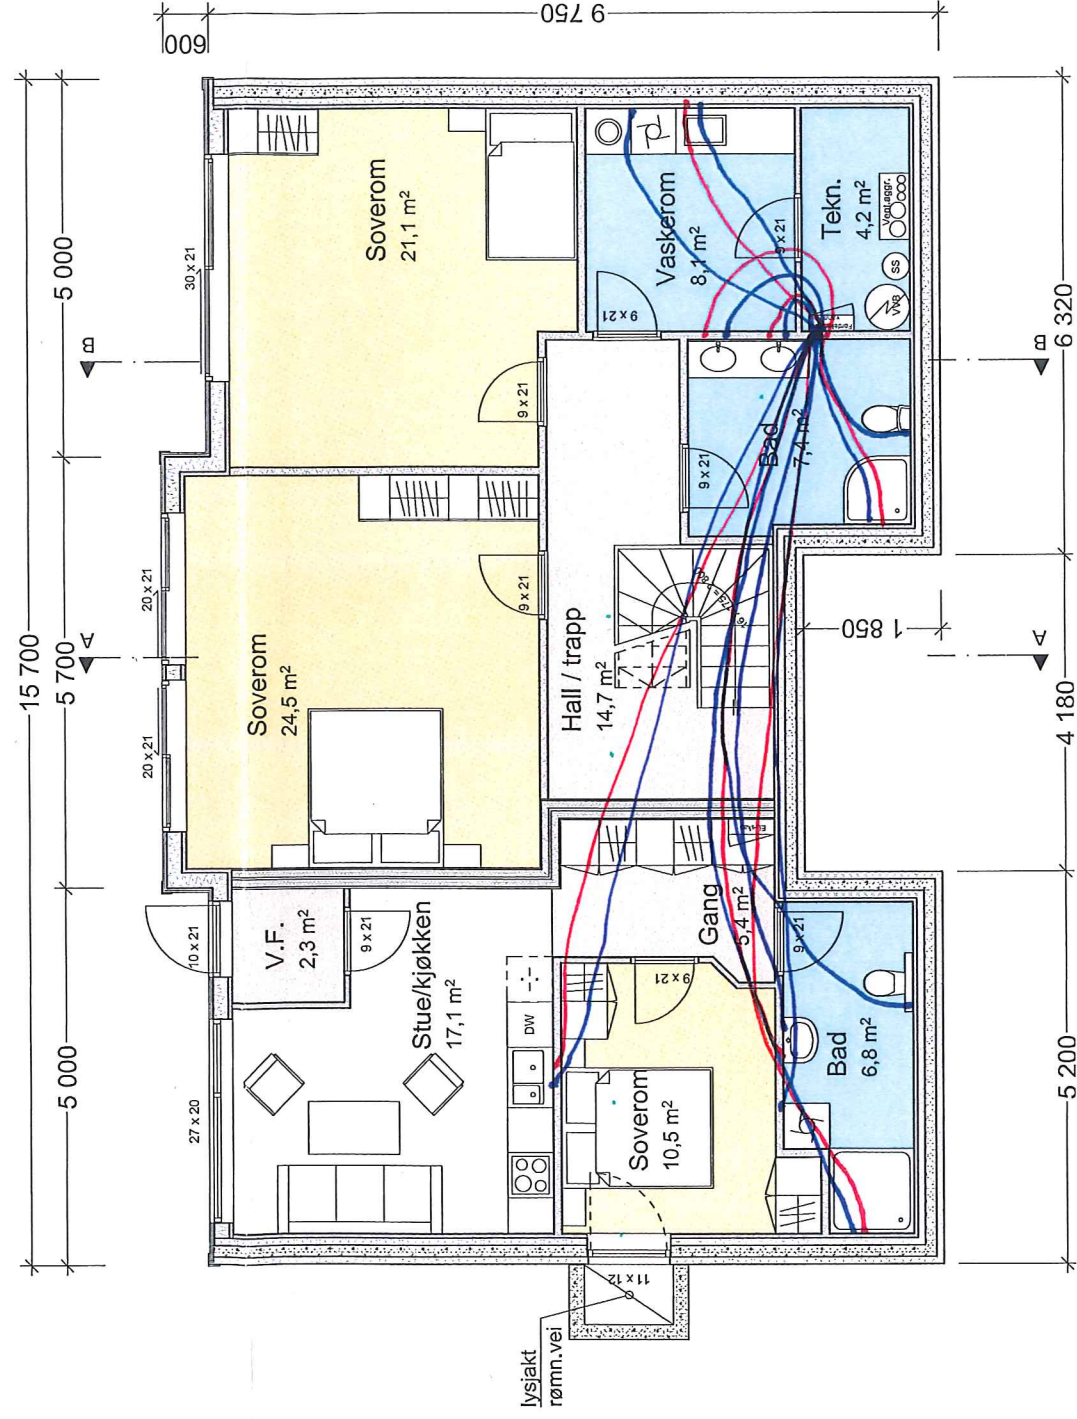

Plan U.etg.

Arealer:


	U.etg.	1.etg.	Loft	Sum
Bruksareal BRA:	129,0m ²	124,6m ²	43,9m ²	297m ²

Bebygget areal BYA:

	Bolig	Garasje	Sum
	158m ²	45m ²	203m ²

203 + 36 = 239 **239 x 100 / 1590 = 15,0% BYA**

07.12.2016, VAMMLØDMINGER

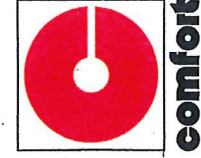

COMFORT KNARVIK
 AS Haugland VVS
 Lyngveien 2,
 5914 ISDALSTØ
 56 35 77 90
 knarvik@comfort.as
 www.comfort.no

Rev. Dato:

Tiltakshaver:

Sasa Misur

Prosjekt:

Helleåsen. Gnr.202, Bnr.161.

Titel:

Plan U.- og 1. Etasje

Tegnet dato:

28.11.2016

Prosjektnr.:

45716

Målestokk:

1:100

Tegningsnr.:

A20-01

Rev.

