

D1

X= 294525
Y= 6719425

X= 294550
Y= 6719425

X= 294575
Y= 6719425


137/583

137/645

N

L1=30
L2=4

Siktsone

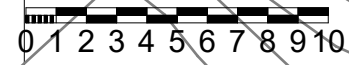

137/646

X= 294525
Y= 6719400

X= 294550
Y= 6719400

X= 294575
Y= 6719400



137/647

137/648

Rev:A Tegnet inn siktsone 200217

Prosjekt. Garasje, Per Birger Møvik
Brørakastet 41, Lindås Kommune
Gnr: 137 bnr: 647

Tegningsinnhold.
Situasjonsplan

Rev
A



Lindåsveien 154, 5914 Isdalstø
Tlf: 977 09 118

Mål. 1:250
Tegn. øs
Tegnr. 102
Dato. 140916