


Pinsemenighetens eiendom
129
Zoar. Gr 76 Br 6
mål: 1:400

Lindsås herred
ad. Myksvoll.

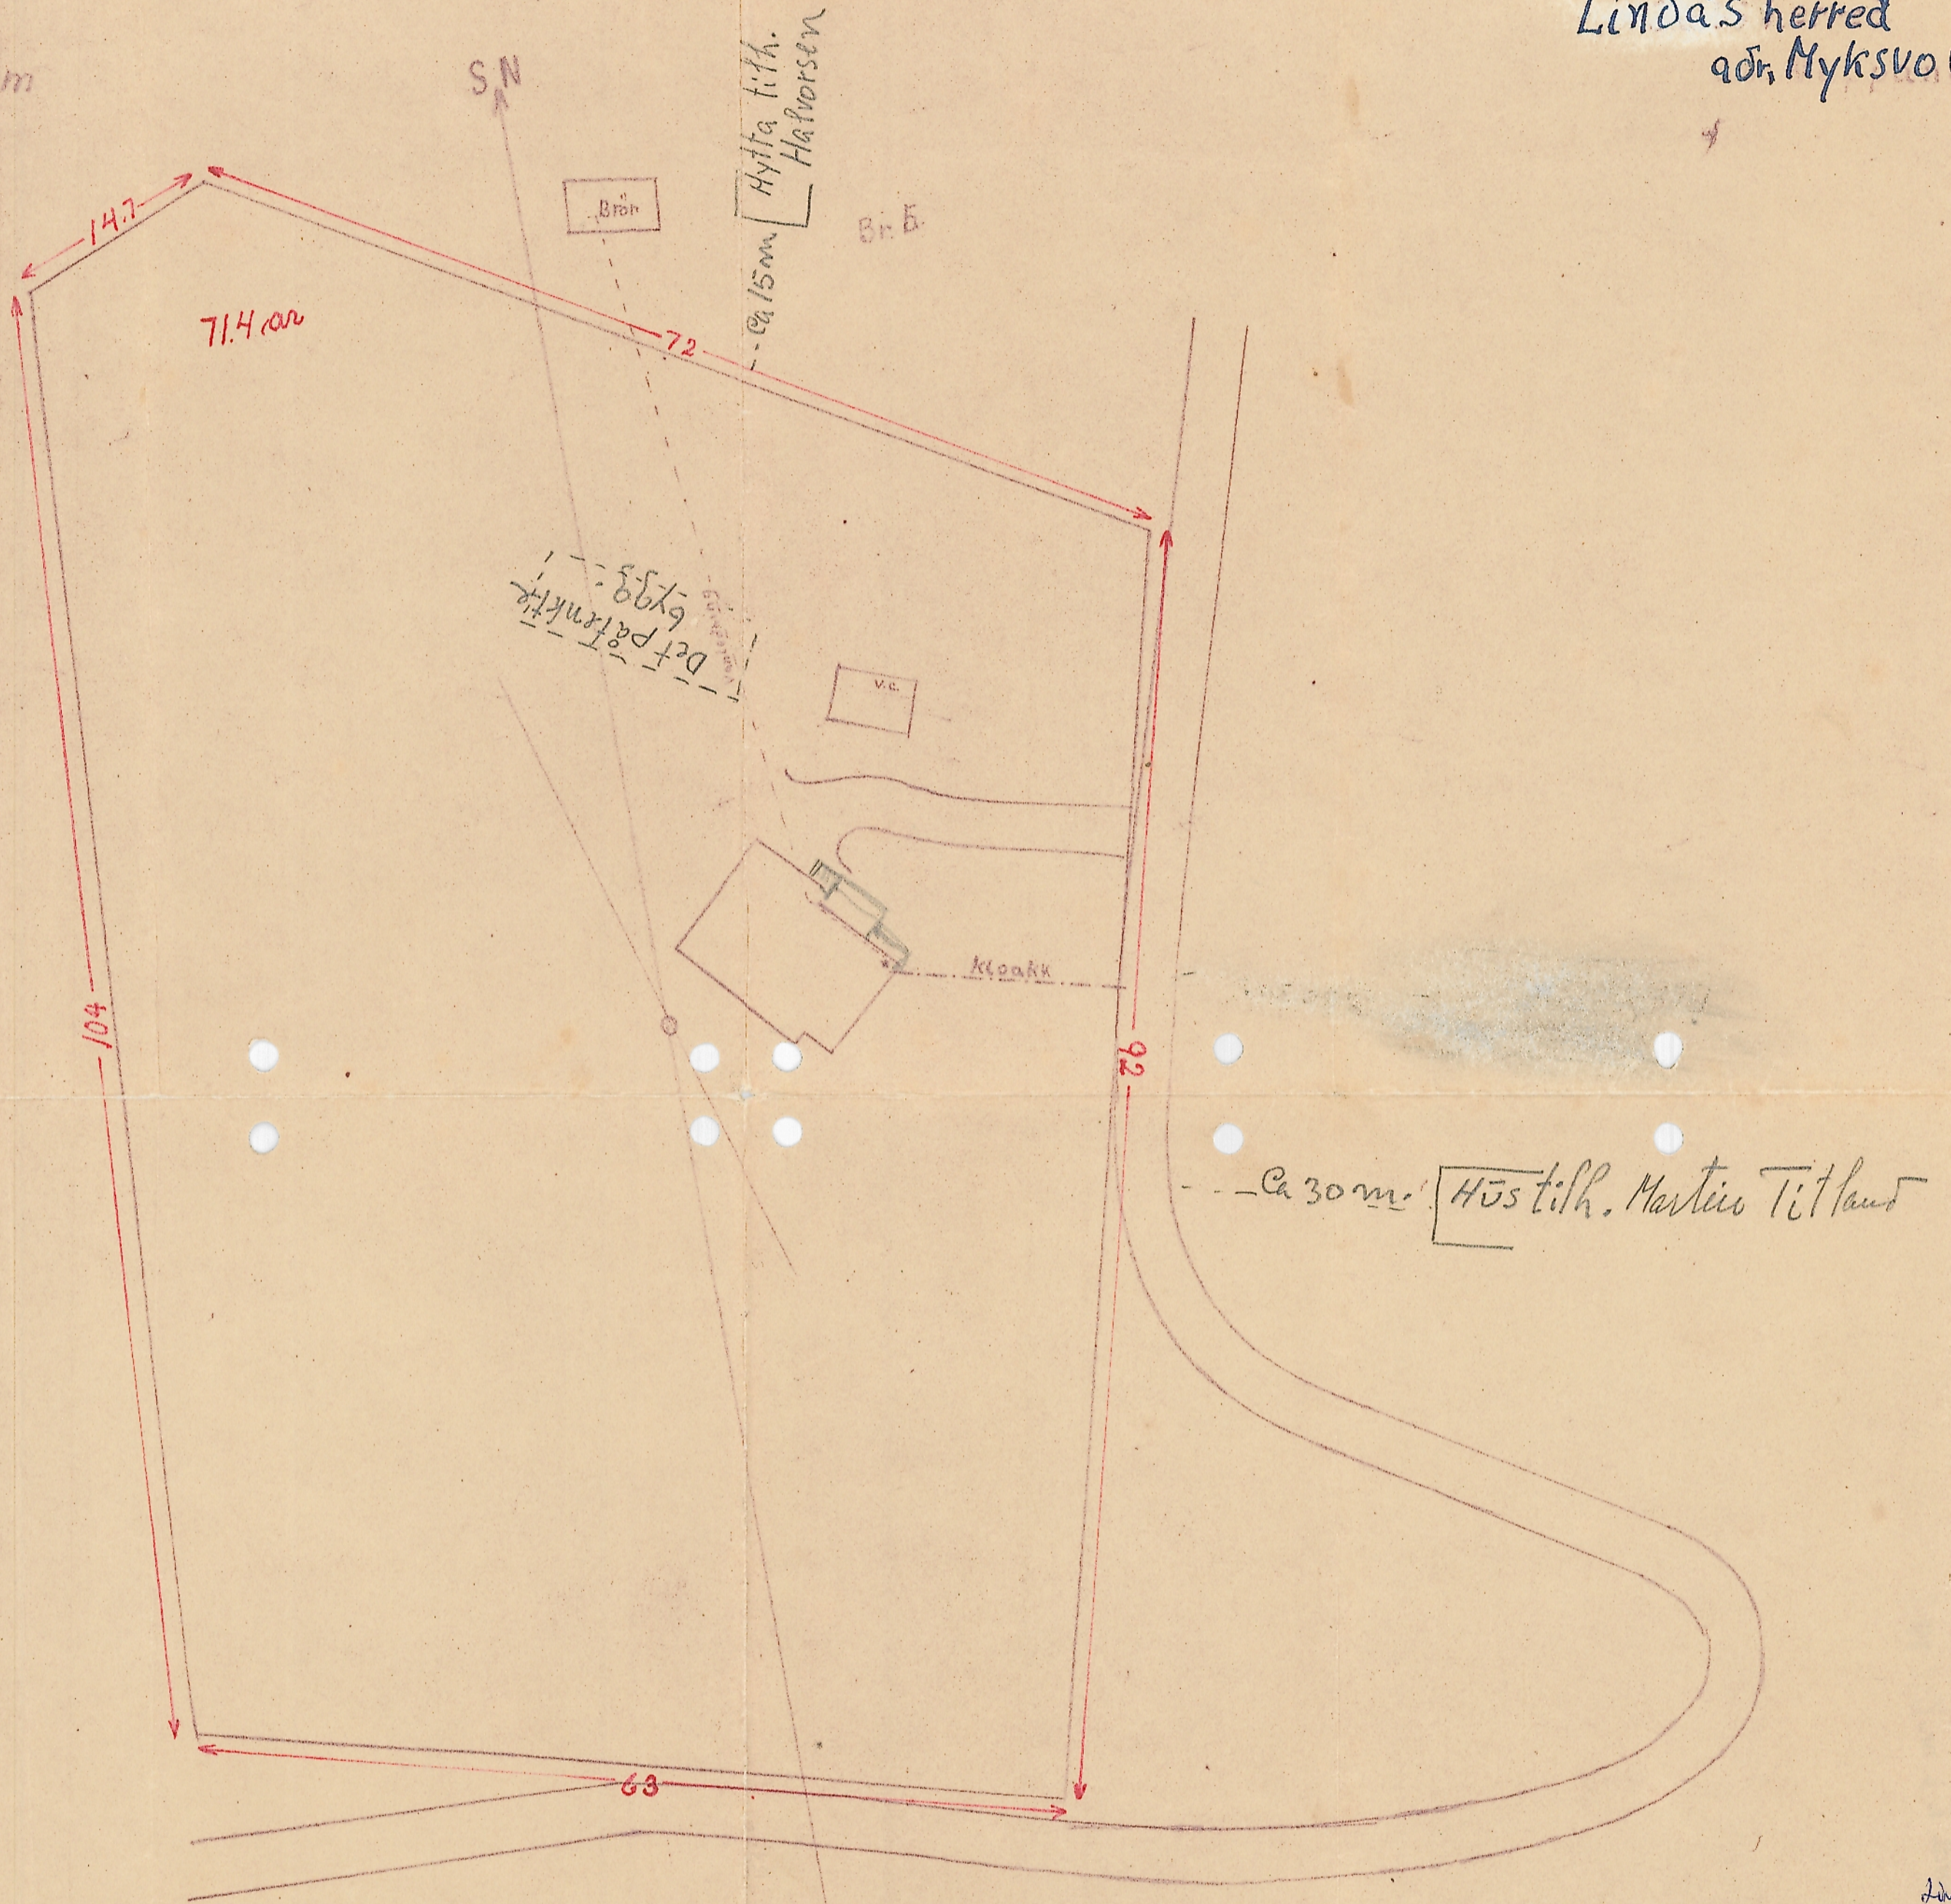

Lindsås herred
13/6-66

Mai 1966
Hj. Myksvoll