
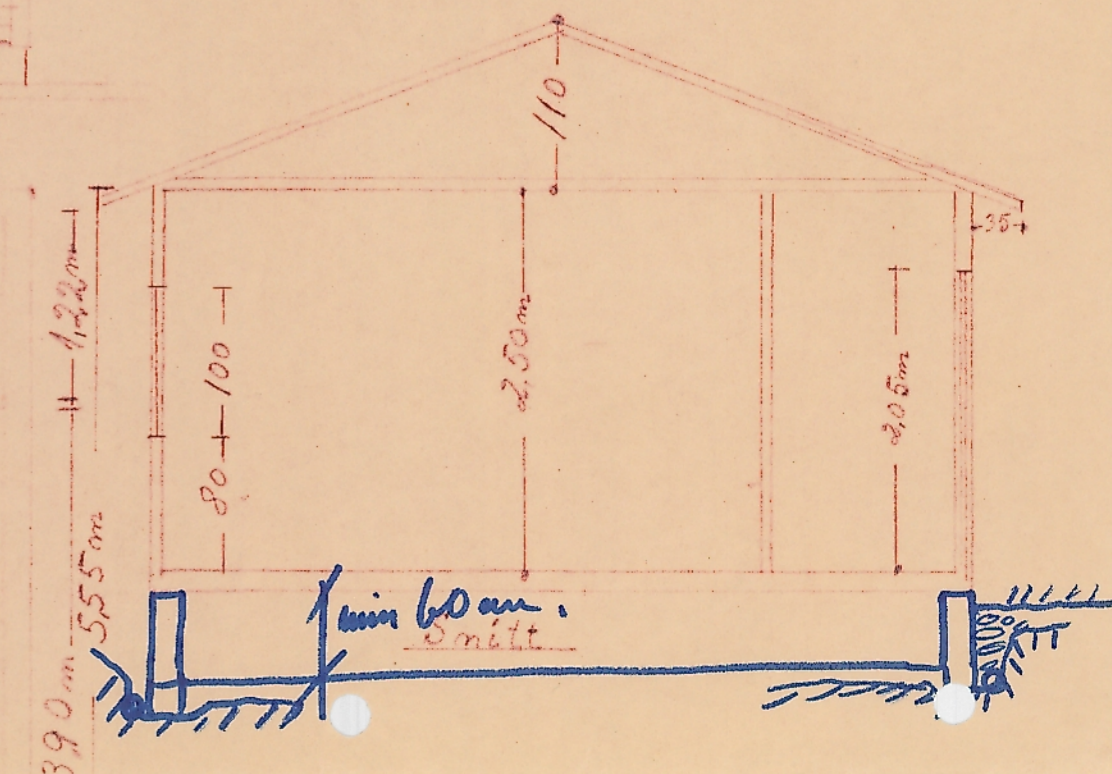


Sovebarakke ved Zoar Nappane.

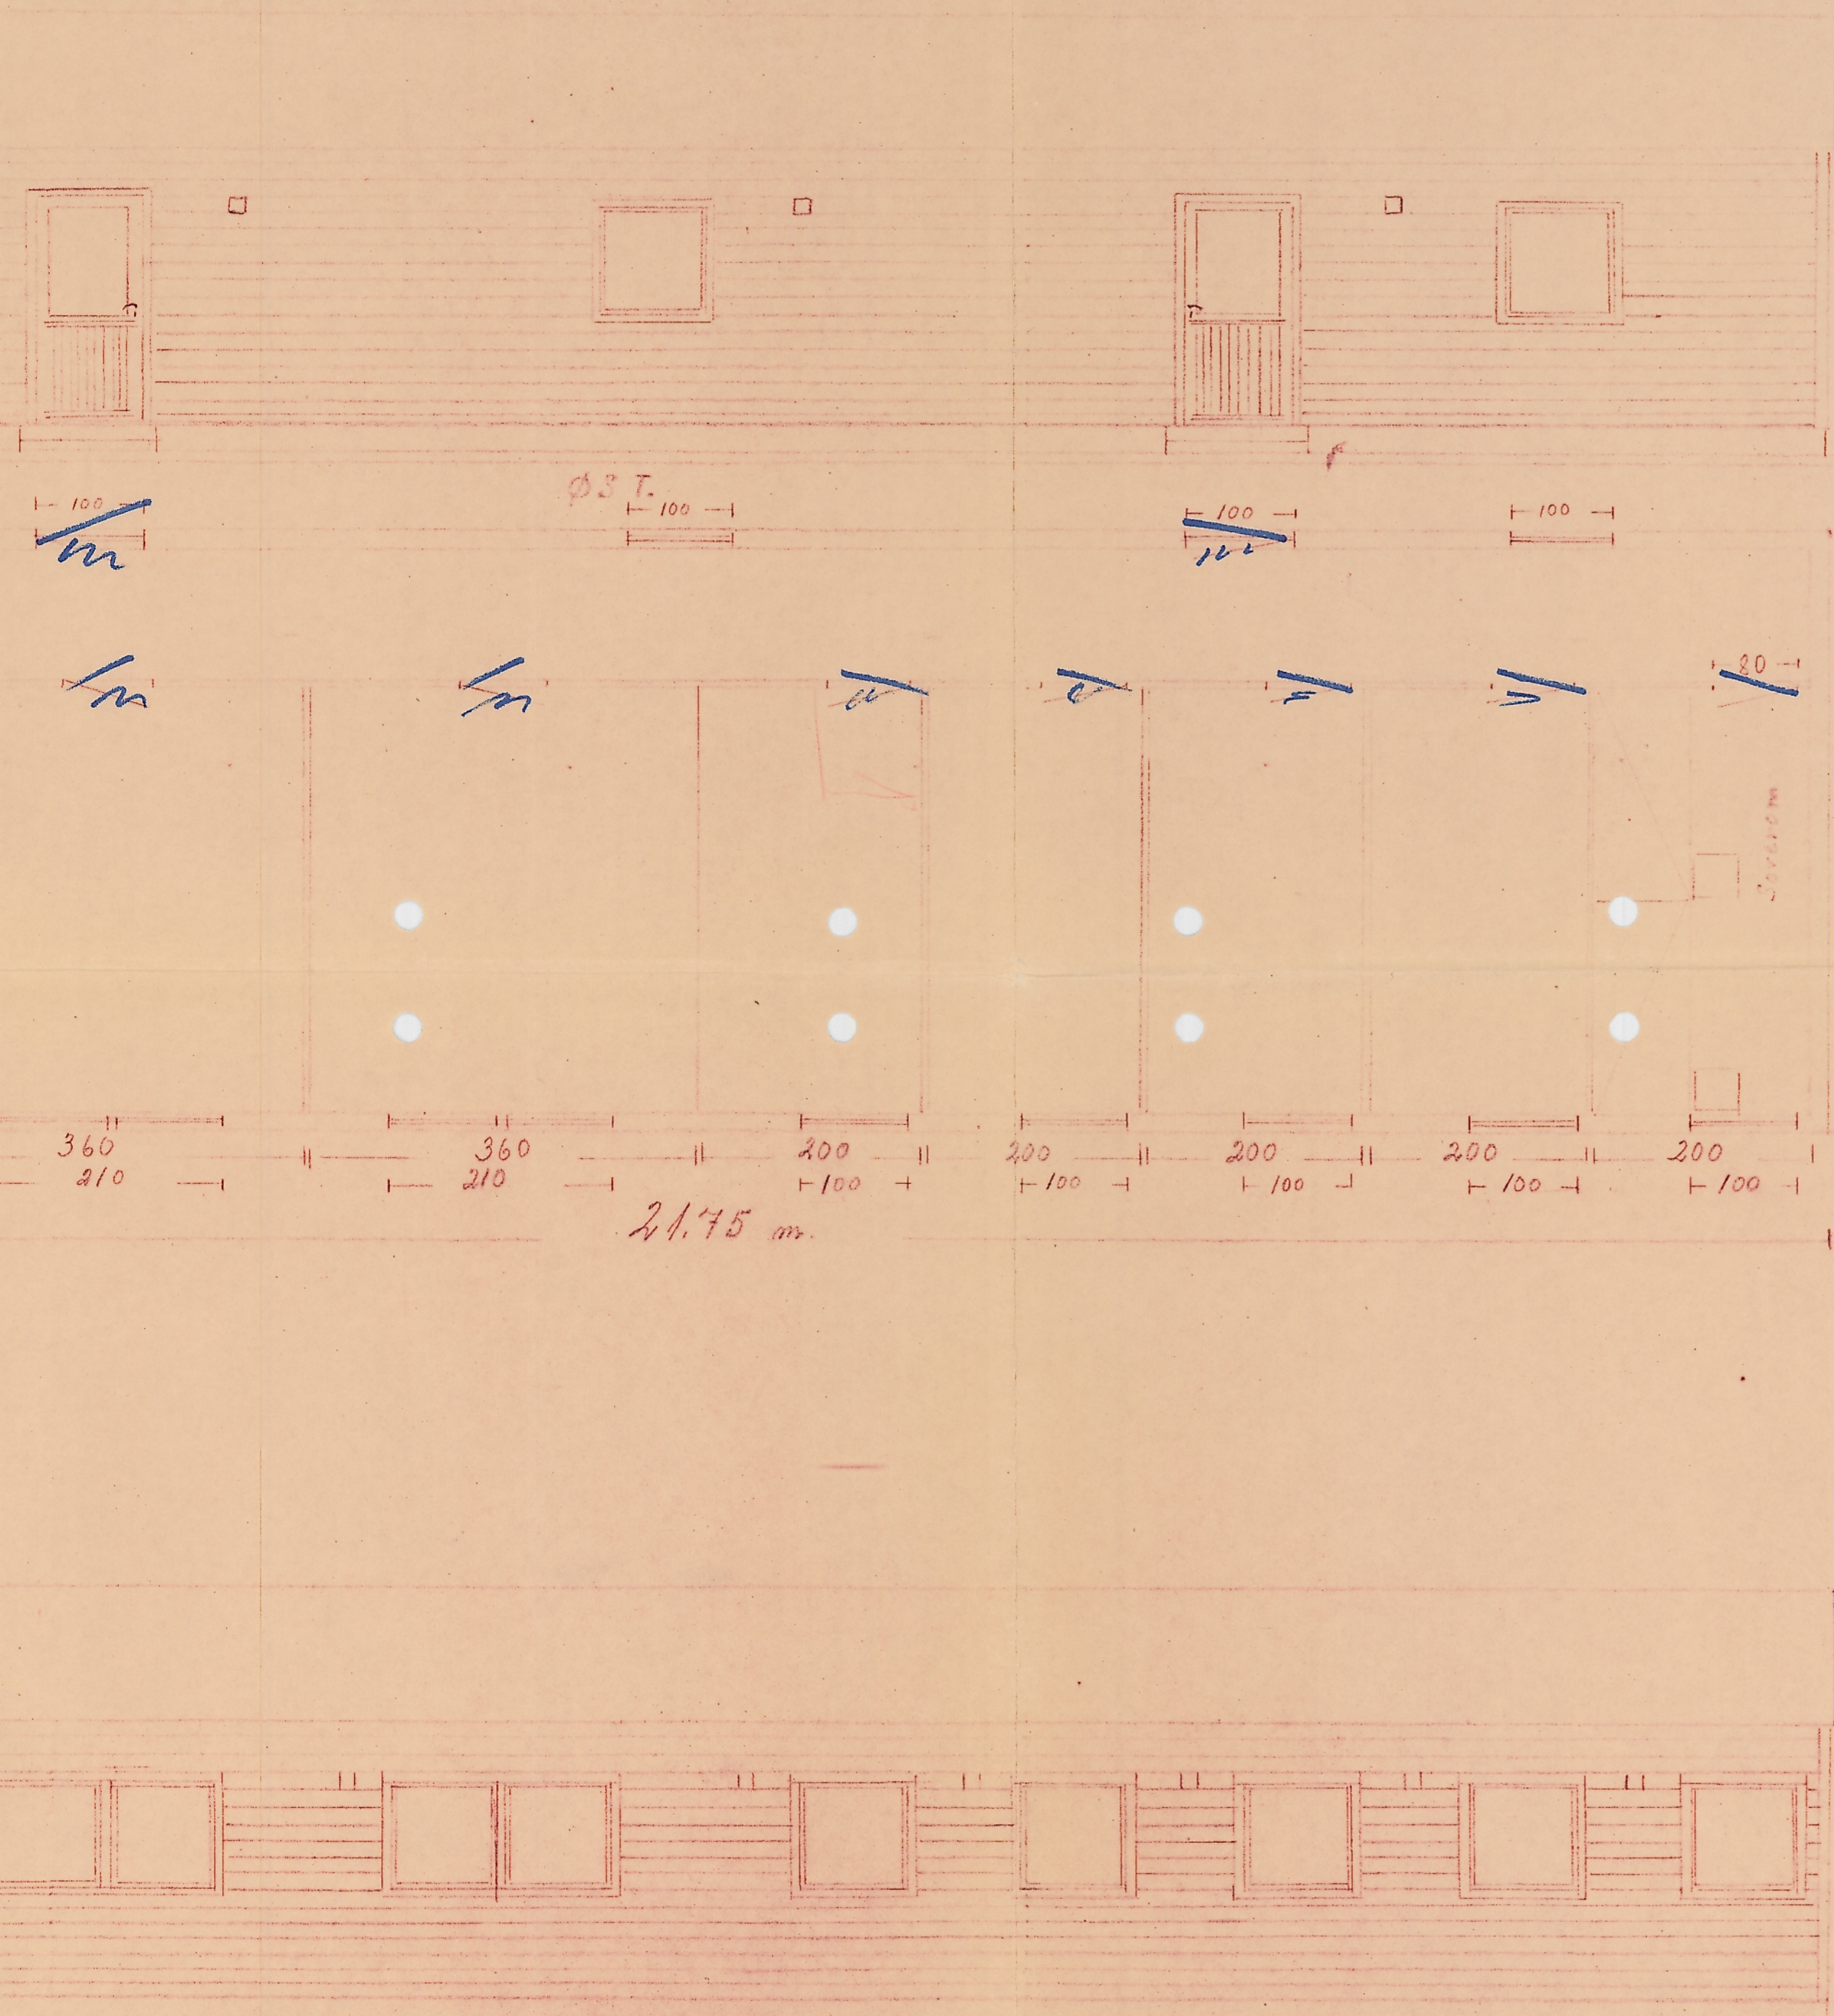

GODTEKE
 SYD. - NORD
 Gindås bygningsråd den 13/6 1966.

Feriehjem

MÅL 1:50

Magnar Skjelvik

Mars 1966

VEST