
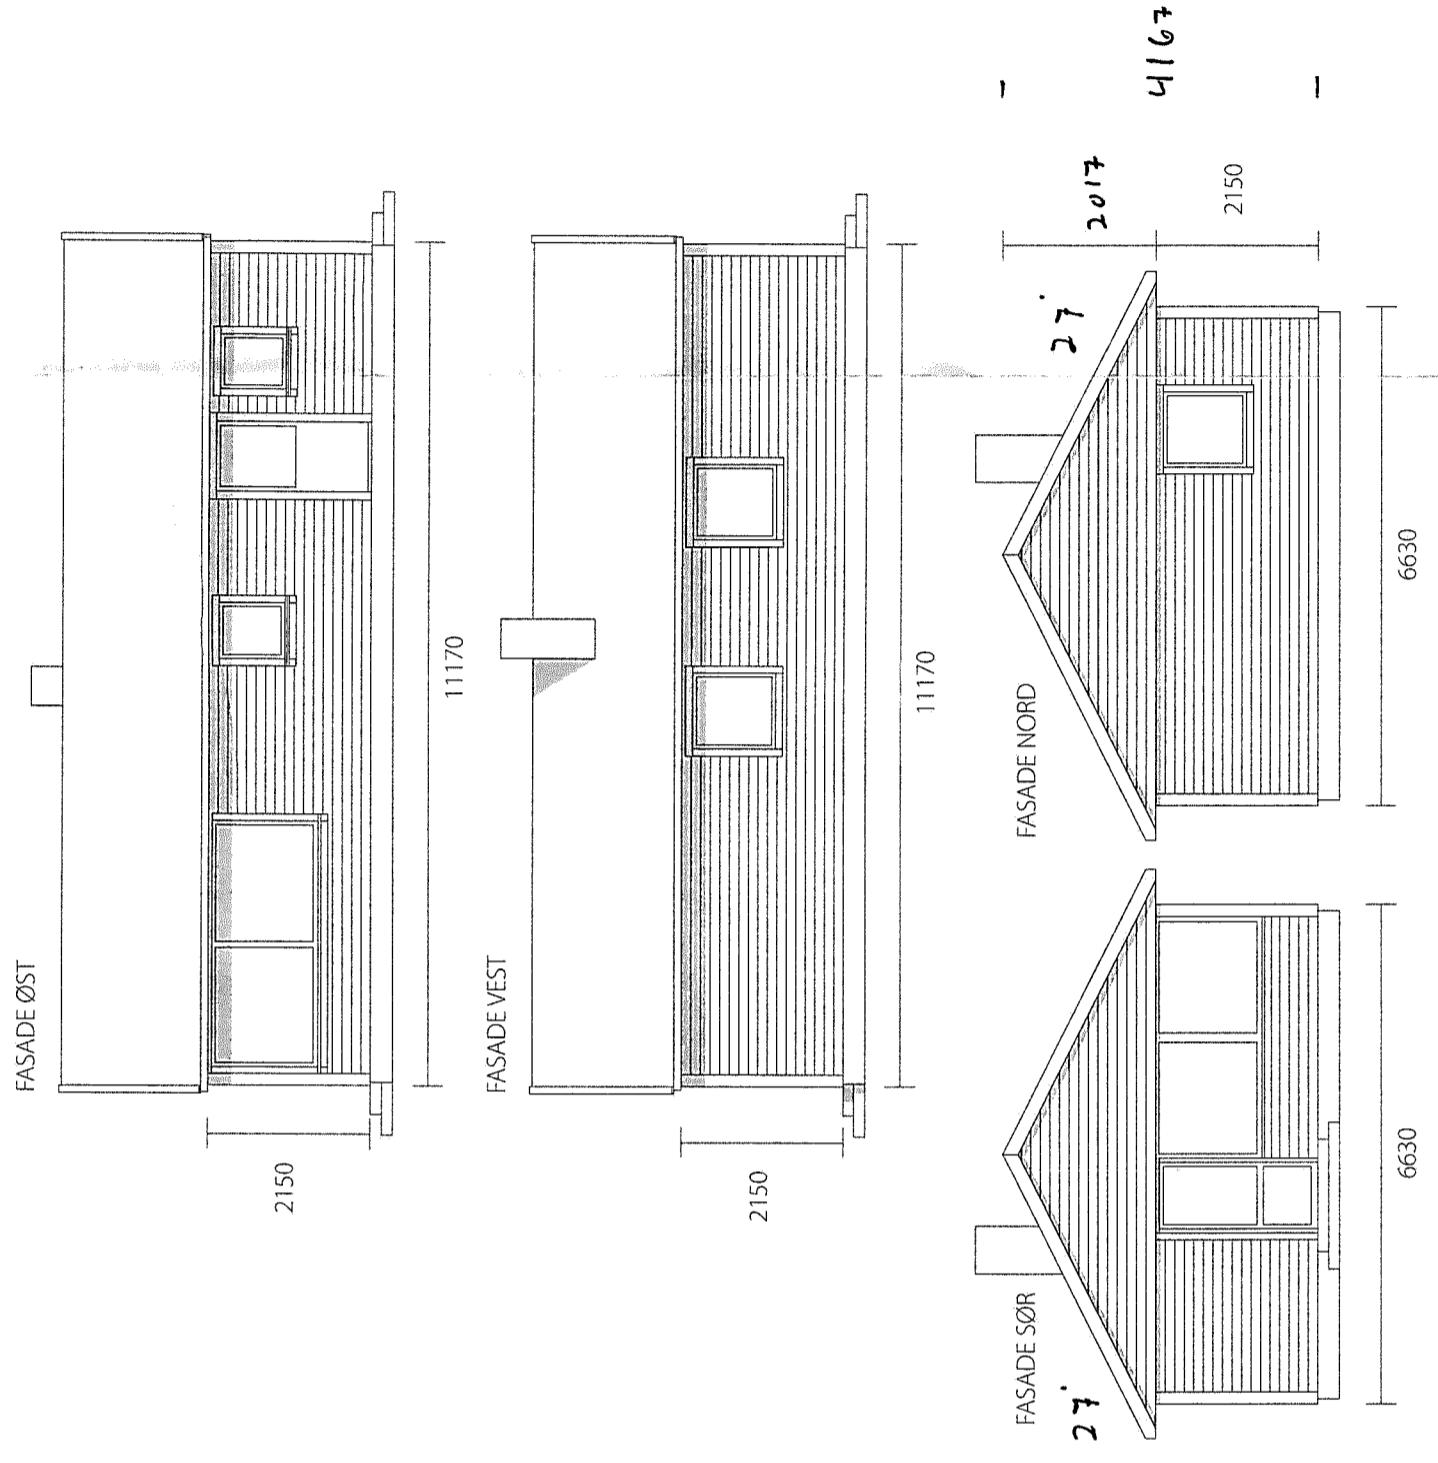


Tormod Lerøy
 Hytte på Vollom
 TILBYGG 1 : 100
 AREAL 65,15m²
 (TILBYGG = 19,18 m²)

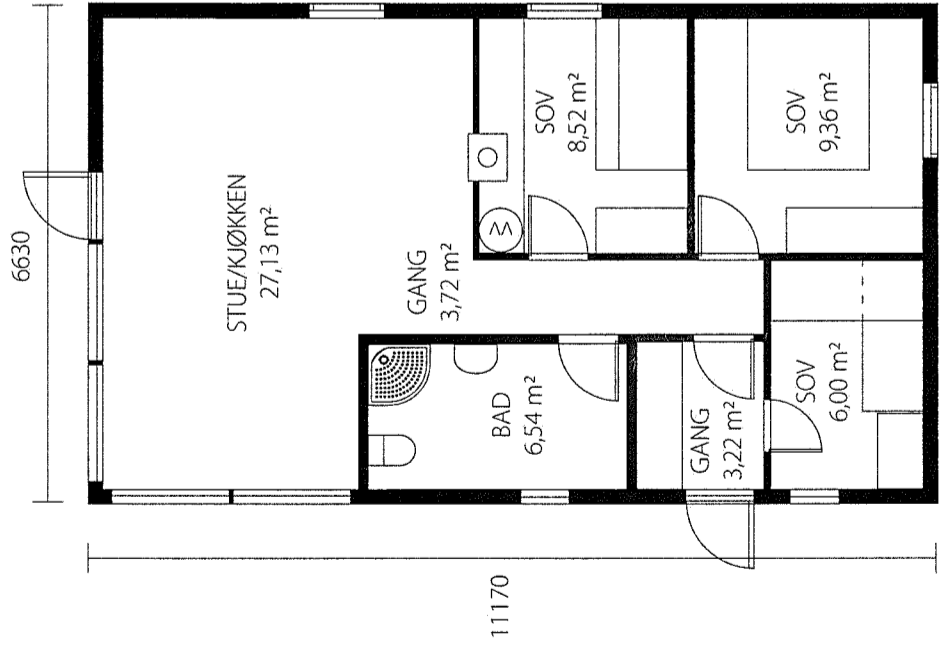

E-1.