


Utv. VL-SPV. Ledninger.

Odd Sæle, Mykingv. 140.

Gnr. 211 - Bnr. 4. 274-17.

1:1000 AN

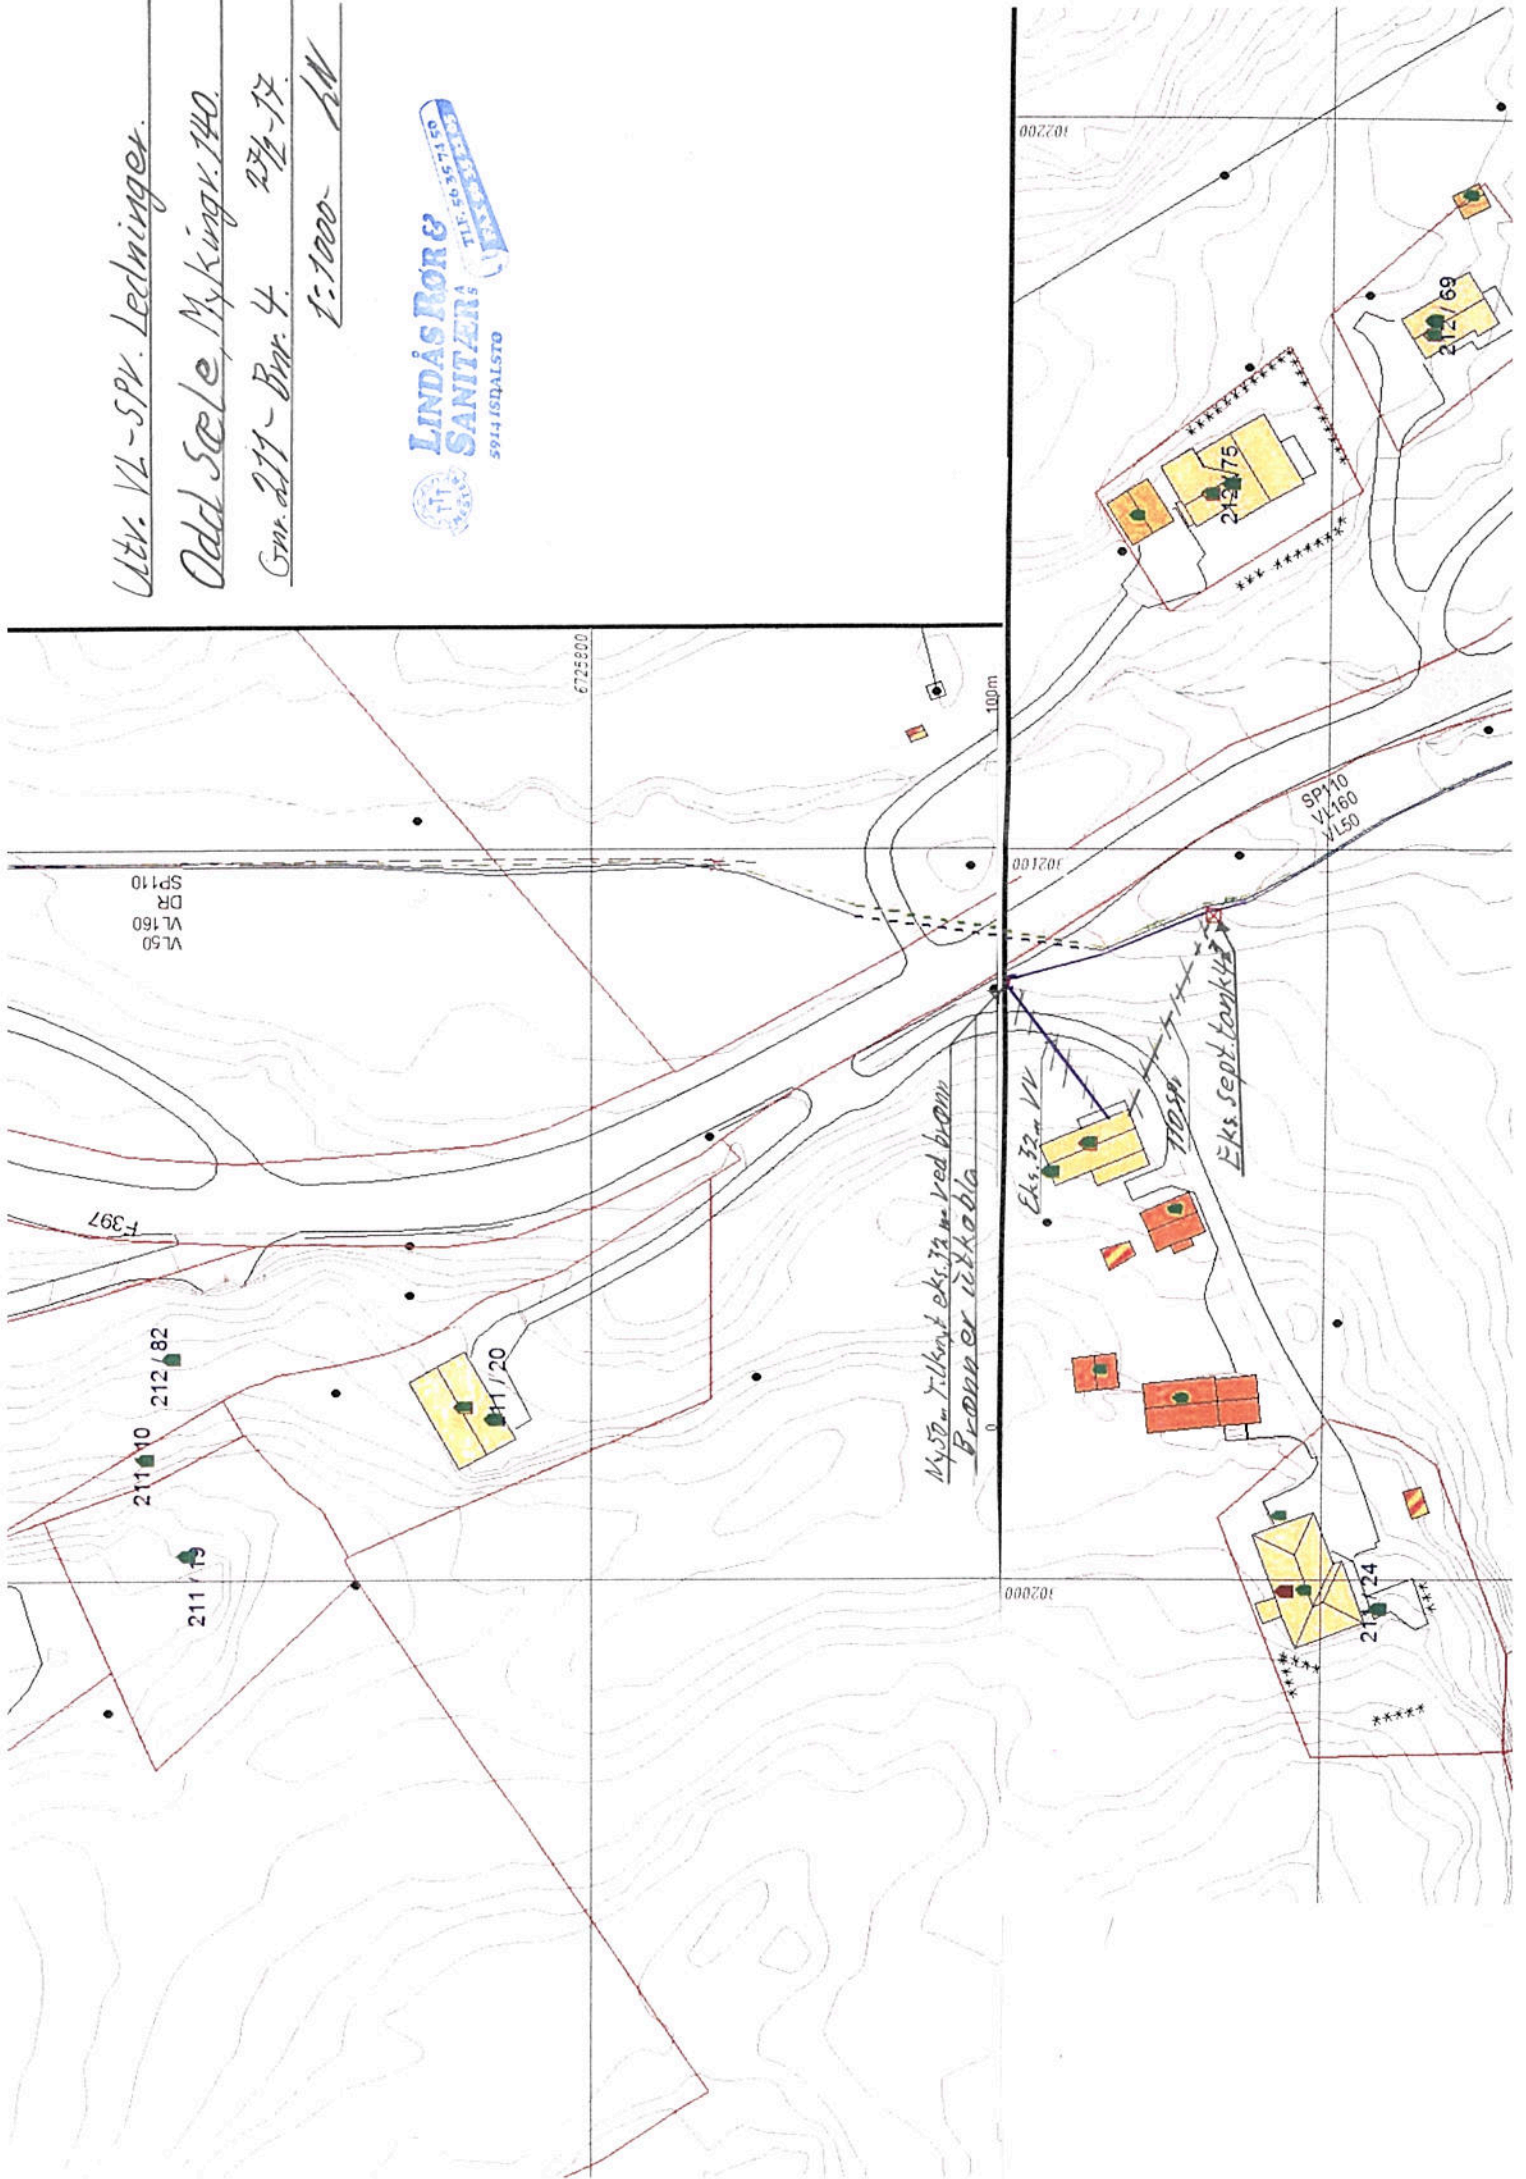

VL50
VL160
DR
SP110

F397

211/10
212/82

211/19

211/20

Brønner ikkabla

Eks. 32m VV

Eks. sept. tank 4m

212/24

212/75

212/69

SPV10
VL160
VL50

100m

102100

102000

102200

672500