




PLAN KJELLER

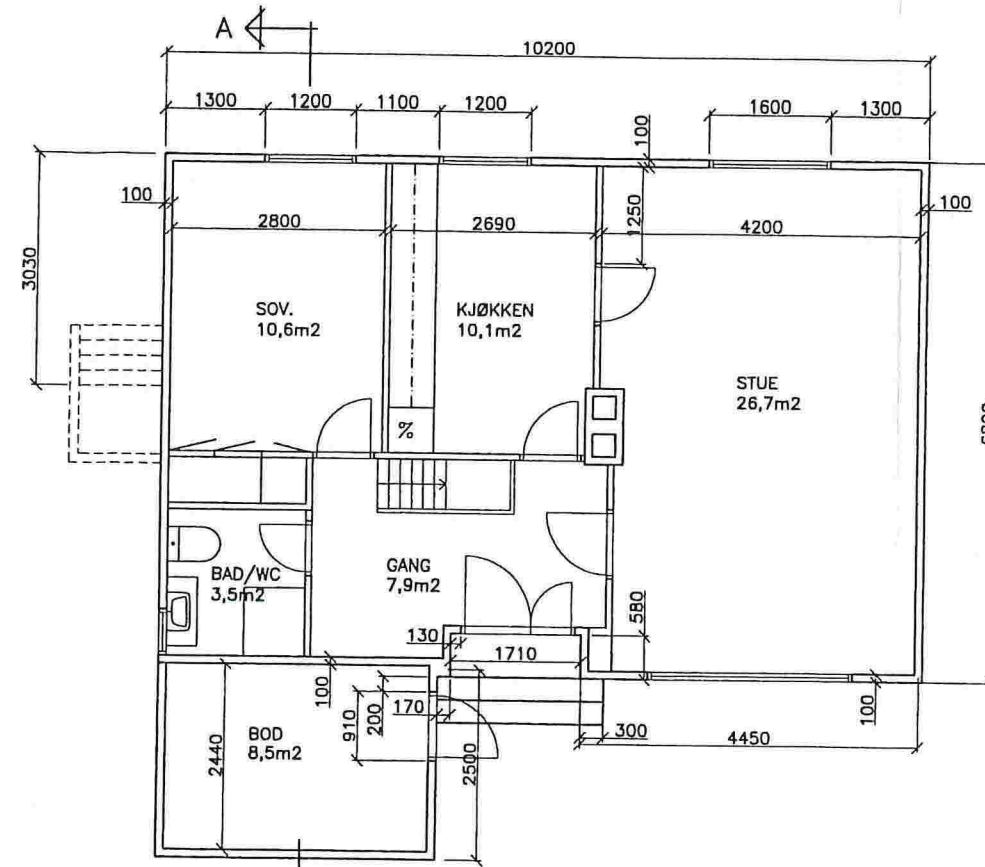

PLAN 1.ETASJE

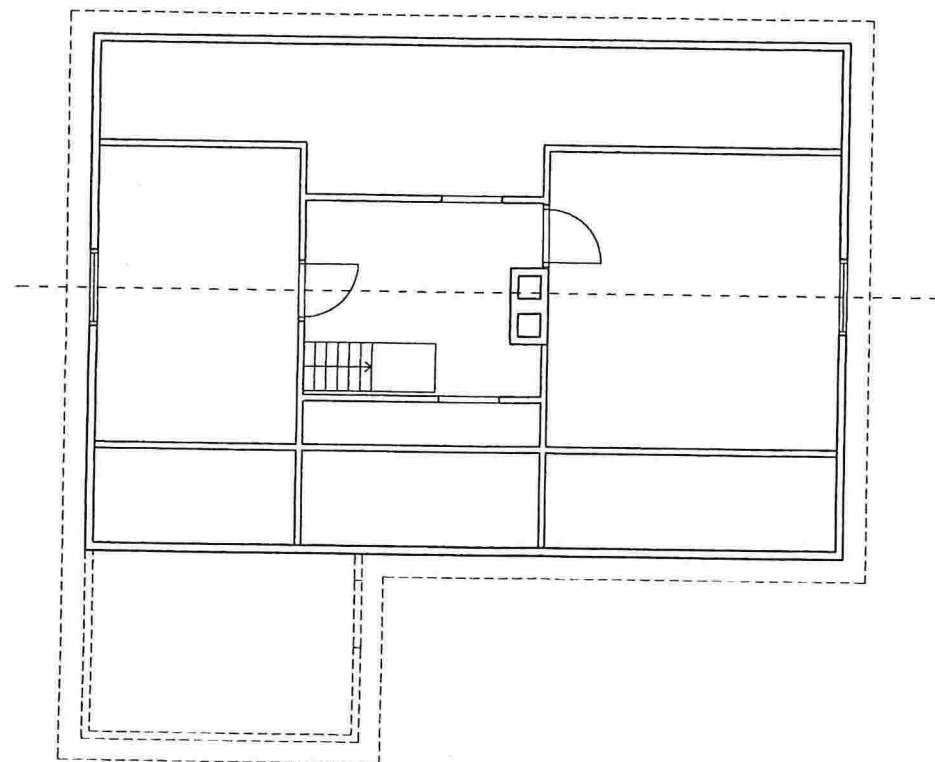

PLAN LOFT

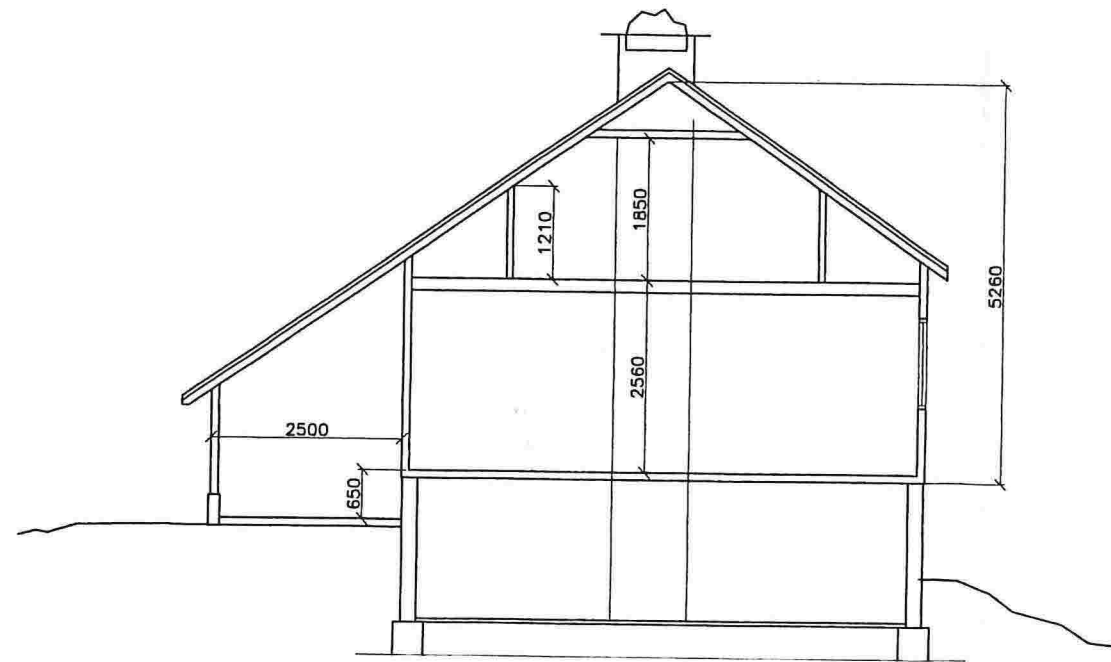

SNITT A-A

SVINDALSVEGEN 168		Gnr. 23, Bnr. 8	
PLANER OG SNITT, EKSISTERENDE SITUASJON			
Siv.ing. Atle Sundal		1:100	
Fabrikkegaten 78, N-5058 BERGEN		LW	
TELEFON 55 59 82 50, TELEFAX 55 59 82 57		1:100	
MOBILTEL: 95 08 72 99		23.06.14	