


Plan 1

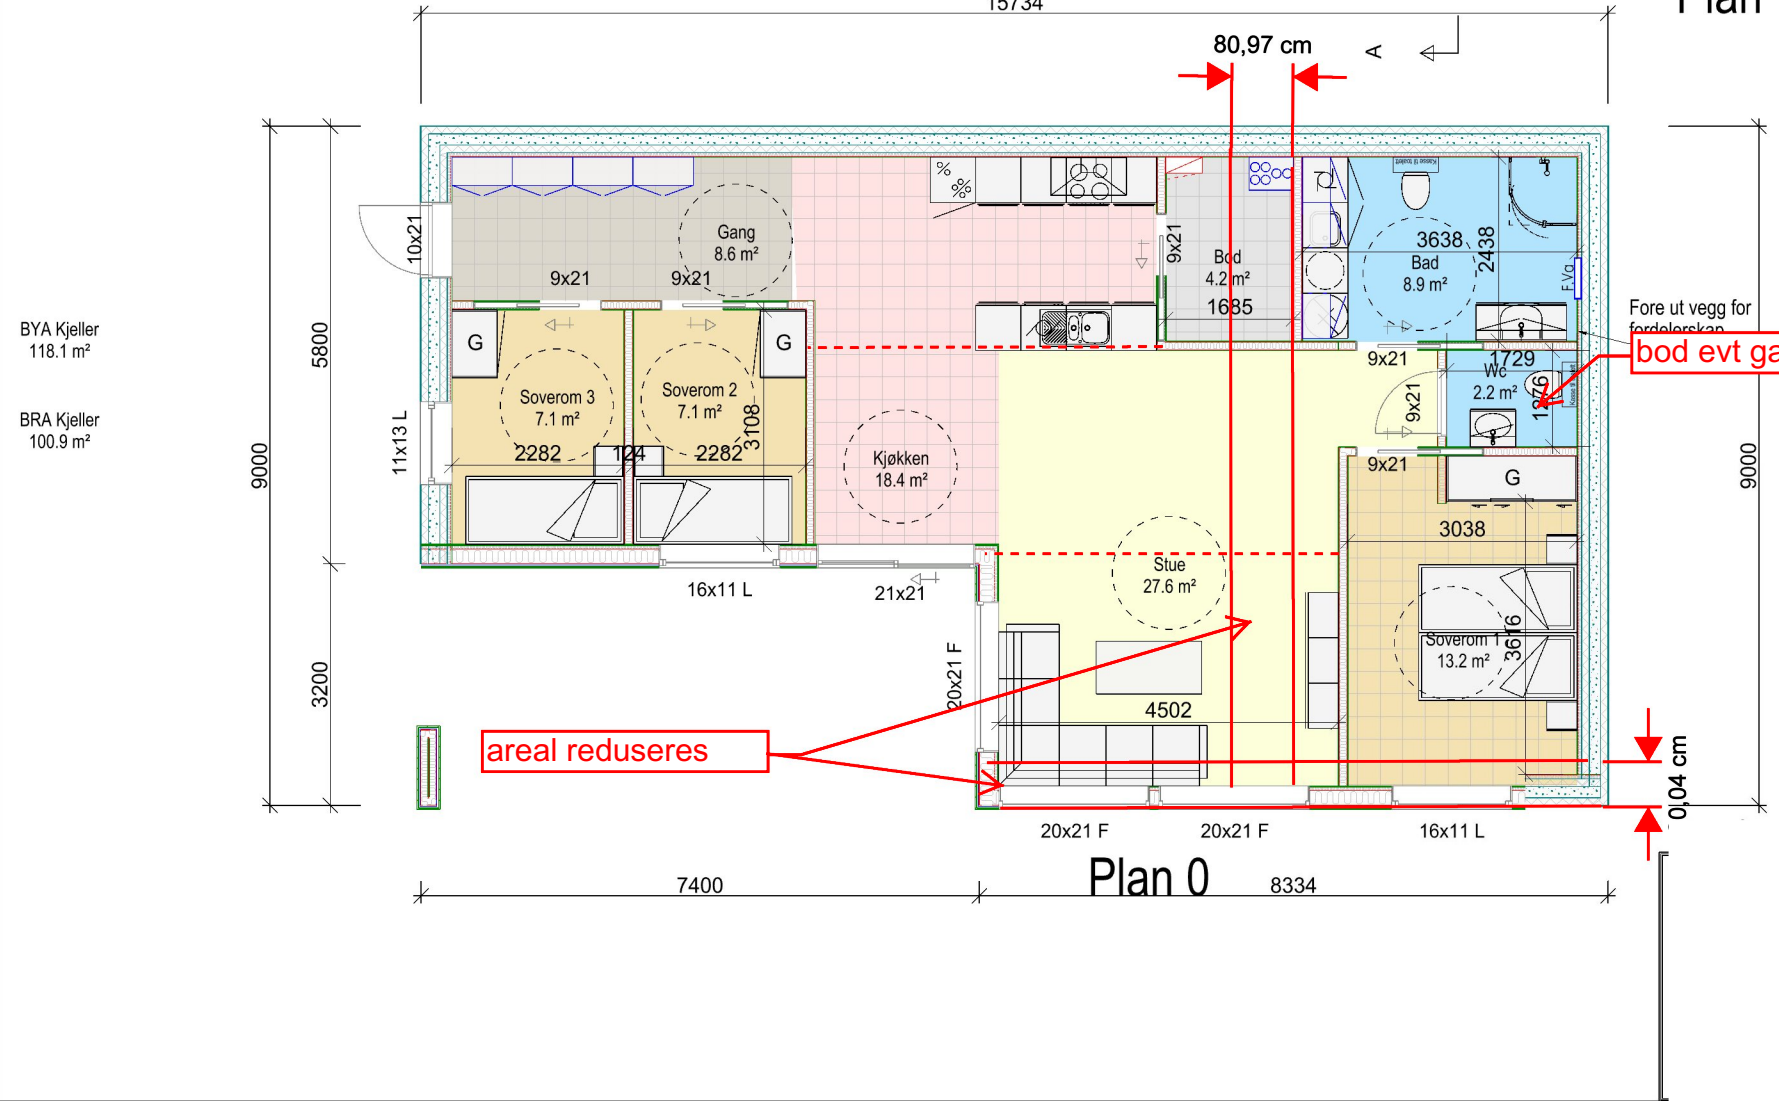

Plan 0

BYA Kjeller  
118.1 m²  
BRA Kjeller  
100.9 m²