



EXISTERENDE SLAVASRIKLER
BEHÅLLES AU PØMPEMØM

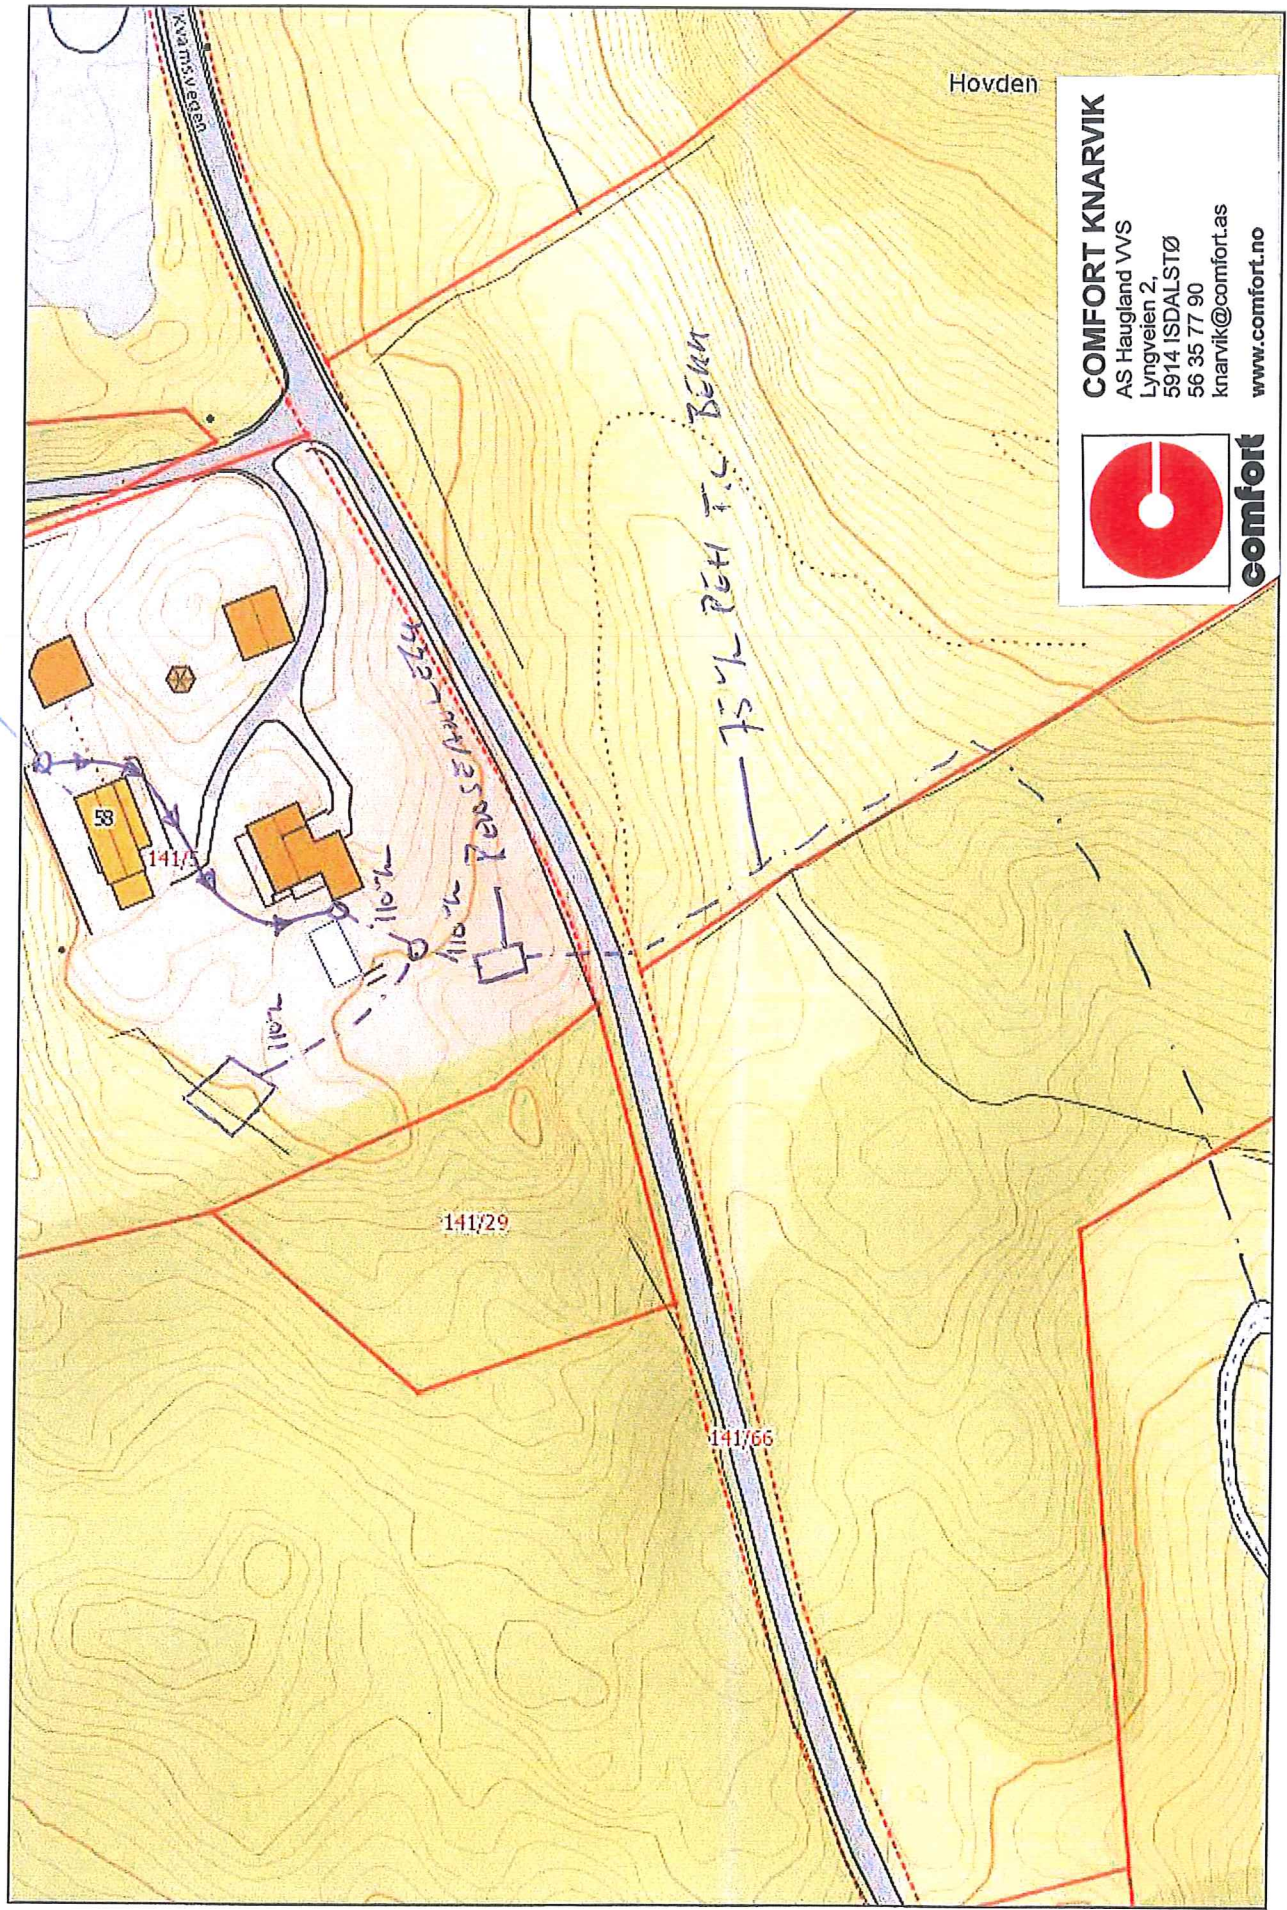

Hovden

COMFORT KNARVIK
AS Haugland VVS
Lyngveien 2
5914 ISDALSTØ
56 35 77 90
knarvik@comfort.as
www.comfort.no

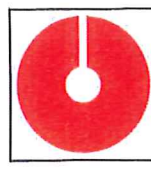

comfort