


15

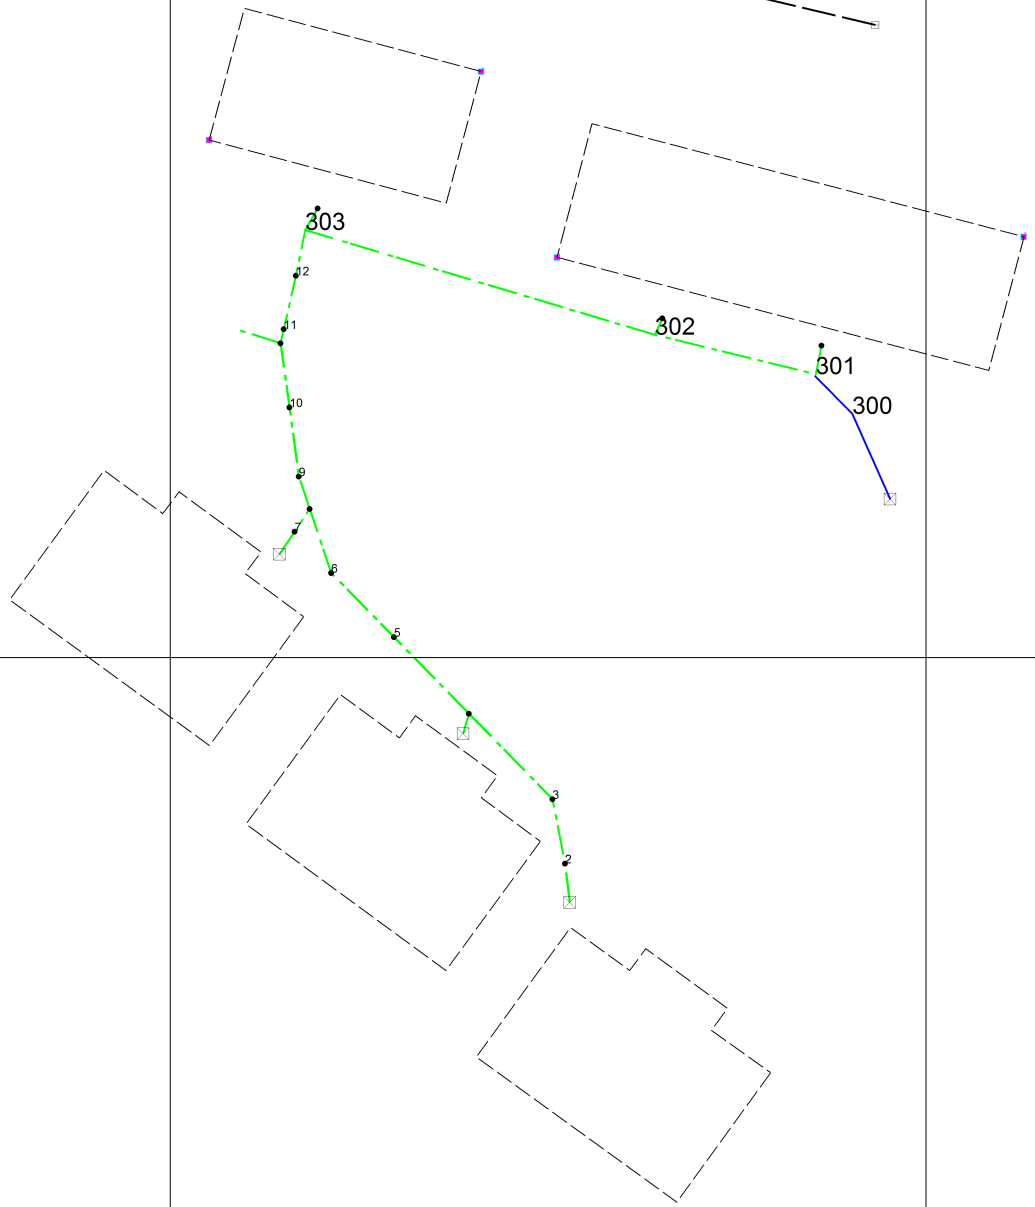

137-188
Innmålte leidningar
16.06.2017
Målestokk 1:500
Medaas Oppmåling