

20.08.2017

Fasade Vist


Veråsvegen 36

Brandsm 108 Brnkmr 496

Tiltakshaver Haune Seljelid

Yngve Njåten

Fasade endring

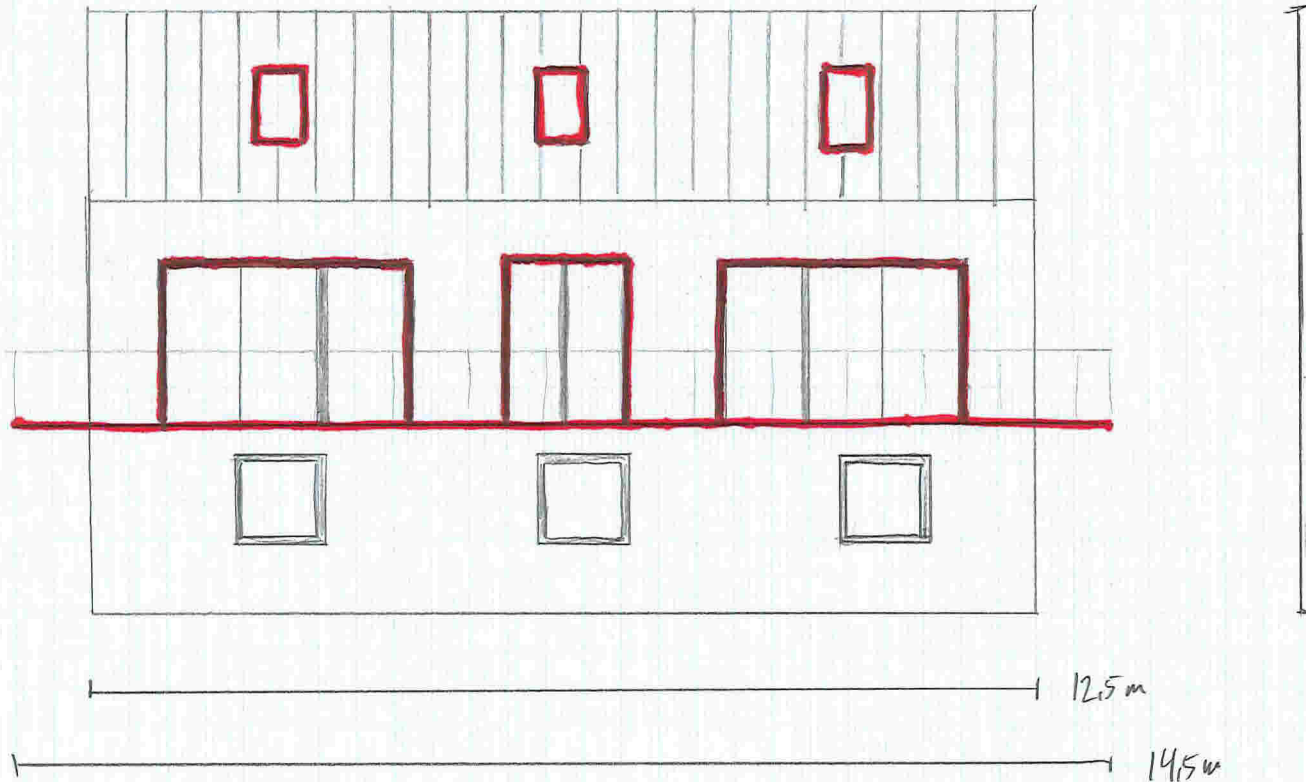

1:100

8m

12.5m

14.5m

①

11/11/11

