


Karl Anders Stene 108/2  
Tilkobling ny vann/kloakk  
Lindås VVS N.T AS  
05.09-17  
1:100

### Bunnledning

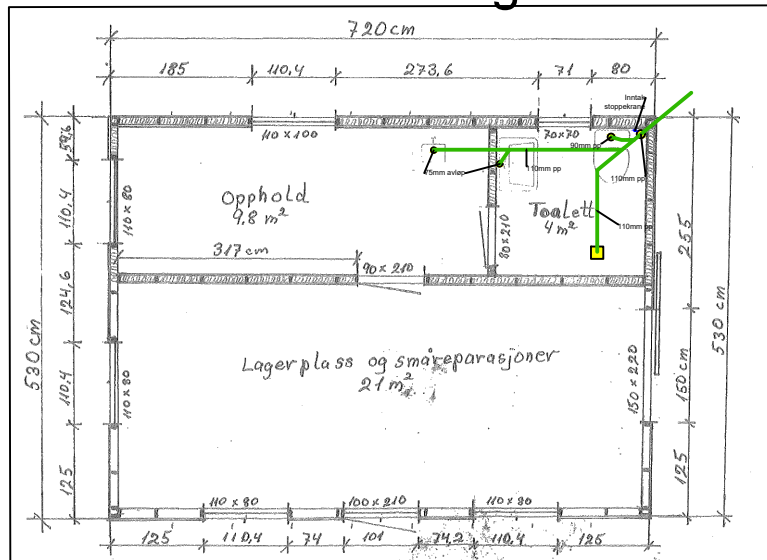

### 1 plan

