


Area of cty = 27 m<sup>2</sup>

Sum Leil. B3h 1-9: BRA = 118 m<sup>2</sup>

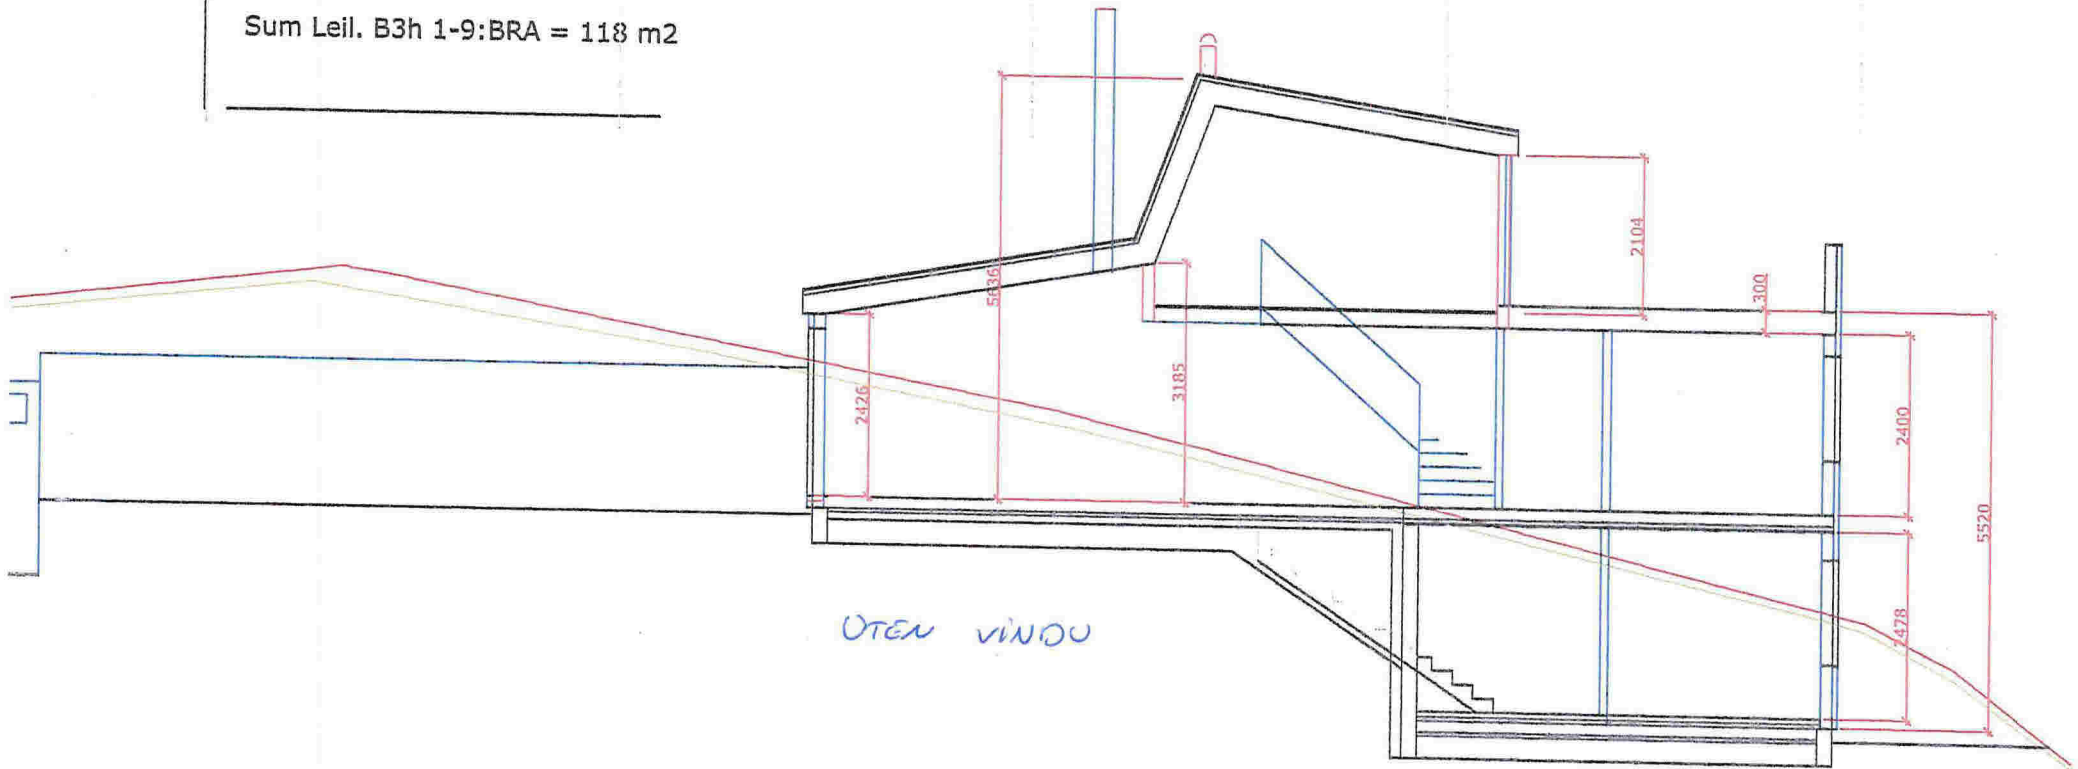


OTEN VINDU

1E

Area of City = 27 m<sup>2</sup>

Sum Leil. B3h 1-9: BRA = 118 m<sup>2</sup>

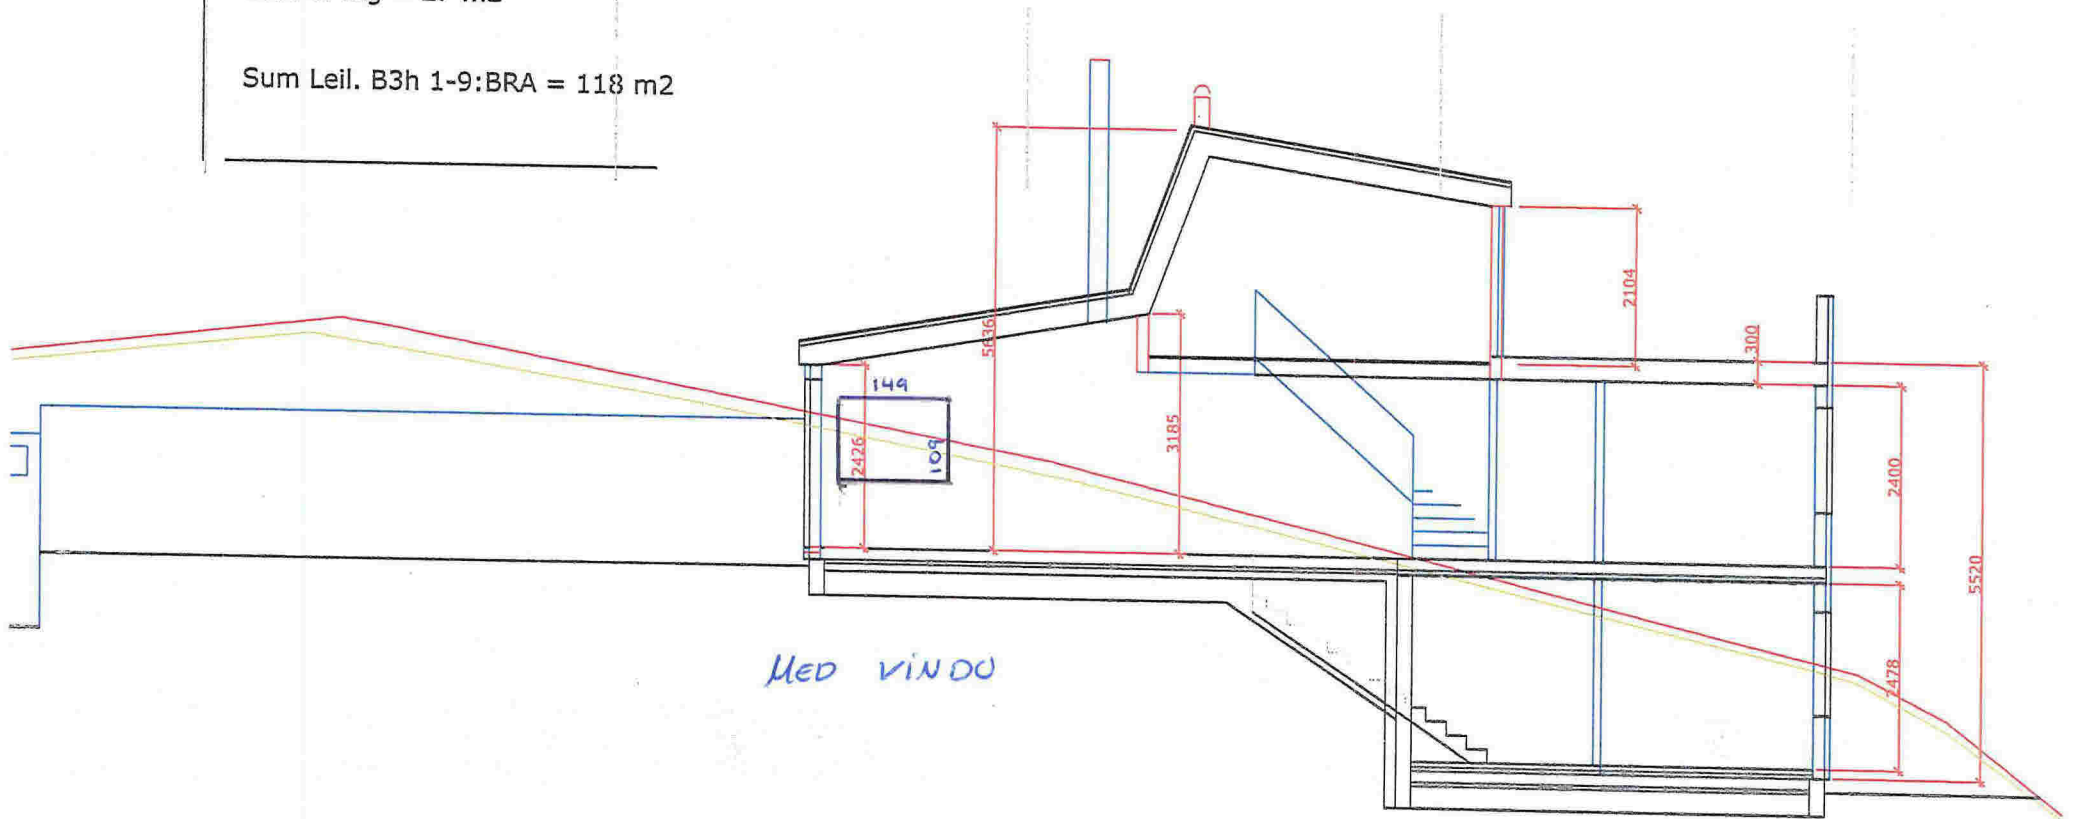

Med vindu



2 E

