

Gemini | Oppmåling

Prosjekt:


Koordinatsystem: UTM(EUREF89) - SONE 32

19.06.2014

PunktID	Tema	N-koord.	Ø-koord.	Høyde	Geoide H	Status
H01		6 719 870,217	301 159,434	11,225		K
HJ1	Garasje	6 719 872,152	301 159,898			K
HJ2	Garasje	6 719 869,147	301 163,827			K
HJ4	Garasje	6 719 869,376	301 157,764			K
HJ3	Garasje	6 719 866,371	301 161,708			K

Anko har også levert ei KOF-fil. Den kan eg ikkje opna. Er kommunen interessert, kan eg ta ein kopi og sende/koma innom med.

O. Høyevold

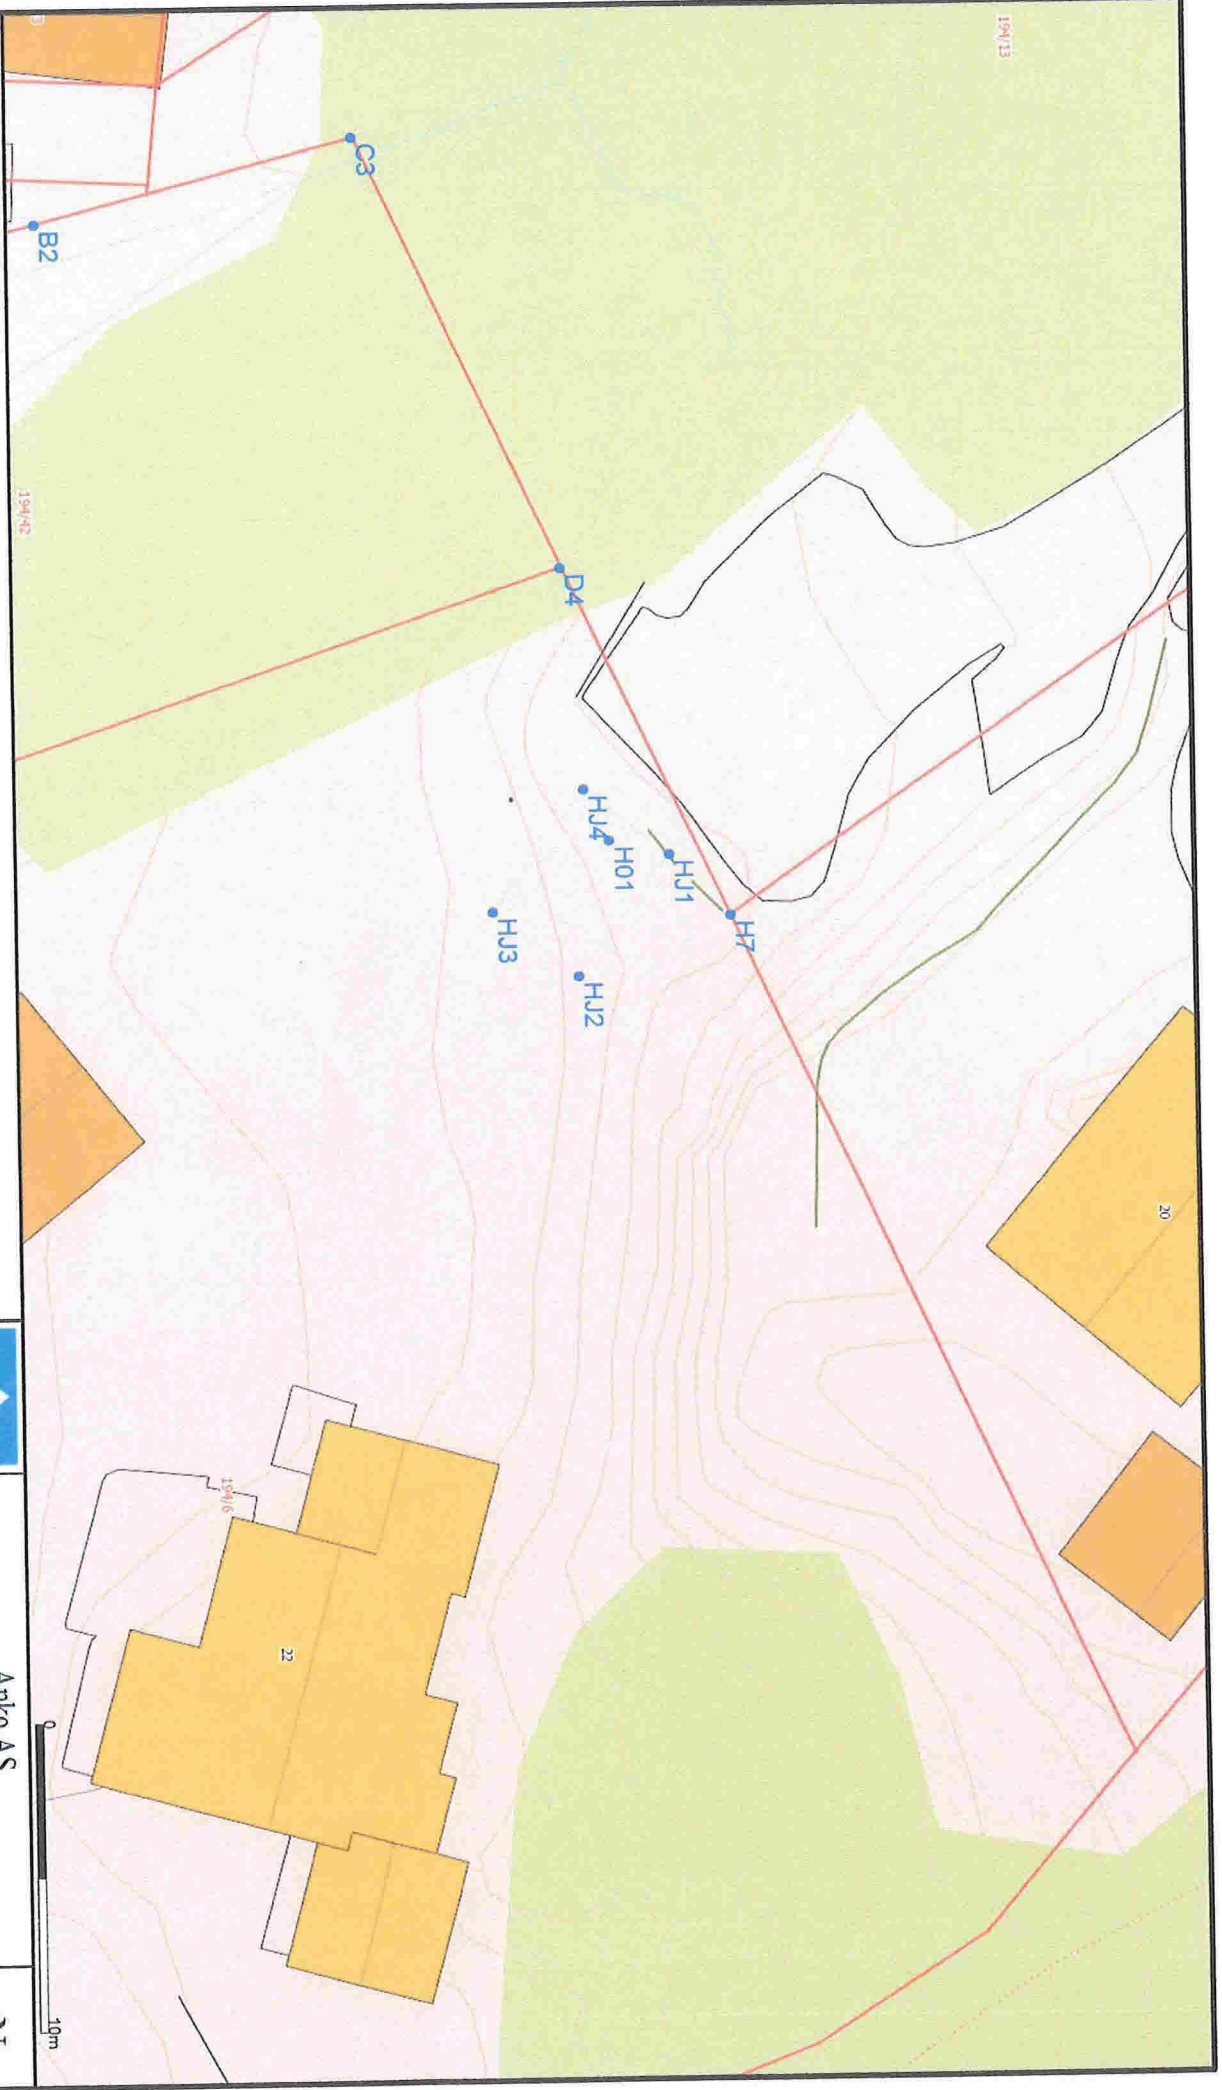

Anko AS - Bergen
 Fjøsangerveien 50C - 5055 Bergen
 55387870 / www.anko.no




Dato: 2014.06.19
 sign: moj



Anko AS
 Bergen



Målestokk
 1:250

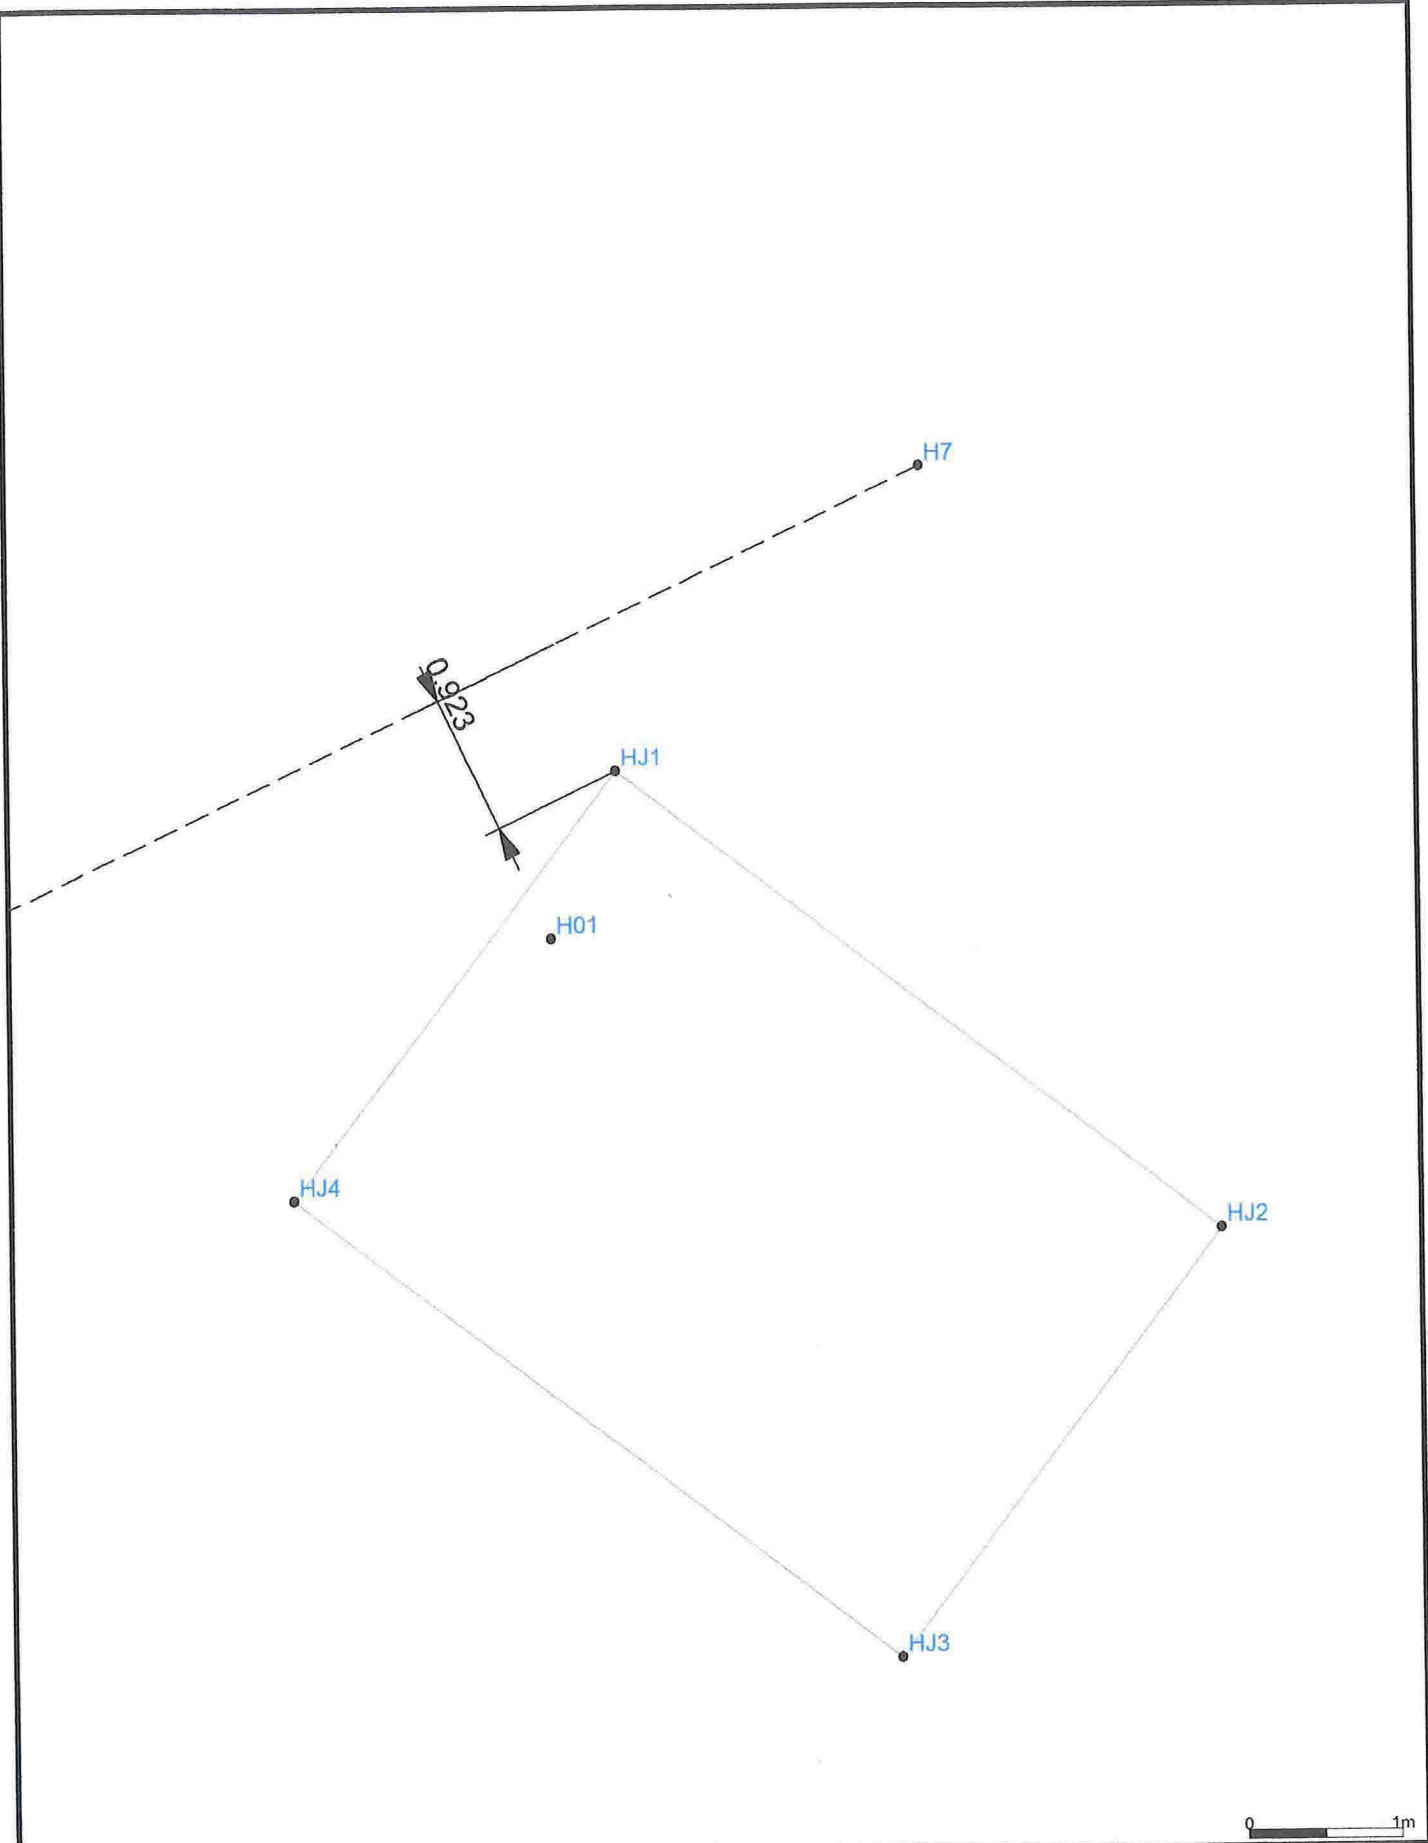10m



<p>Anko AS - Bergen Fjøsangerveien 50C - 5059 Bergen 55387870 / www.anko.no</p>	 <p>ANKO ANSVAR OG KOMPETANSE</p>	<p>Anko AS Bergen</p>	 <p>Målestokk 1:50</p>
<p>Dato: 2014.06.19 Sign: moj</p>			