
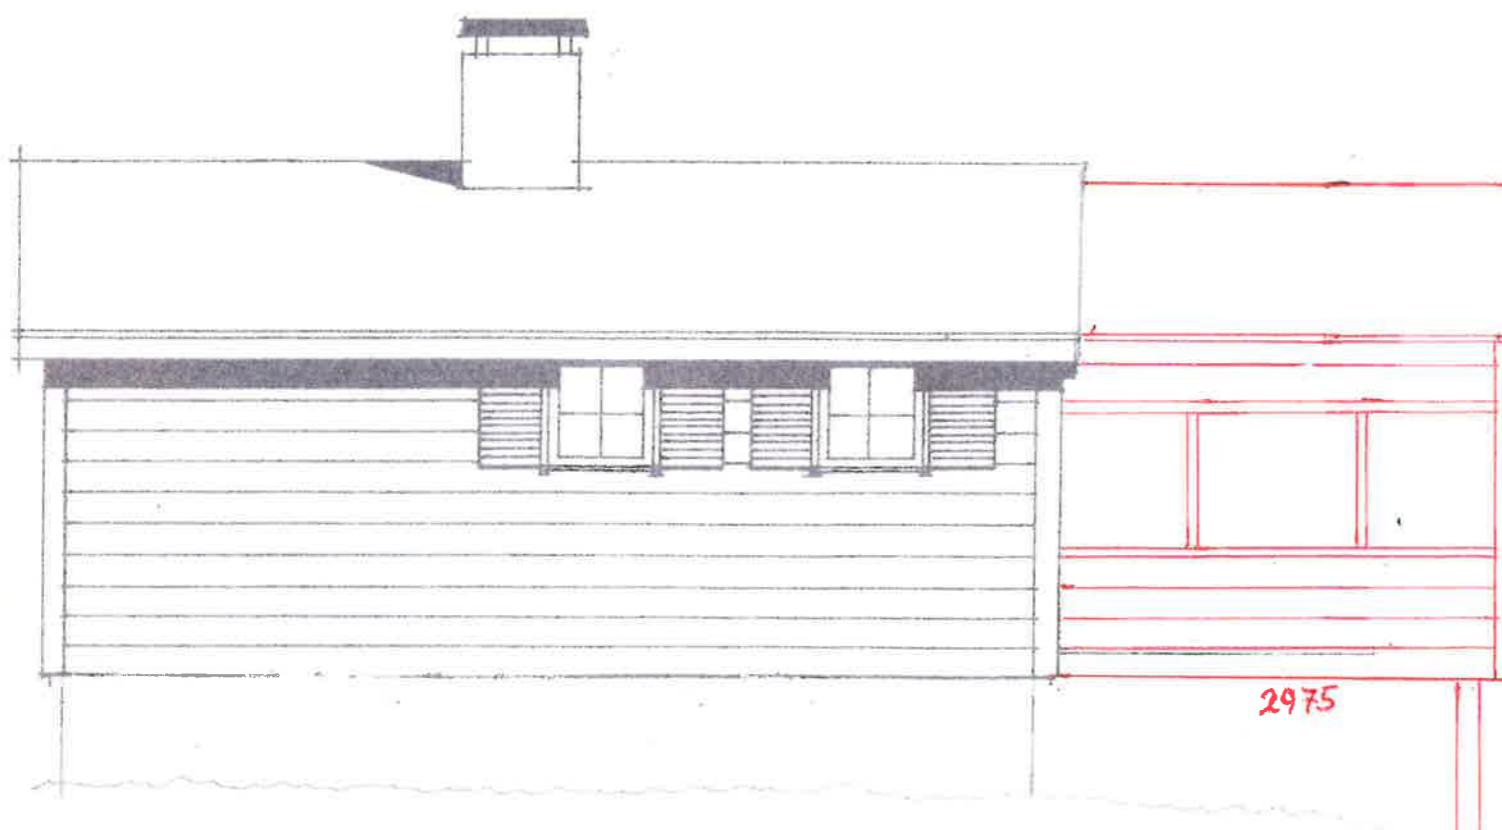
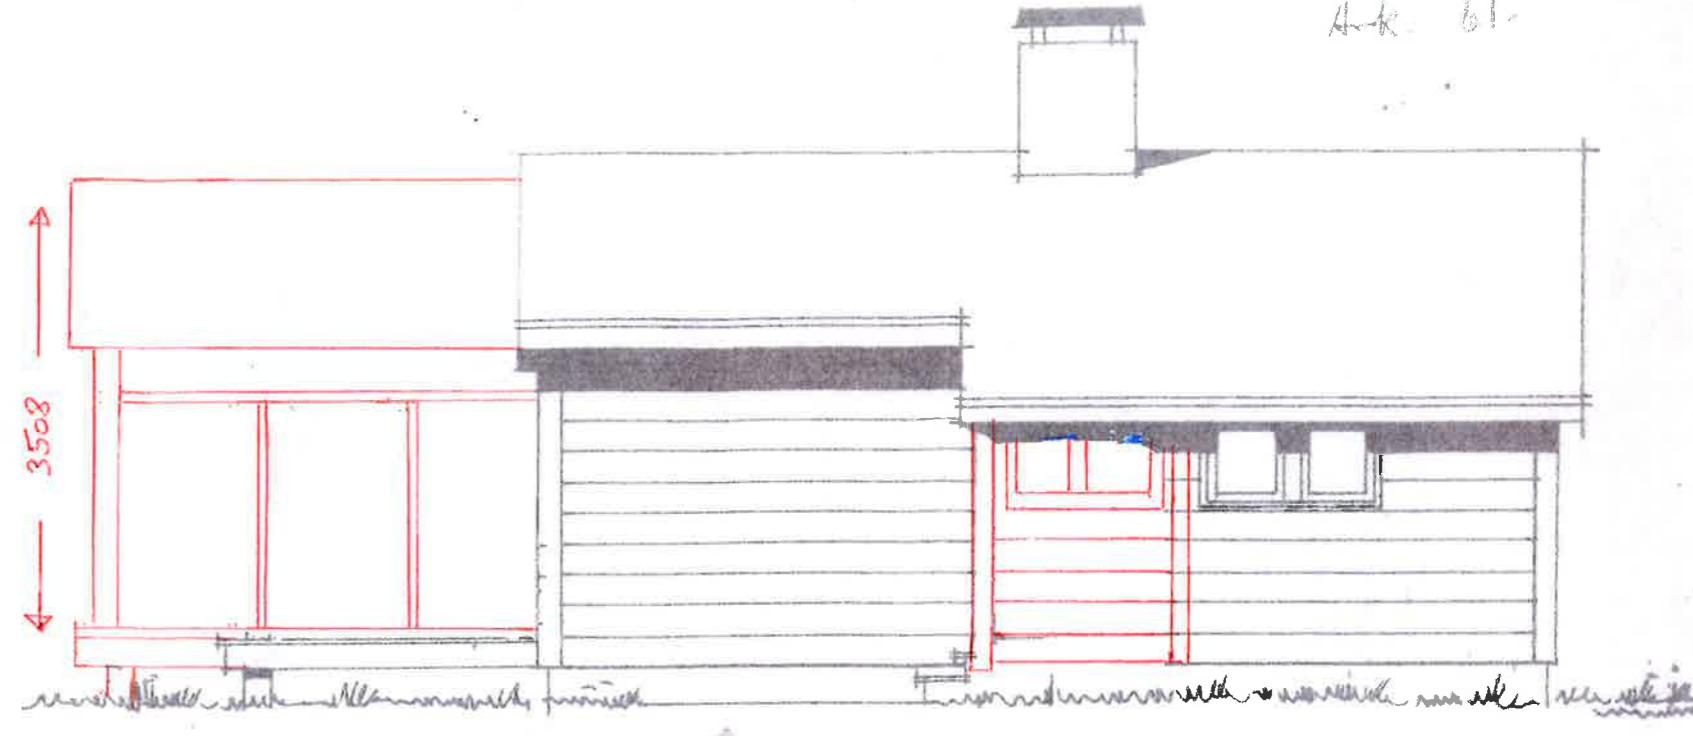


1057-255.74

Ark. 61.

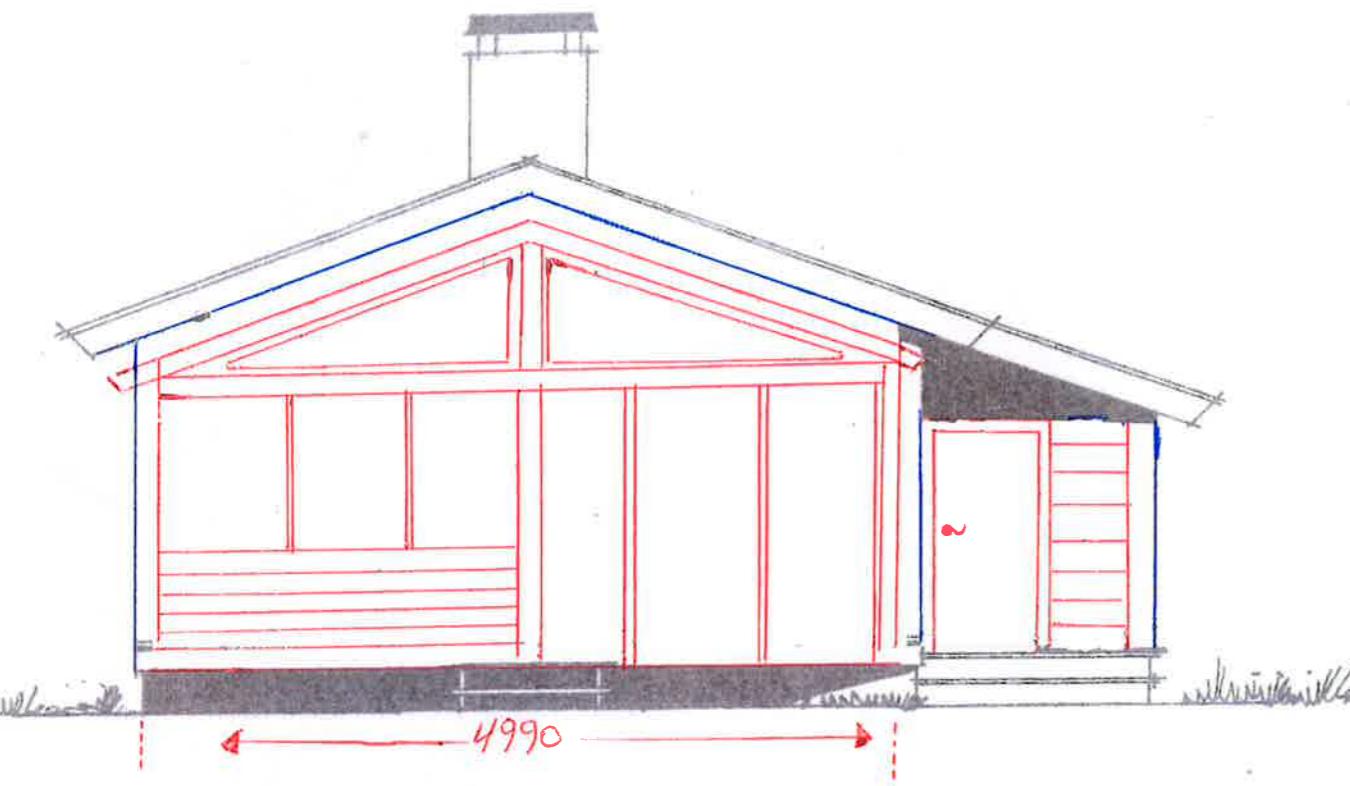

HYTTE 32s
fasader m= 1:50