


Savlo

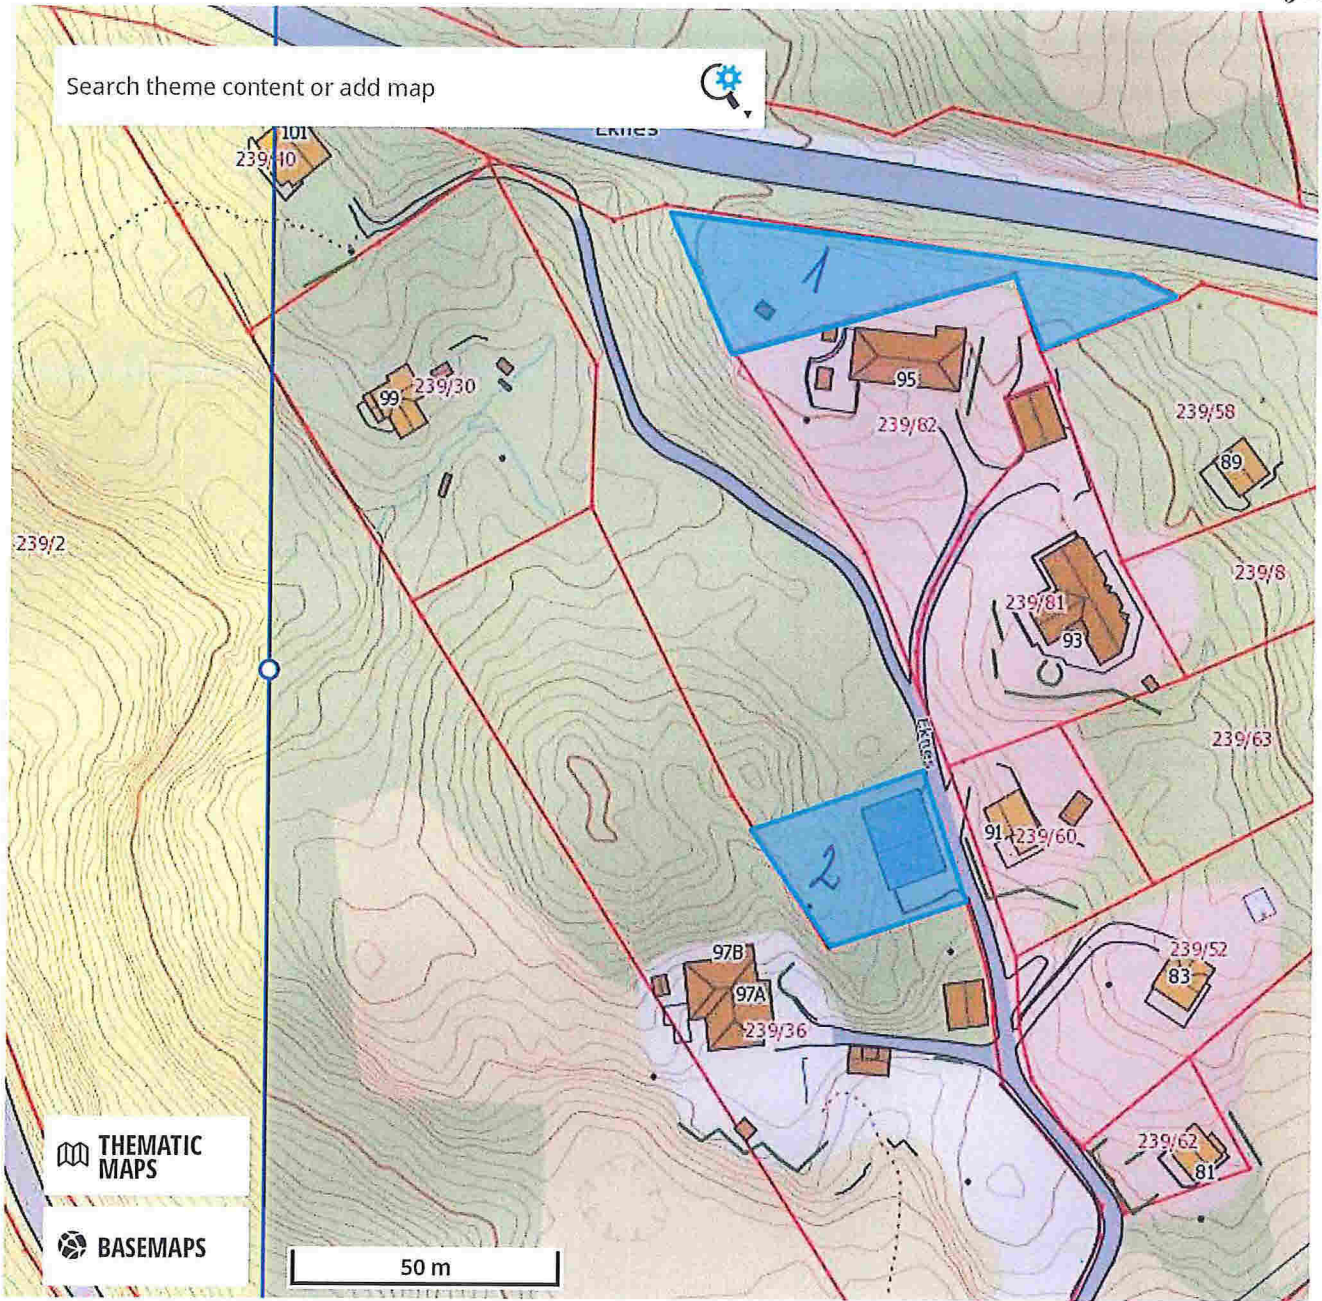

- 1. Parsell 1
- 2. Parsell 2.

Vedlegg ~~A1~~ 1-1