





Lindås, gnr 107 bnr 3,
Data frå utstikking

10.04.2014

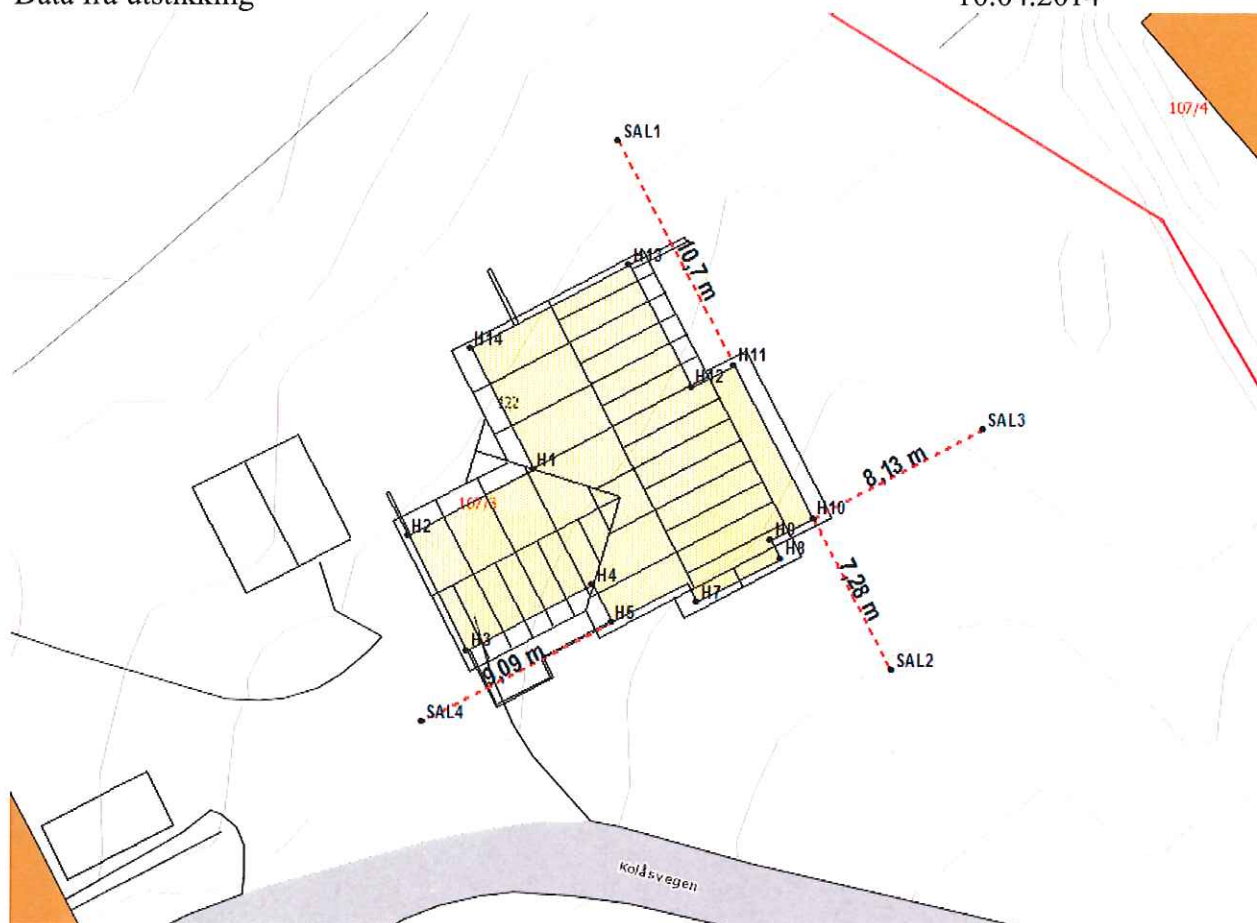

| PunktID | N-koord. | Ø-koord. | Høyde | Merka |
|---------|------------|------------|---------|--------------|
| H1 | 6740856,47 | 290411,678 | 135,18 | Spray |
| H2 | 6740853,69 | 290406,368 | 136,919 | Spray |
| H3 | 6740848,82 | 290408,911 | 136,44 | Spray |
| H4 | 6740851,59 | 290414,224 | 135,705 | Spray |
| H5 | 6740850 | 290415,063 | 135,451 | Pæl |
| H7 | 6740850,88 | 290418,679 | 134,918 | Spray |
| H8 | 6740852,71 | 290422,217 | 134,843 | Spray |
| H9 | 6740853,51 | 290421,791 | 135,008 | Spray |
| H10 | 6740854,44 | 290423,573 | 134,967 | Pæl |
| H11 | 6740860,91 | 290420,193 | 135,193 | Spray |
| H12 | 6740859,98 | 290418,419 | 135,306 | Spray |
| H13 | 6740865,13 | 290415,738 | 135,225 | Spray |
| H14 | 6740861,61 | 290409,006 | 135,32 | Spray |
| SAL1 | 6740870,4 | 290415,249 | 137,302 | Pæl |
| SAL2 | 6740847,98 | 290426,933 | 134,089 | Pæl |
| SAL3 | 6740858,2 | 290430,78 | 135,267 | Pæl |
| SAL4 | 6740845,8 | 290407 | 136,171 | Asfaltspiker |

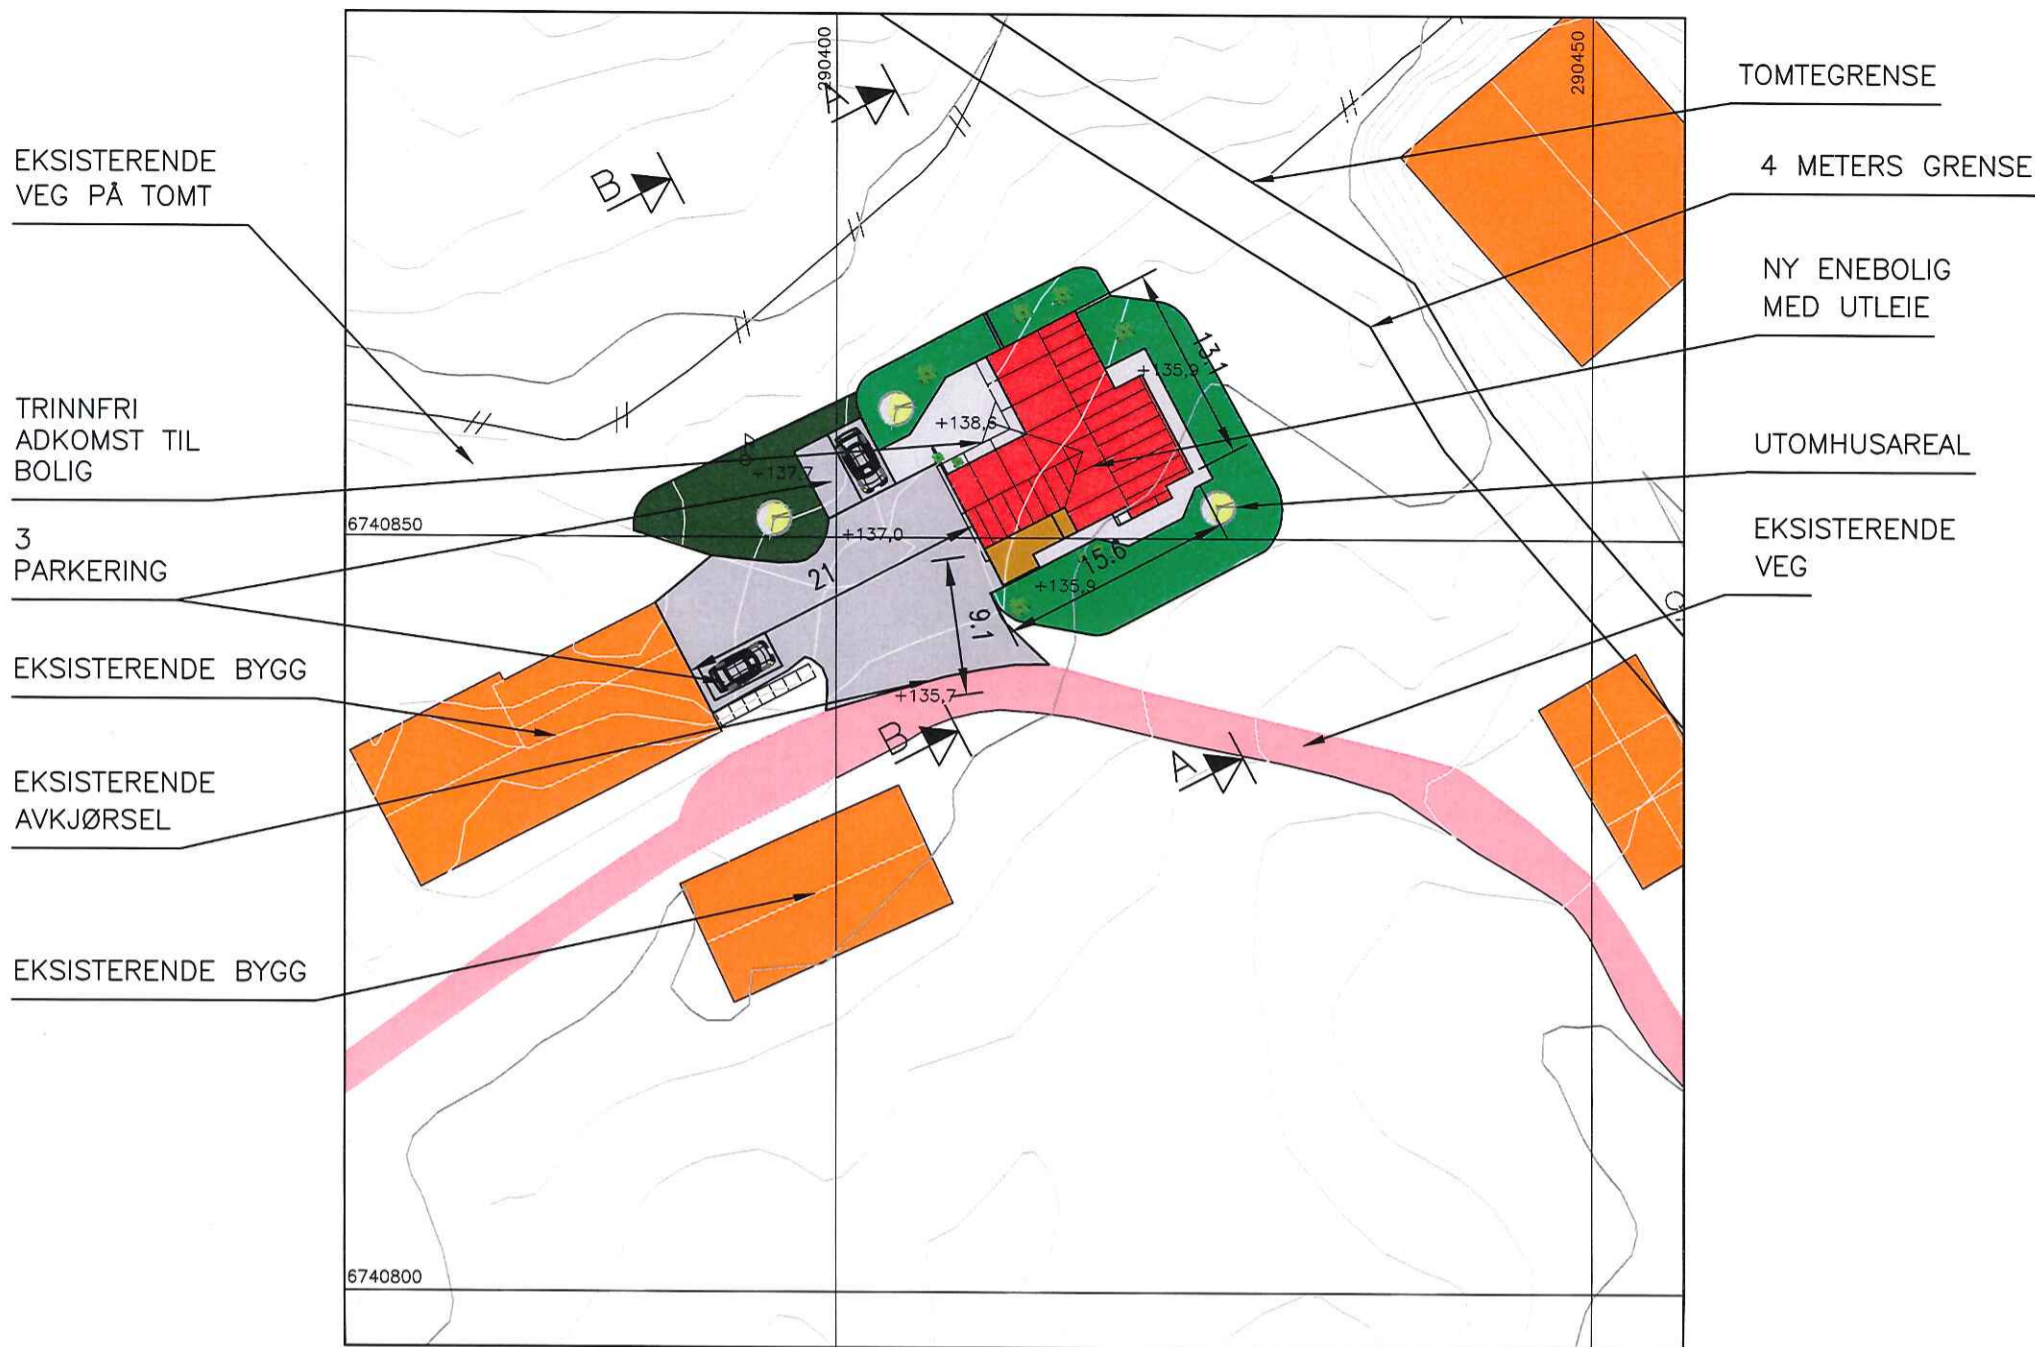


SITUASJONSPLAN

GNR.107 BNR.3 , KOLÅS, LINDÅS KOMMUNE

OK GULV: KOTE +136,1

FOR TERRENGSNITT SE TEGNING 18314034A02 OG A03.

| | | | |
|------------------|--|--|------------------|
| DATE/SIGN | NOTE! | ACCORDING TO INTERNATIONAL LAWS, THIS DRAWING IS THE PROPERTY OF ARKOCONSULT AS. THE DRAWING CAN NOT BE USED, MADE PUBLIC OR HANDED OVER TO A THIRD PART WITHOUT OUR WRITTEN CONSENT. ANY INFRINGEMENT WILL LEAD TO LEGAL PROCEEDINGS. | |
| | <ul style="list-style-type: none"> * PART OF DRAWING MAY NOT BE SHOWN IN SCALE * DO NOT TAKE MEASURES ON DRAWING * ONLY RELAY ON GIVE DIMENSIONS | | |
| REV. DESCRIPTION | OVE KOLÅS, NY ENEBOLIG | REVISION/DATE: | |
| | KOLÅS, 107/3 | PROJECT NO.: 2014034 | |
| | SITUASJONSPLAN | DRAWING NO.: | |
| | | 18314034A01 | |
| REV. DESCRIPTION |  ARKOCONSULT AS, Postboks 103, 5291 Valest.f. Tel.: 56390003 – Fax.: 56191130 – Mob.: 93241511 Mail: post@arkoconsult.no – Org.nr.: 997089782 MVA | SCALE: 1:500 | FORMAT: A3 |
| | | DRAWN: LAH | DATE: 04.02.2014 |
| | | CHECKED: | DATE: |