




.ndås, gnr 172 bnr 189,
Data på innmålt grunnmur

13.10.2017

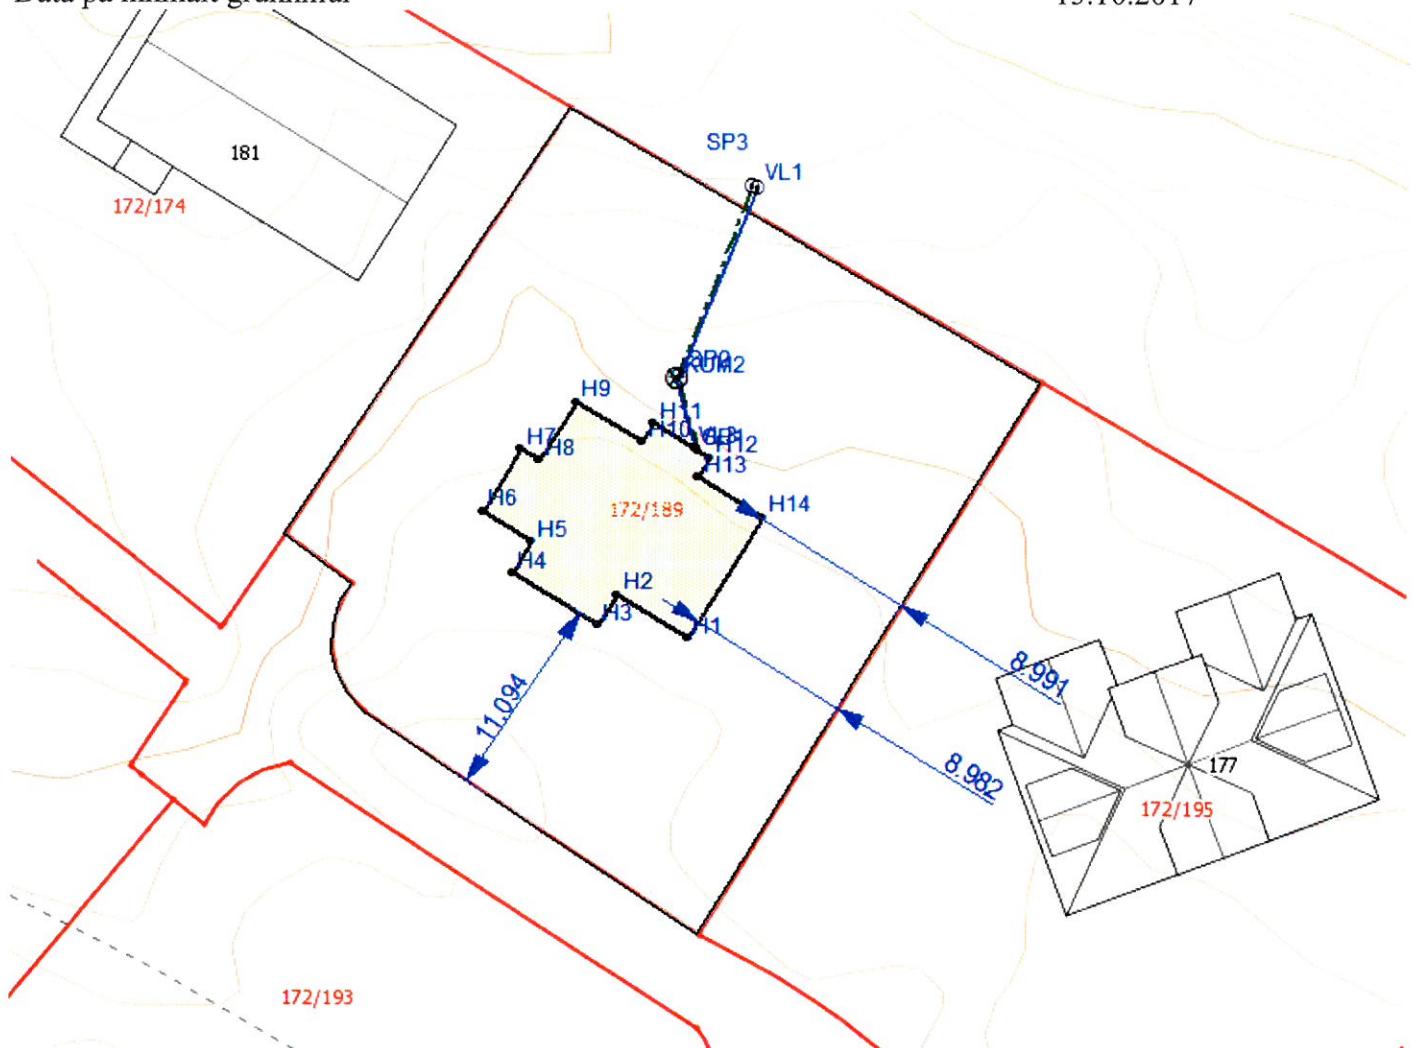

PunktID	N-koord.	Ø-koord.	Høyde
H1	6726163,44	295648,24	16,11
H2	6726165,82	295644,40	16,12
H3	6726164,12	295643,35	16,11
H4	6726167,00	295638,67	
H5	6726168,70	295639,72	
H6	6726170,38	295637,01	16,11
H7	6726173,80	295639,10	16,10
H8	6726173,19	295640,15	16,11
H9	6726176,37	295642,11	16,11
H10	6726174,19	295645,71	16,11
H11	6726175,19	295646,32	16,10
H12	6726173,31	295649,38	16,10
H13	6726172,27	295648,78	16,10
H14	6726170,08	295652,32	16,11