


FRISIKT  
6X45  
UTVIDELSE  
AV EKS.  
AVKJØRSEL

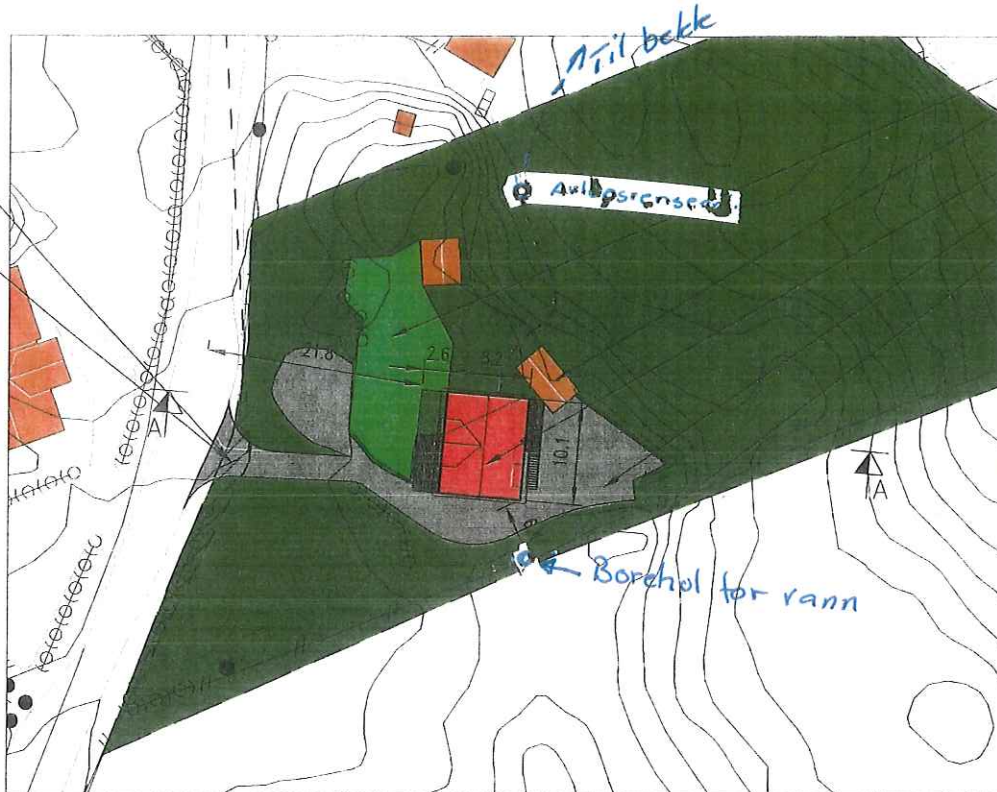

HAGE, CA. 180 M<sup>2</sup>  
EKS. GARASJE  
NY ENEBOLIG,  
EKSI. ENEBOLIG RIVES  
PARKERING M/SNUAREAL  
TOMTEGRENSE

### SITUASJONSPLAN


GNR. 147, BNR. 63, SELLEVOLD, LINDÅS KOMMUNE

OK GULV KJELLERPLAN LIK EKSISTERENDE BOLIG  
CA. +55,0

TERRENGPROFILER SE TEGN.  
18312120A02

**Hjelmås**  
VVS

*P. Hg 7/2.14*

DATE/SIGN	NOTE! * PART OF DRAWING MAY NOT BE SHOWN IN SCALE * DO NOT TAKE MEASURES ON DRAWING * ONLY RELAY ON GIVE DIMENSIONS	ACCORDING TO INTERNATIONAL LAWS, THIS DRAWING IS THE PROPERTY OF ARKOCONSULT AS THE DRAWING CAN NOT BE USED, MADE PUBLIC OR HANDED OVER TO A THIRD PART WITHOUT OUR WRITTEN CONSENT. ANY INFRINGEMENT WILL LEAD TO LEGAL PROCEEDINGS.	
REV. DESCRIPTION	MAILIN OG RUNE HATTEN SELLEVOLL, 147/63, LINDÅS	REVISION/DATE:	
	SITUASJONSPLAN	PROJECT NO.: 2012120	
 ARKOCONSULT AS, Postboks 103, 5291 Volest.f. Tel.: 56390003 - Fax.: 56191130 - Mob.: 93241511 Mail: post@arkoconsult.no - Org.nr.: 997089782 MVA		DRAWING NO.: 18312120A01	
		SCALE: 1:500	FORMAT: A3
		DRAWN: PKI	DATE: 02.09.12
		CHECKED:	DATE: