
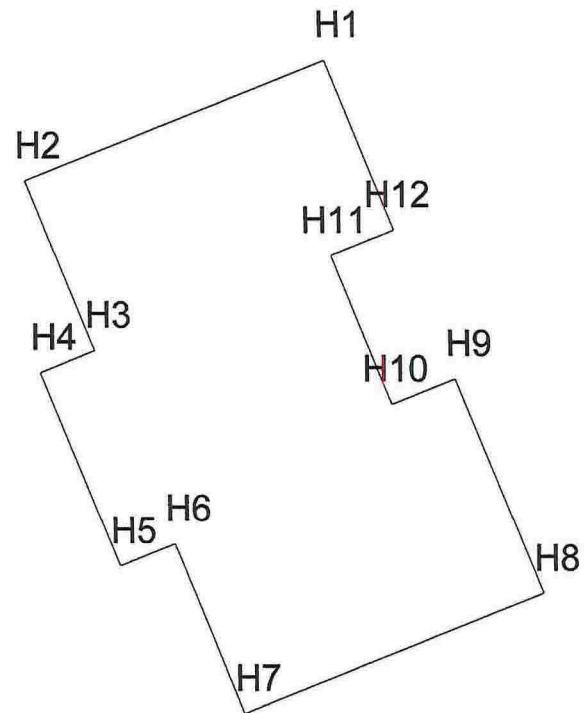
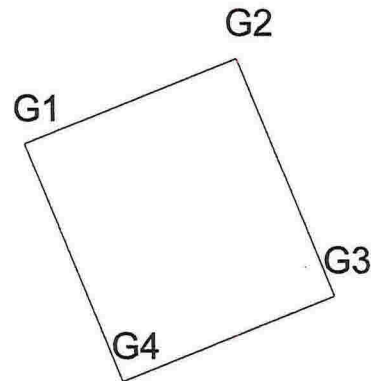


Q 1-1

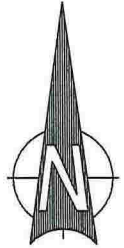

Øst	Nord	S_OBJID	S_FCODE
300473,456	6722758,87	H1	Bygningsmasse
300465,346	6722755,58	H2	
300467,225	6722750,95	H3	
300465,742	6722750,35	H4	
300467,885	6722745,06	H5	
300469,367	6722745,67	H6	
300471,246	6722741,03	H7	
300479,356	6722744,32	H8	
300476,981	6722750,18	H9	
300475,267	6722749,48	H10	
300473,62	6722753,54	H11	
300475,335	6722754,24	H12	
300469,378	6722768,93	G1	
300475,124	6722771,26	G2	
300477,755	6722764,77	G3	
300472,01	6722762,44	G4	

Sasa Misur - Enebolig 202/161				
Dato 21.12.2017	Kontak/Regnet	Godkjent	Målestokk	Northland Grunn og Betong AS Entreprenørforetning
Innmålt bygningsmasse 202/161				Erstatning for: 902
Hensynsregulering:		Beregning:		