


Markert område er tilbygg

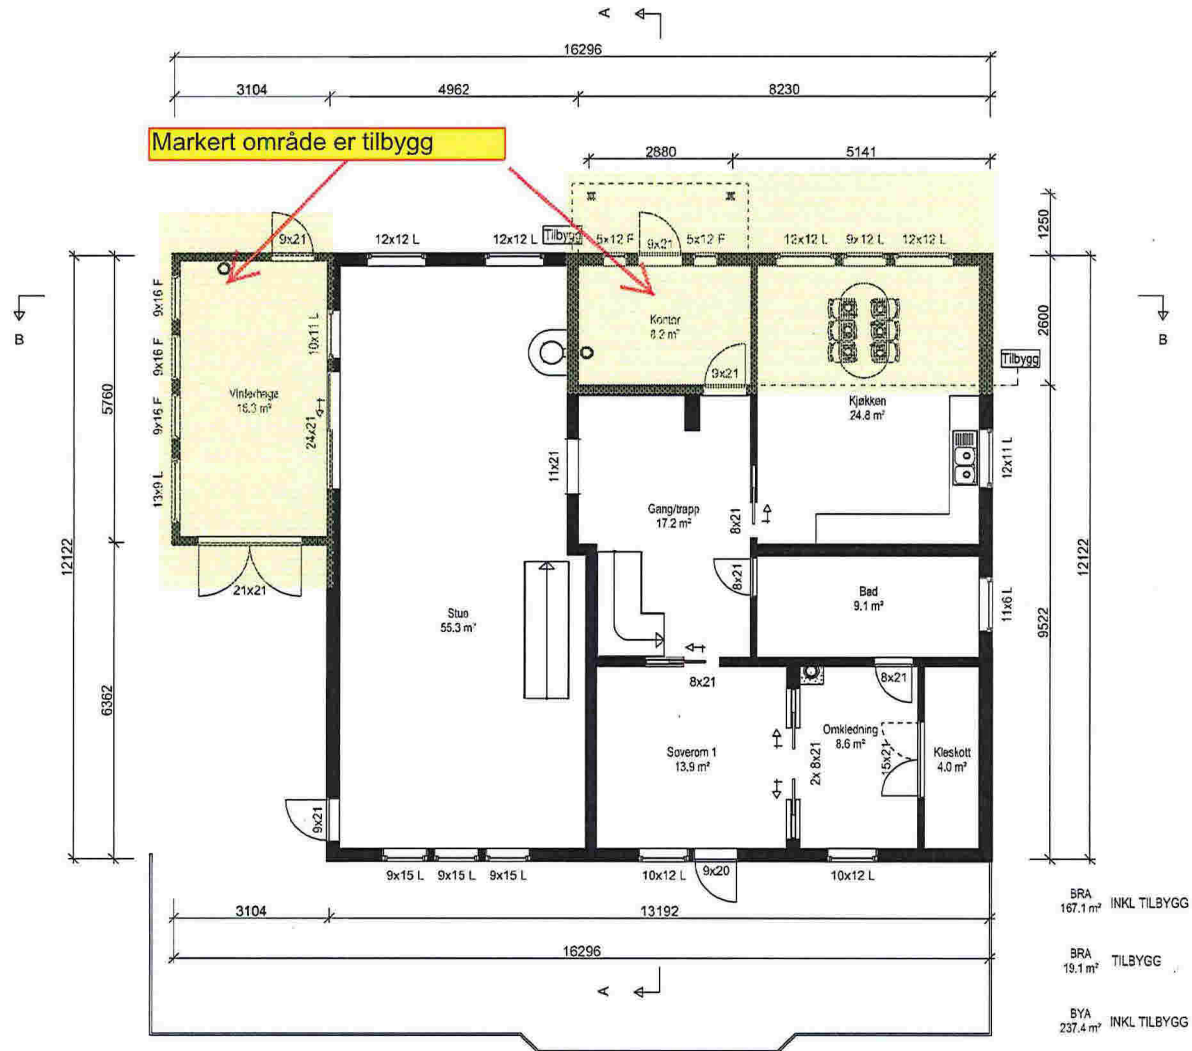

DDS-CAD


Tegningen er beskyttet i.h.t. lov om opphavsrett.

Tiltakshaver: Torleif Johannesen
 Bvigeplass: Vardane 17
 Kommune: Lindås
 Gnr: 134 Bnr: 235 Mal: 1 : 100
 PLAN 1


DATA DESIGN SYSTEM

Dato: 11.11.2017
 Tegnr: _____
 Prosjekt nr.: _____
 Tegnr.: 501


Torleif

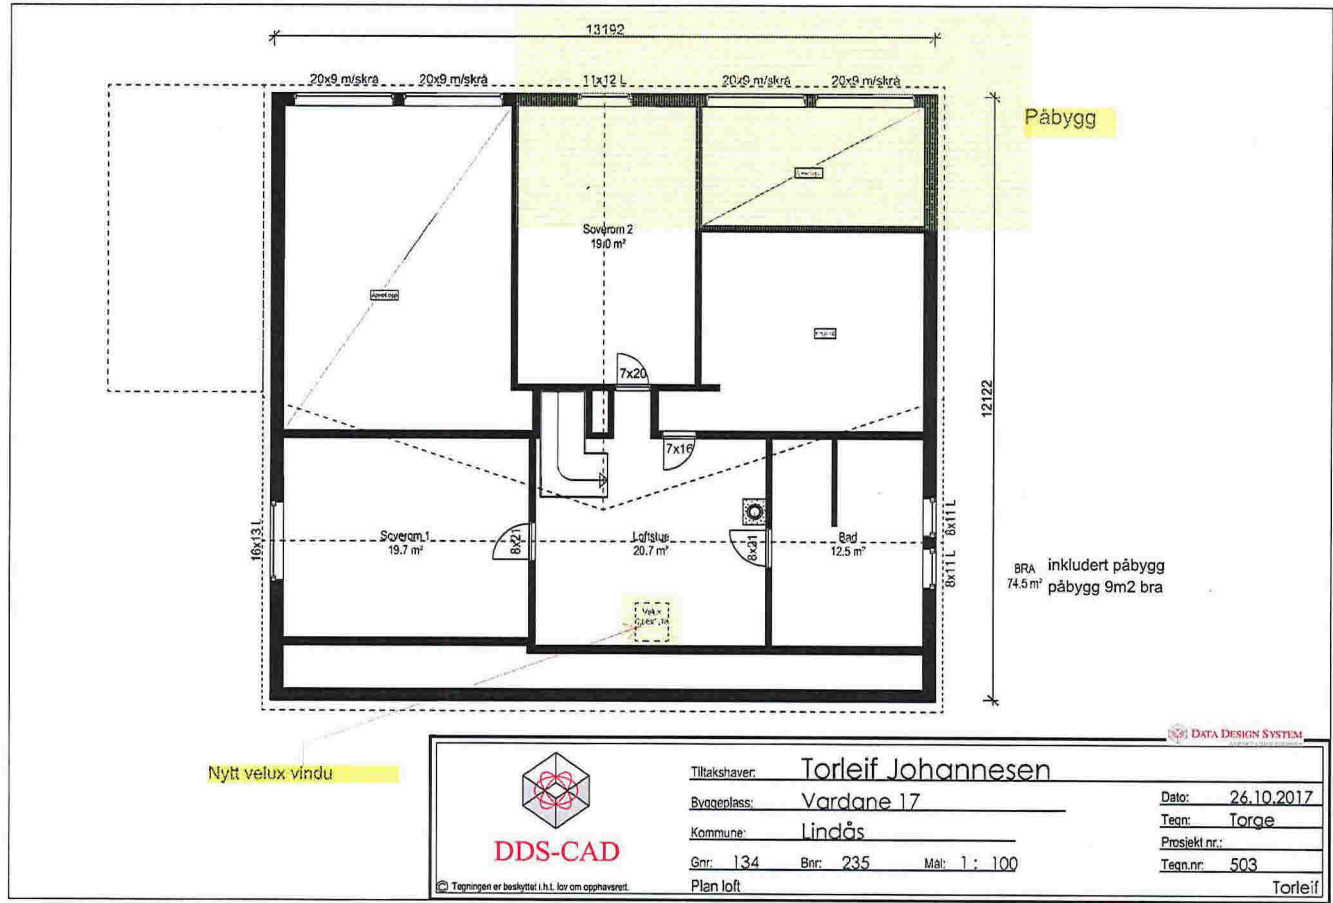

SNITT A-A

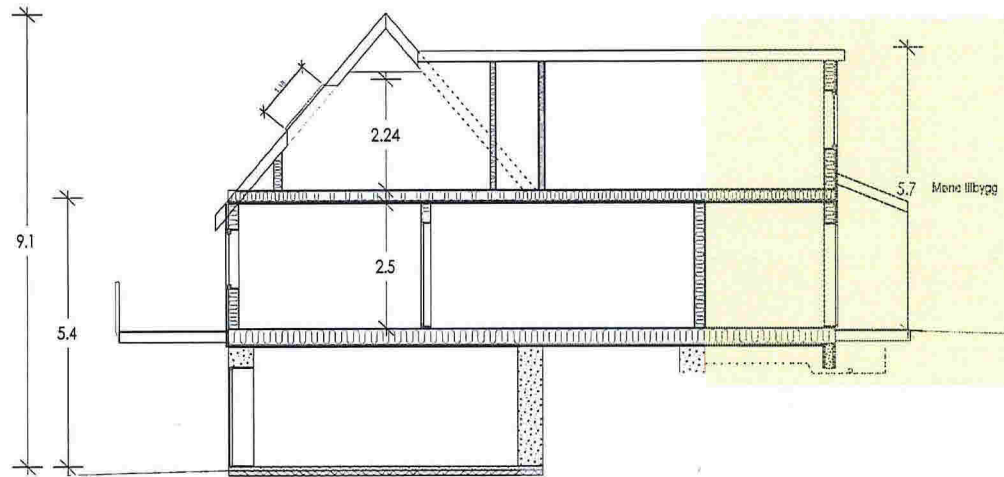

SNITT B-B

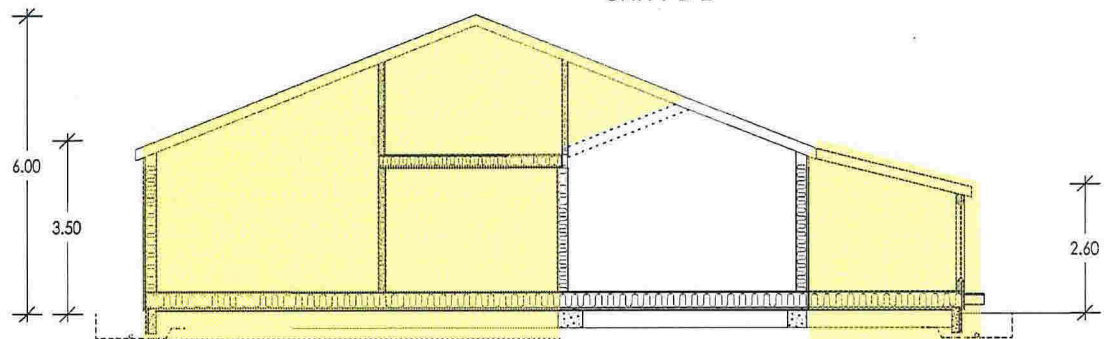

DDS-CAD

© Tegningen er beskyttet i.h.t. lov om opphavsrett.

Tiltakshaver: Torleif Johannesen

Byggeplass: Vardane 17

Kommune: Lindås

Gnr: 134 Bnr: 235 Mal: 1 : 100

SNITT

DATA DESIGN SYSTEM

Dato: 11.11.2017

Tegn: Torge

Prosjekt nr.:

Tegn.nr: 504

Torleif