




Knarvikgarden 95, Gnr. 121 / Bnr. 40

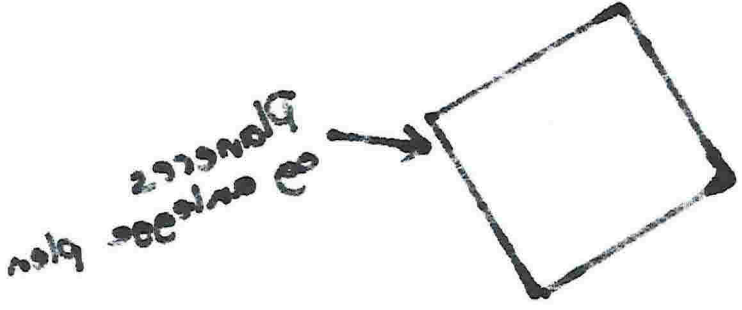

